
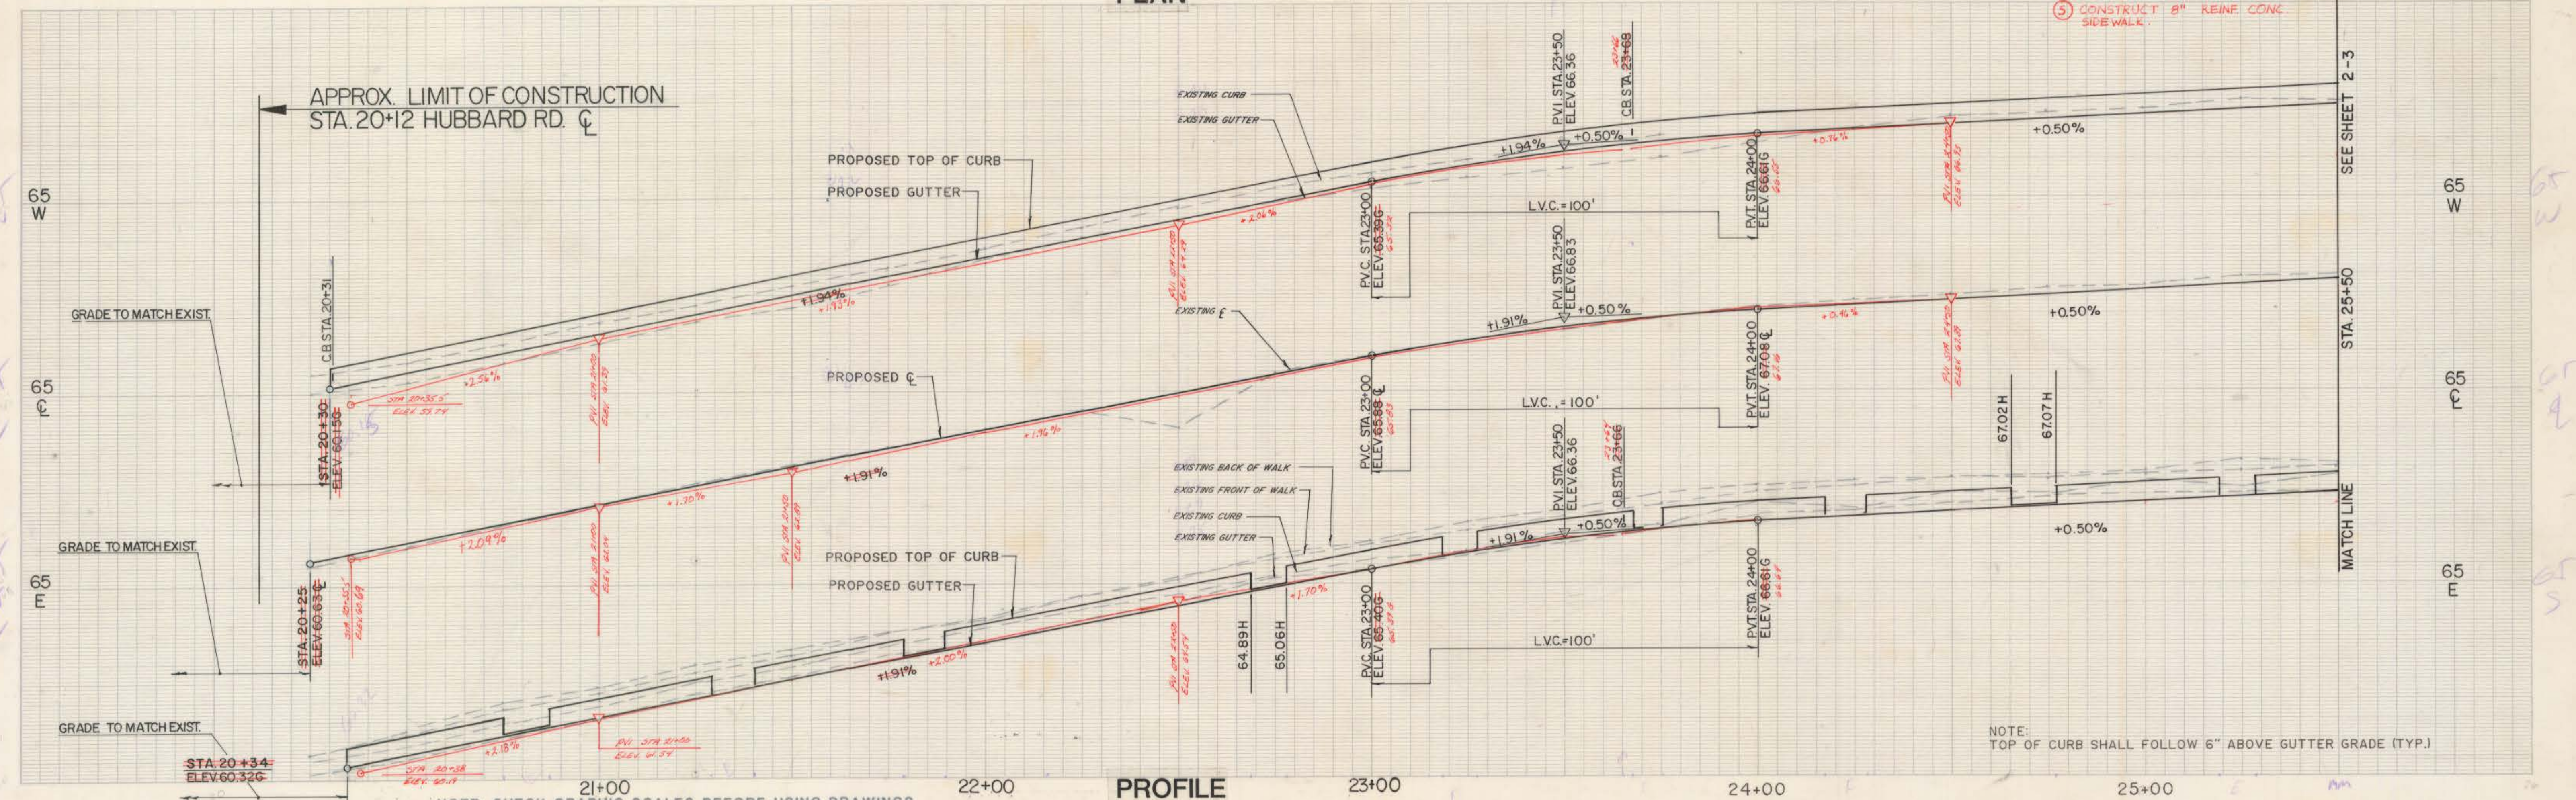


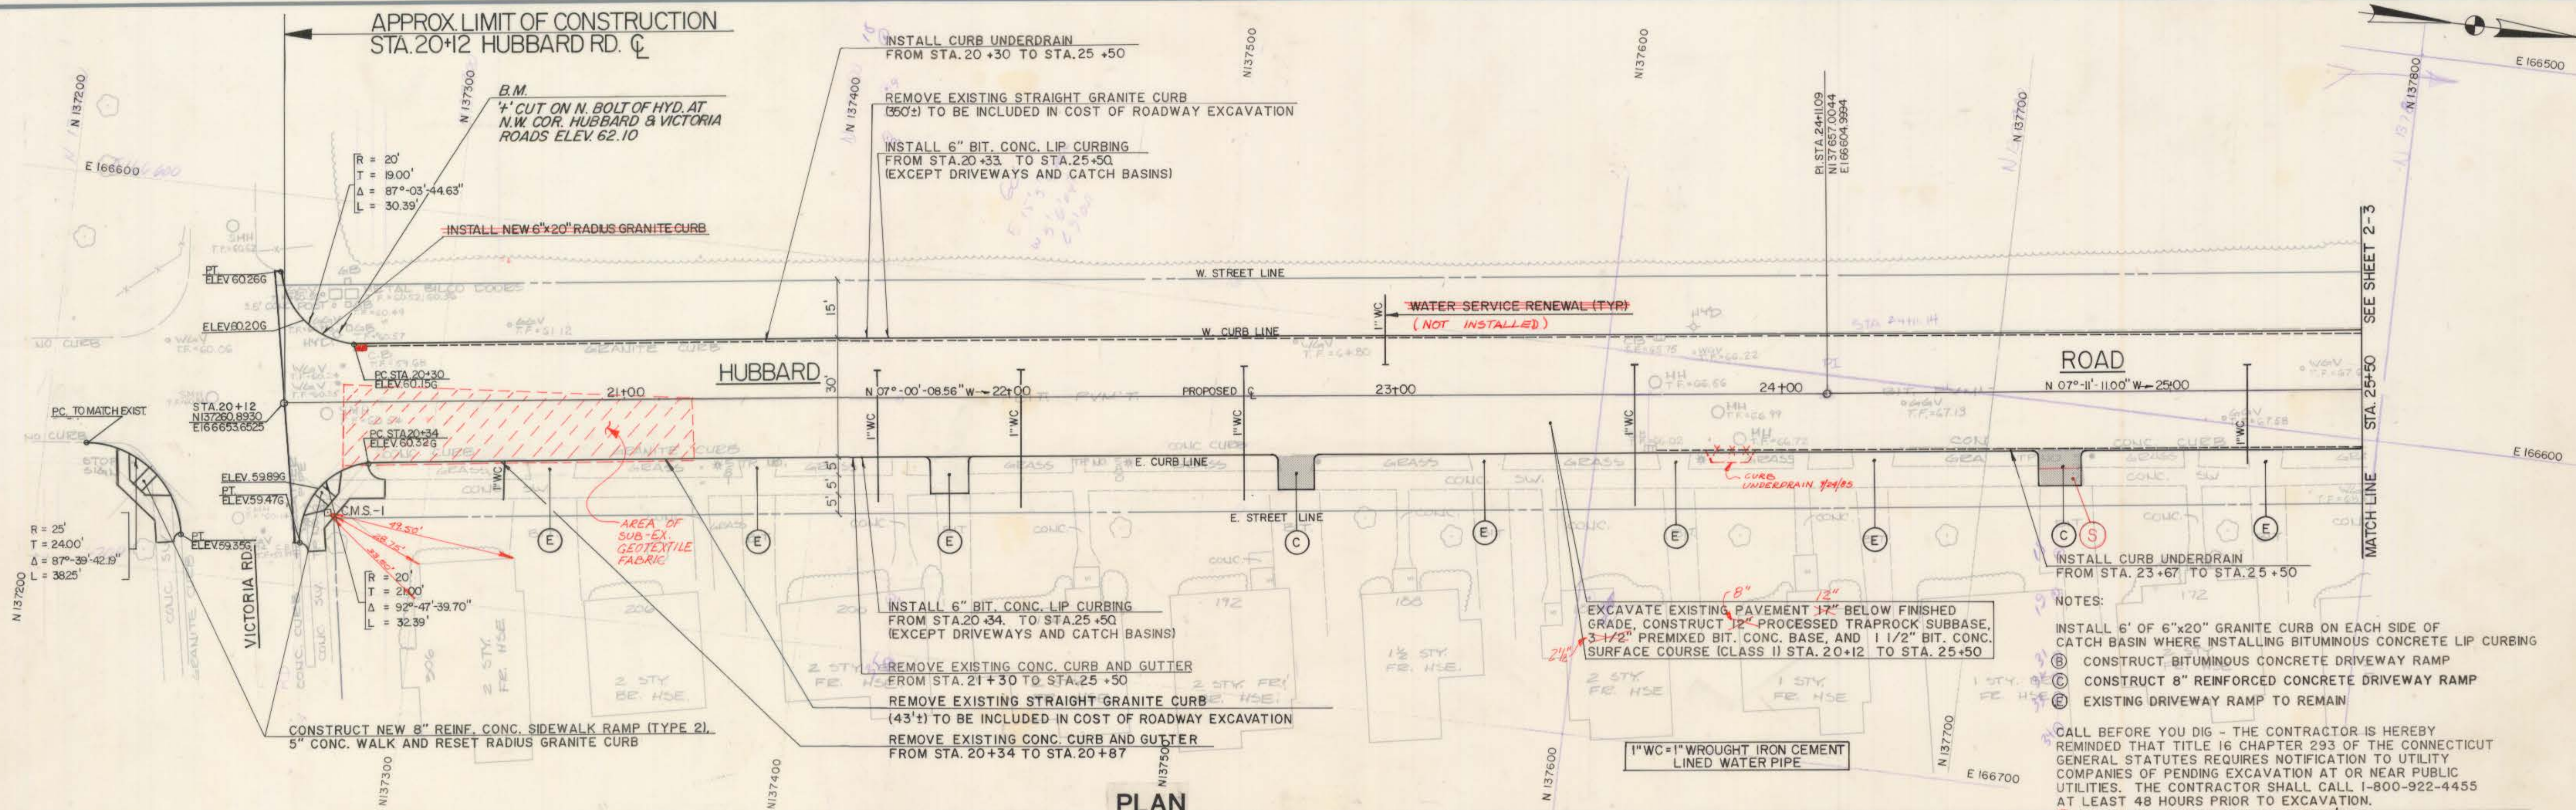

REVISIONS		SUPV APW		GRAPHIC SCALES		ROADWAY RECONSTRUCTION HARTFORD, CONNECTICUT		Hayden Wegman Consulting Engineers		CITY OF HARTFORD, CONNECTICUT DEPARTMENT OF PUBLIC WORKS BUREAU OF ENGINEERING SERVICES		HUBBARD ROAD STA. 20+12 TO STA. 25+50 PLAN AND PROFILE		SHEET 1-3	
NO.	DATE	DESCRIPTION	DESIGN MDH/ACC	HORIZ. 1"=20'	VERT. 1"=2'			WEST HARTFORD NEW YORK • BOSTON • BUFFALO ATLANTA • MEMPHIS		DRAWN CHECKED		SCALE DATE	DAYBOOK NO. 010947	Contract No. E85-28	Job No. 845304
DEC 86		AS BUILT BY R.J.F. CHECKED BY M.C.C.	CHECKED JAC												
			DATE 6/3/85												