
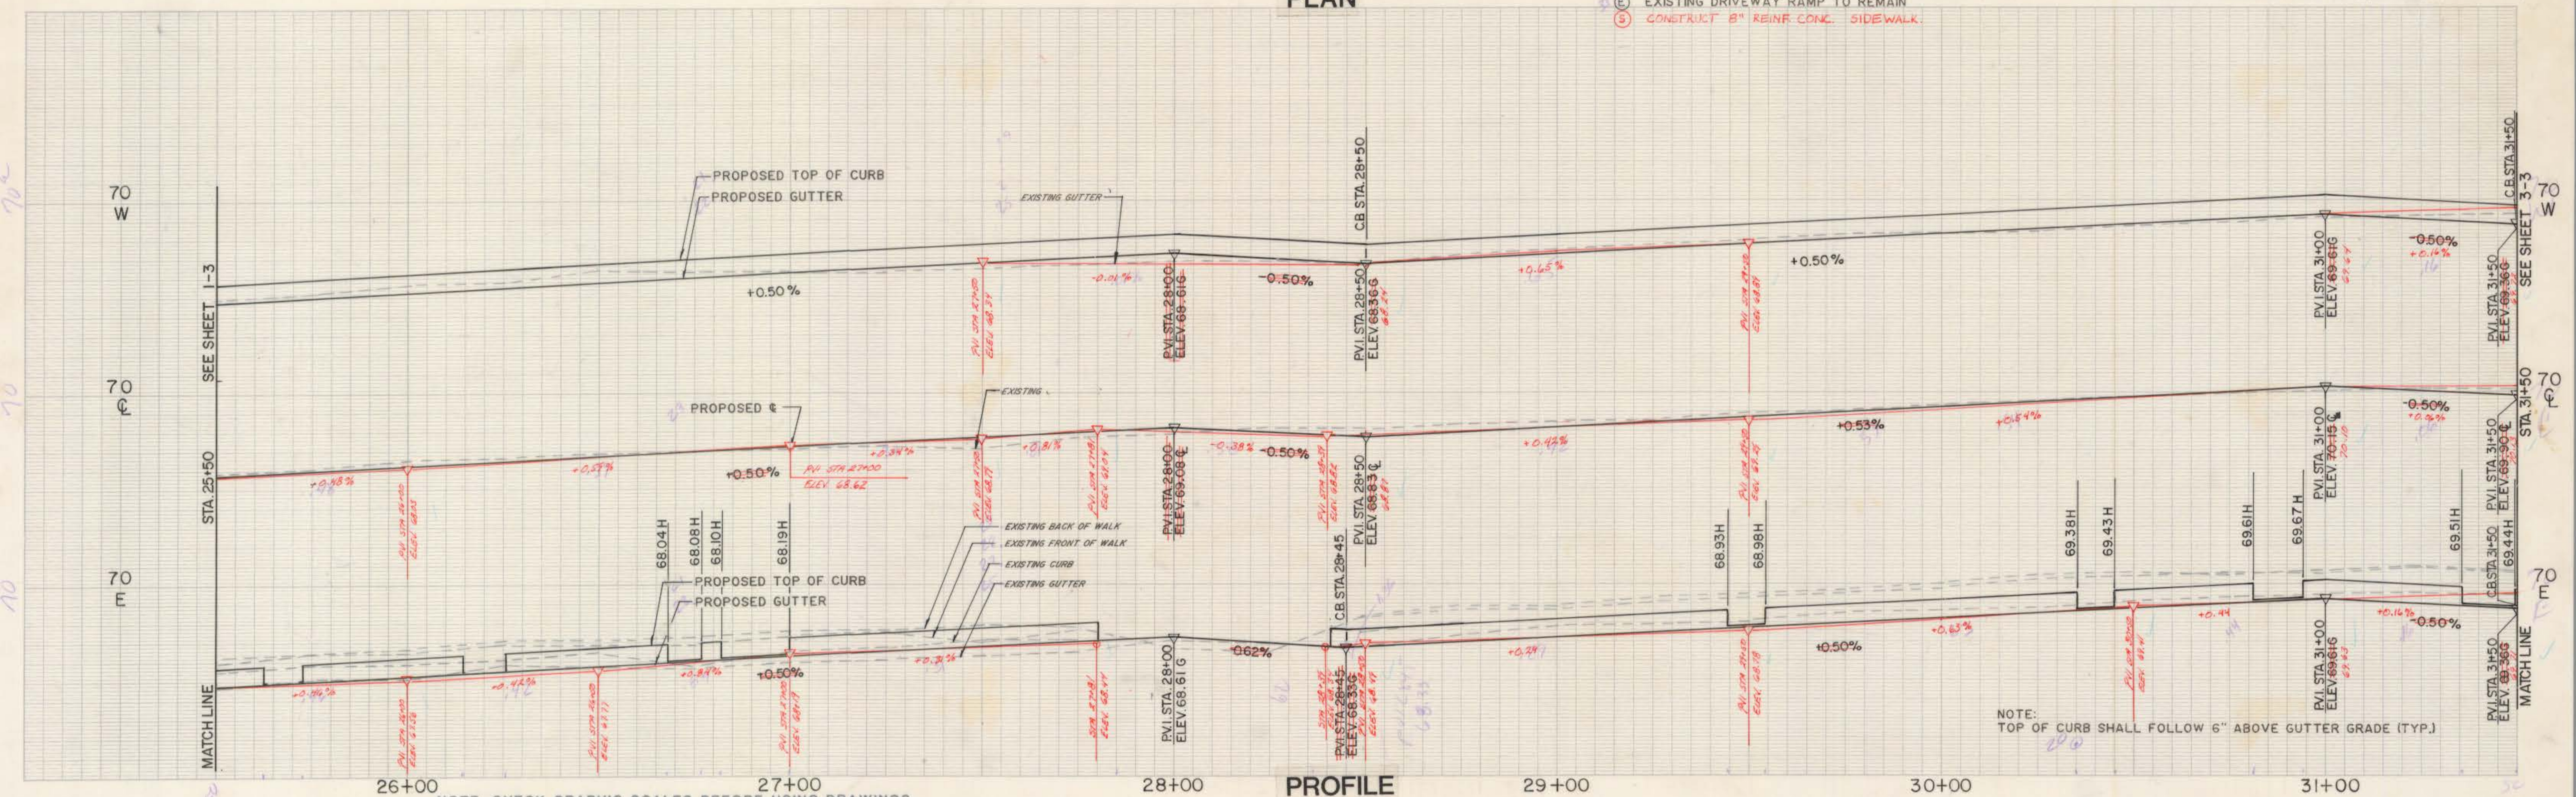


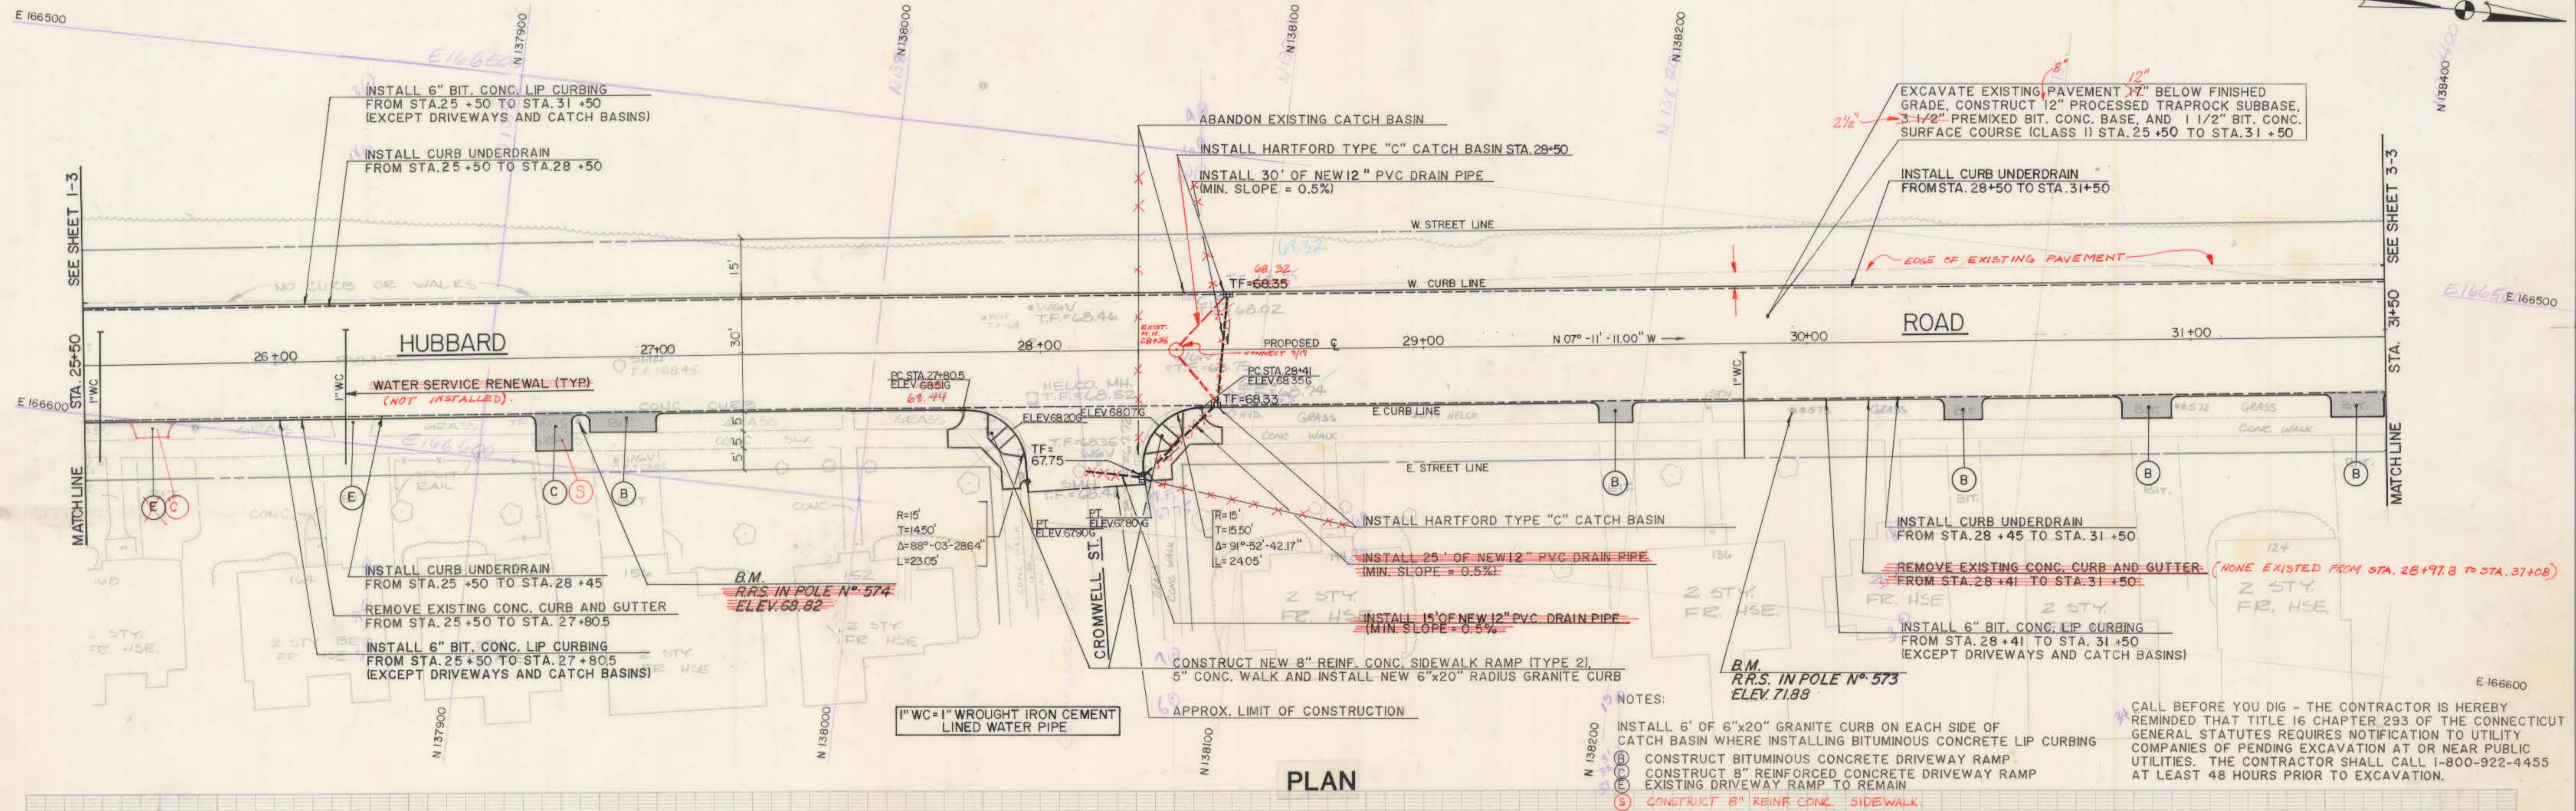

SUPV. ARW DESIGN MDH / AEC DRAWN CS CHECKED JAC DATE 6/3/85		GRAPHIC SCALES HORIZ. 1" = 20' VERT. 1" = 2'	ROADWAY RECONSTRUCTION HARTFORD, CONNECTICUT	CITY OF HARTFORD, CONNECTICUT DEPARTMENT OF PUBLIC WORKS BUREAU OF ENGINEERING SERVICES	HUBBARD ROAD STA. 25+50 TO STA. 31+50 PLAN AND PROFILE	SHEET 2-3
REVISIONS NO. DATE DESCRIPTION		Contract No. E85-28 Job No. 845304				