
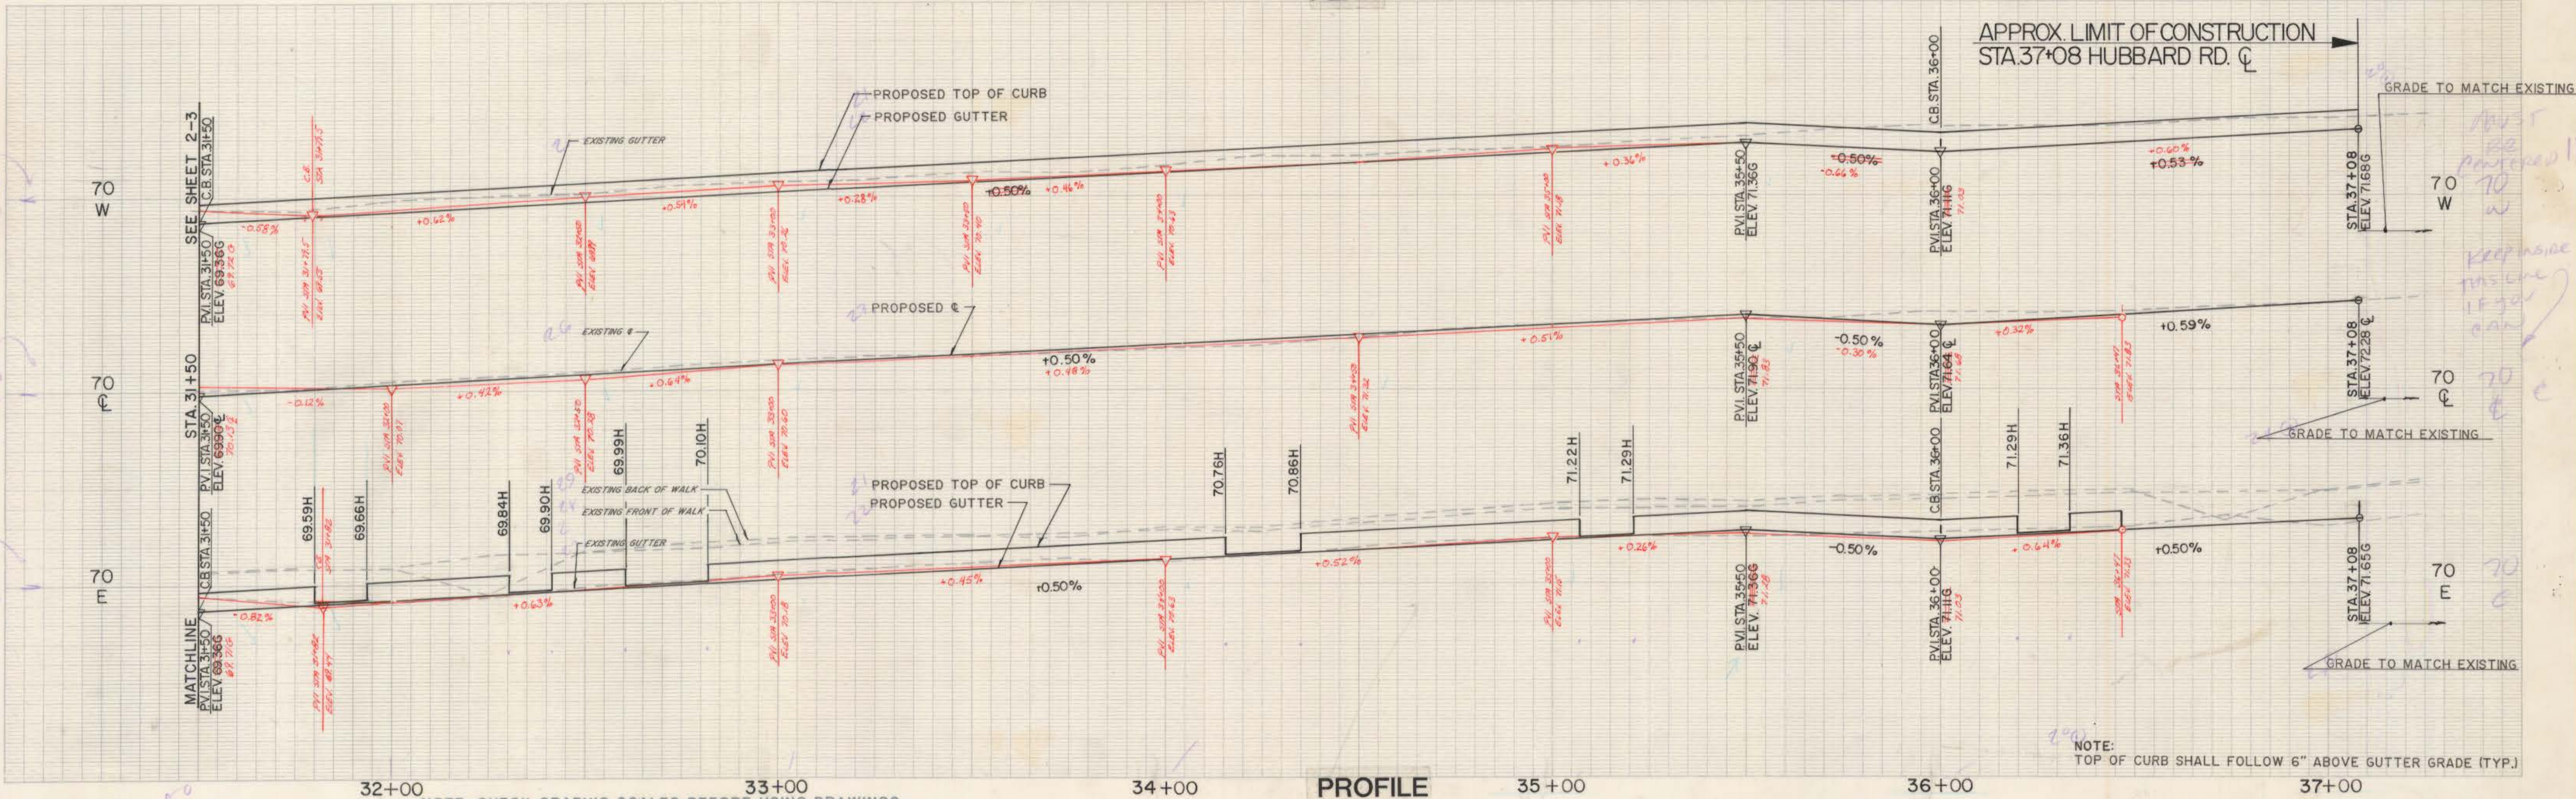


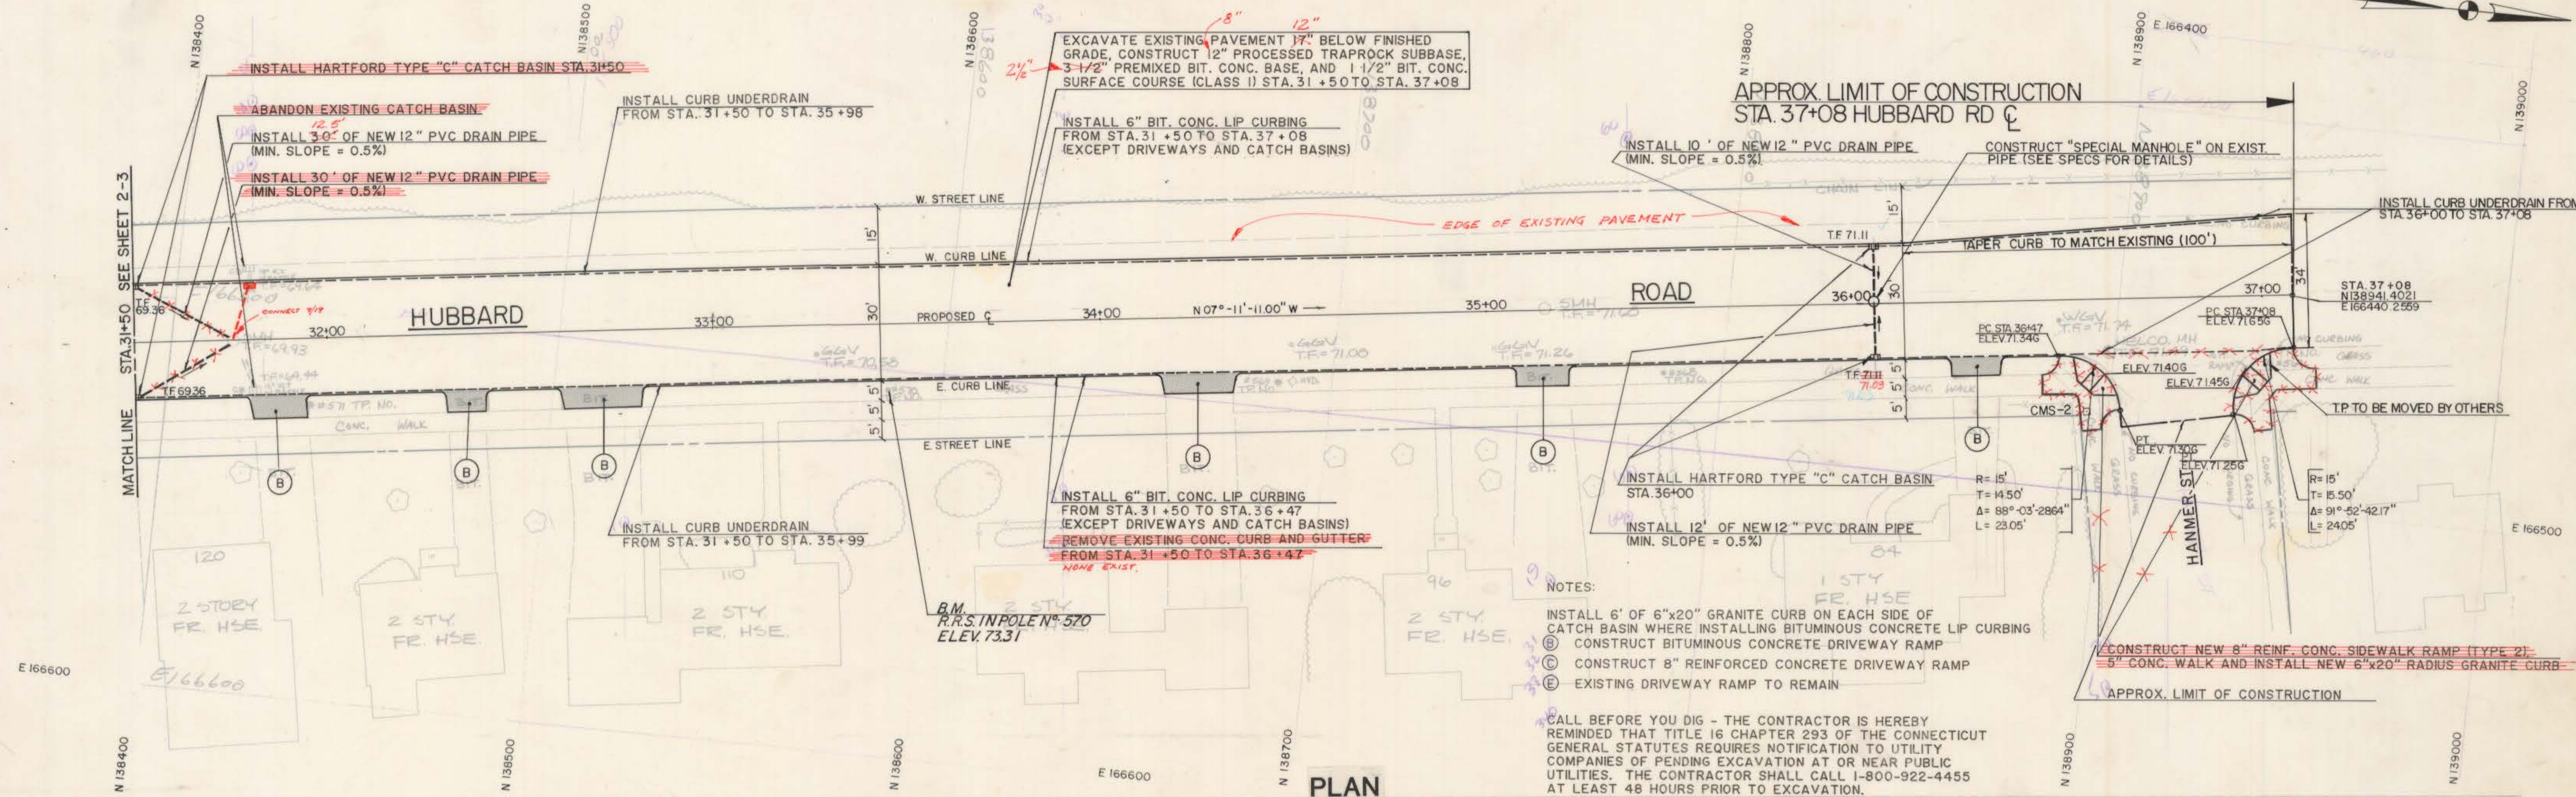

SUPV. <i>ARW</i>		GRAPHIC SCALES		ROADWAY RECONSTRUCTION HARTFORD, CONNECTICUT	Hayden Wegman Consulting Engineers	CITY OF HARTFORD, CONNECTICUT DEPARTMENT OF PUBLIC WORKS BUREAU OF ENGINEERING SERVICES		HUBBARD ROAD	
DESIGN <i>MDH / ACC</i>		HORIZ. 1" = 20' VERT. 1" = 2'				WEST HARTFORD NEW YORK • BOSTON • BUFFALO ATLANTA • MEMPHIS		STA. 31+50 TO STA. 37+08	
DRAWN <i>MDH</i>						SCALE		DAYBOOK NO. 010947	
CHECKED <i>JAC</i>						DRAWN		DATE	
DATE <i>6/3/15</i>						CHECKED		Job No. - 845304	
REVISIONS								SHEET 3-3	