


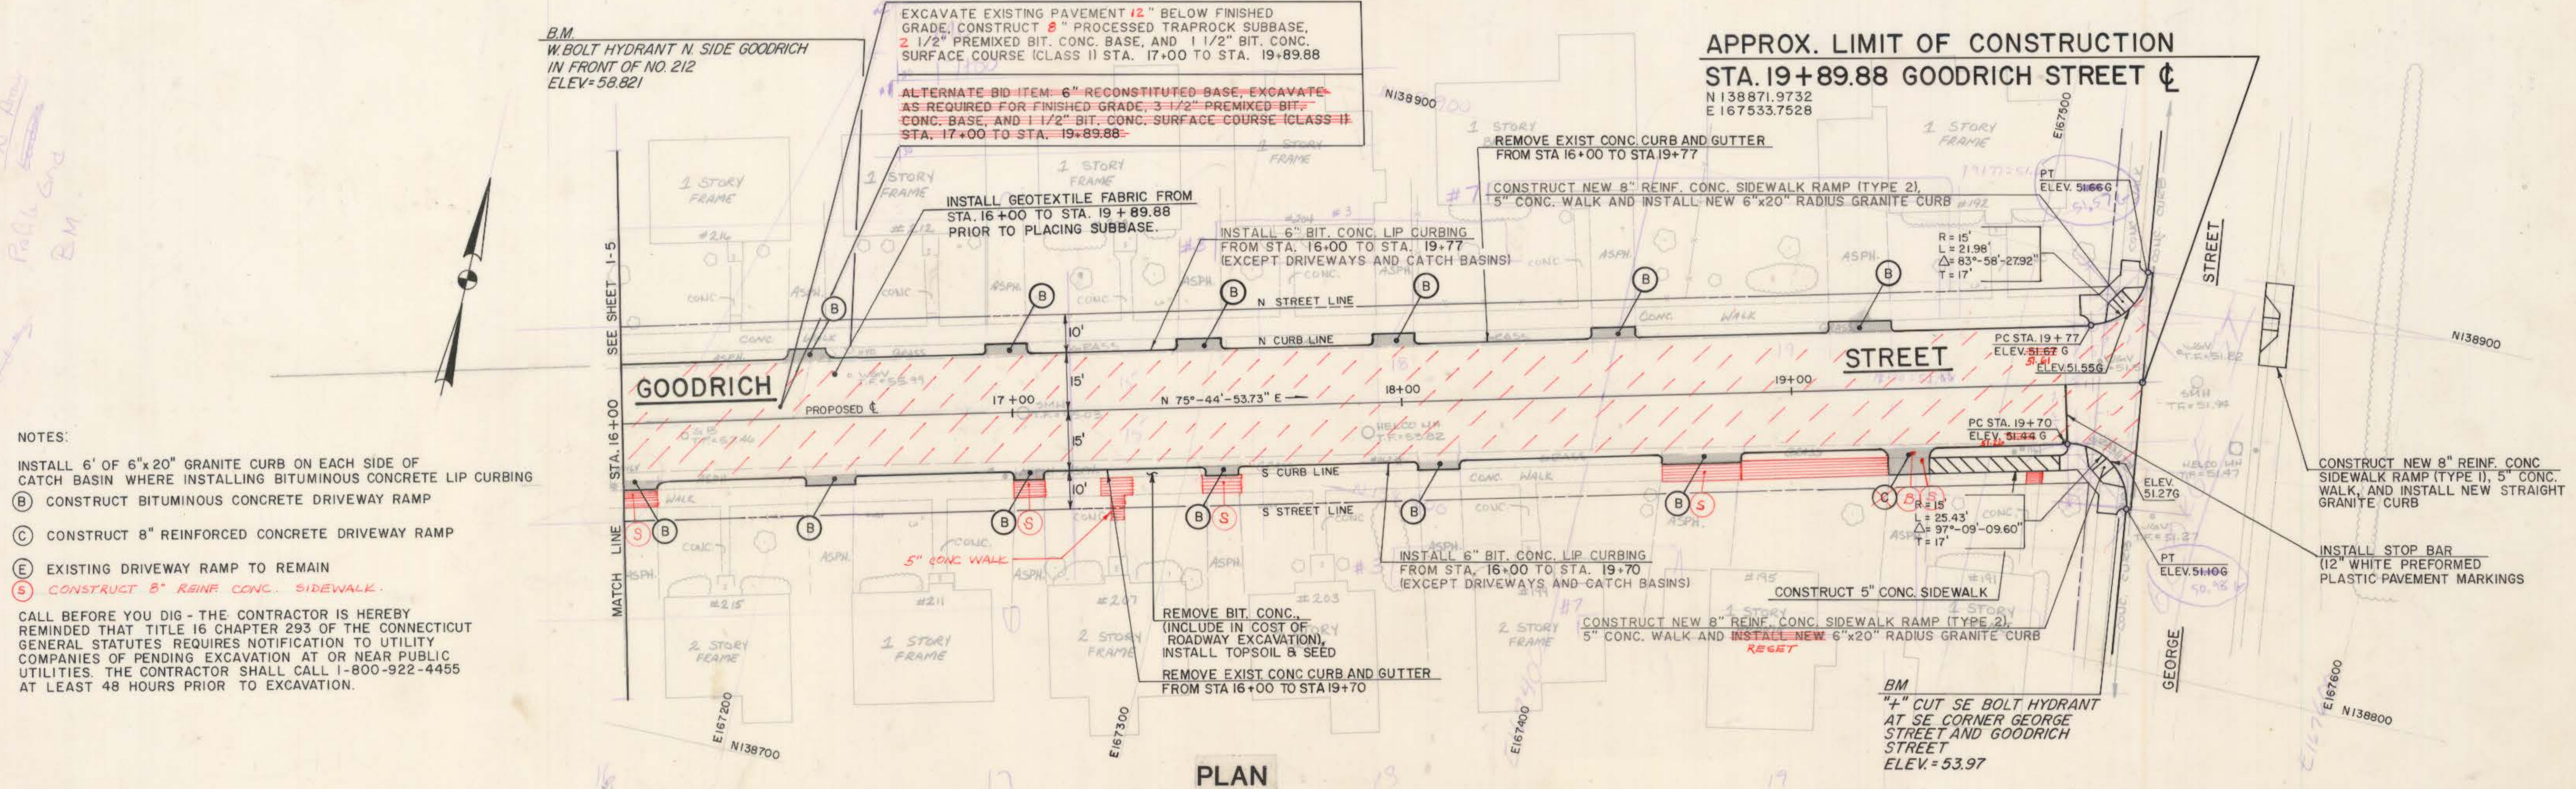

NOTES:

INSTALL 6' OF 6"x20" GRANITE CURB ON EACH SIDE OF CATCH BASIN WHERE INSTALLING BITUMINOUS CONCRETE LIP CURBING

(B) CONSTRUCT BITUMINOUS CONCRETE DRIVEWAY RAMP


(C) CONSTRUCT 8" REINFORCED CONCRETE DRIVEWAY RAMP

(E) EXISTING DRIVEWAY RAMP TO REMAIN

(S) CONSTRUCT 8" REINF. CONC. SIDEWALK

CALL BEFORE YOU DIG - THE CONTRACTOR IS HEREBY REMINDED THAT TITLE 16 CHAPTER 293 OF THE CONNECTICUT GENERAL STATUTES REQUIRES NOTIFICATION TO UTILITY COMPANIES OF PENDING EXCAVATION AT OR NEAR PUBLIC UTILITIES. THE CONTRACTOR SHALL CALL 1-800-922-4455 AT LEAST 48 HOURS PRIOR TO EXCAVATION.

PLAN

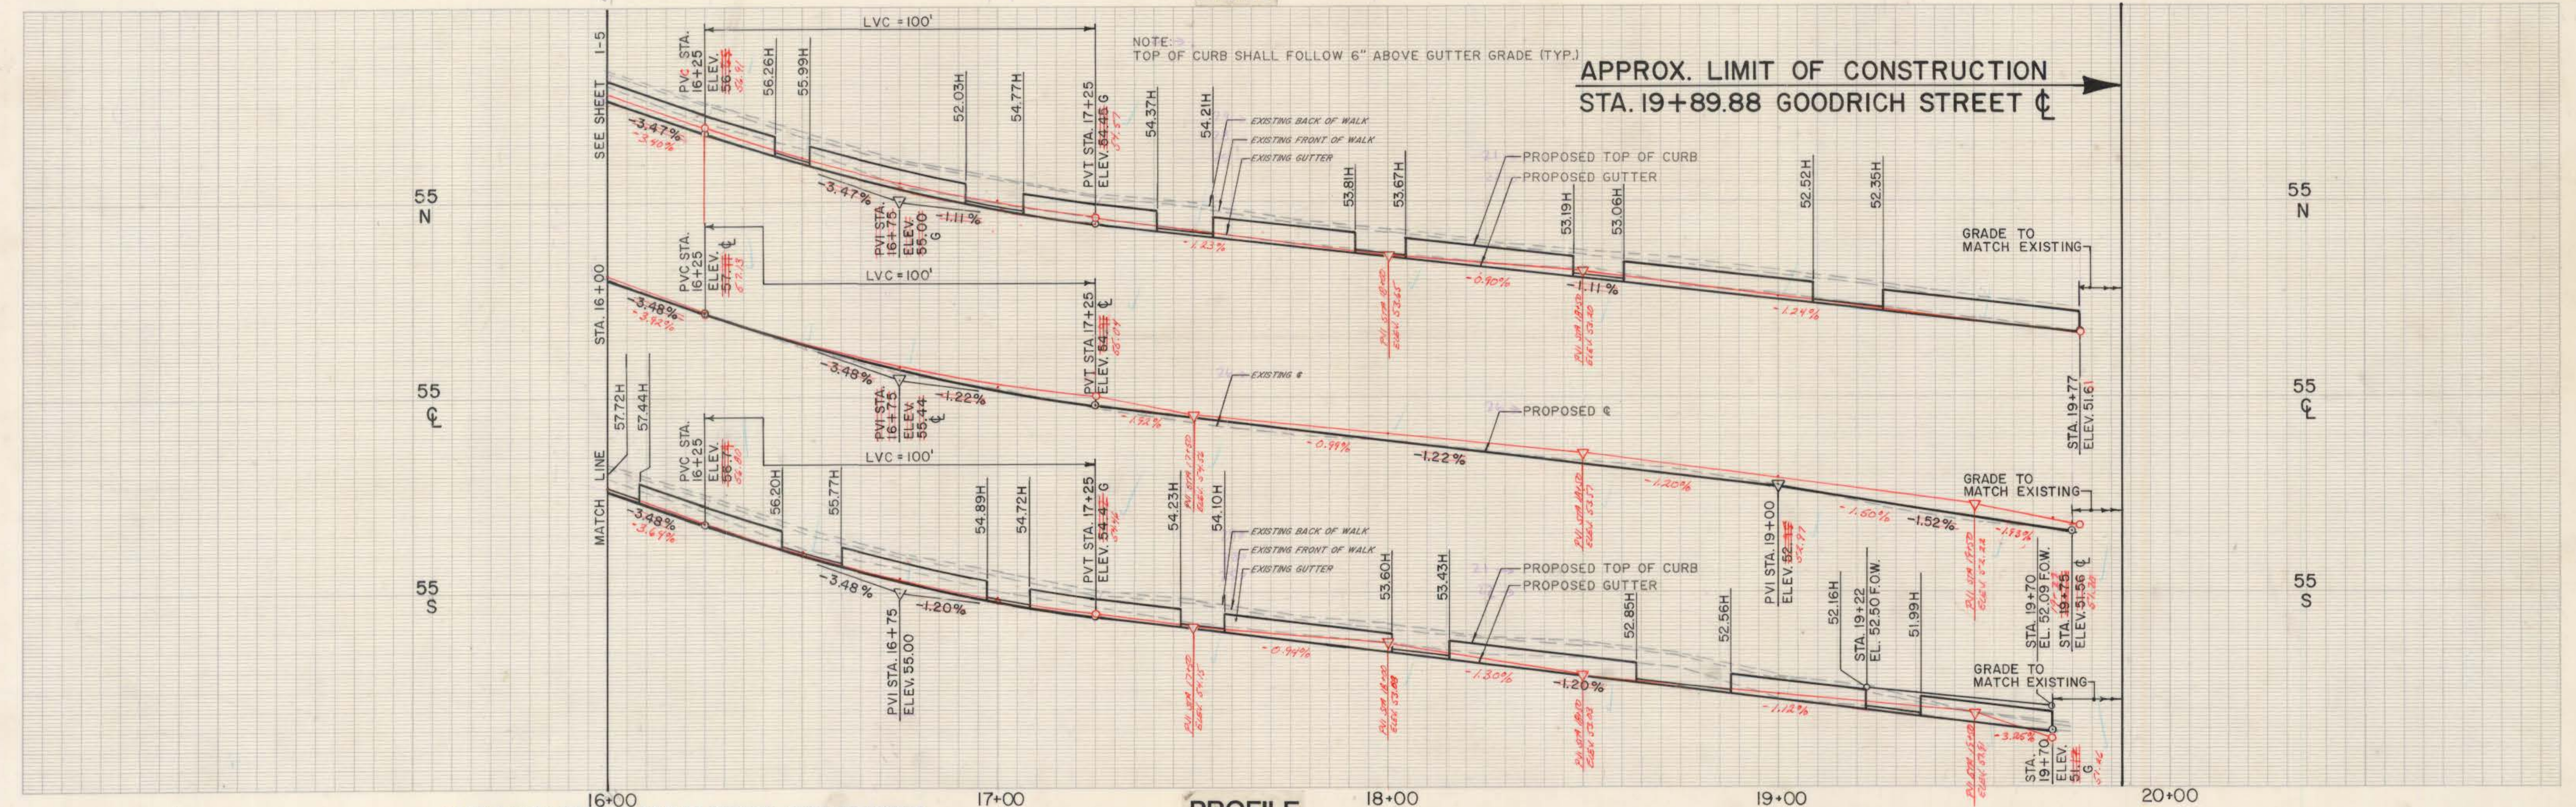

PROFILE

SUPV. ARW DESIGN MDH/ABC DRAWN CHECKED JAC DATE 6-3-85		GRAPHIC SCALES HORIZ. 1" = 20' VERT. 1" = 2'		ROADWAY RECONSTRUCTION HARTFORD, CONNECTICUT				Hayden Wegman Consulting Engineers WEST HARTFORD NEW YORK • BOSTON • BUFFALO ATLANTA • MEMPHIS		CITY OF HARTFORD, CONNECTICUT DEPARTMENT OF PUBLIC WORKS BUREAU OF ENGINEERING SERVICES		GOODRICH STREET STA. 16+00 TO STA. 19+89.88	
REVISIONS NO. DATE DESCRIPTION								DRAWN CHECKED		SCALE DAYBOOK NO. 010947 DATE		PLAN AND PROFILE Contract No. E85-28 Job No. 845304	
												SHEET 2-5	