
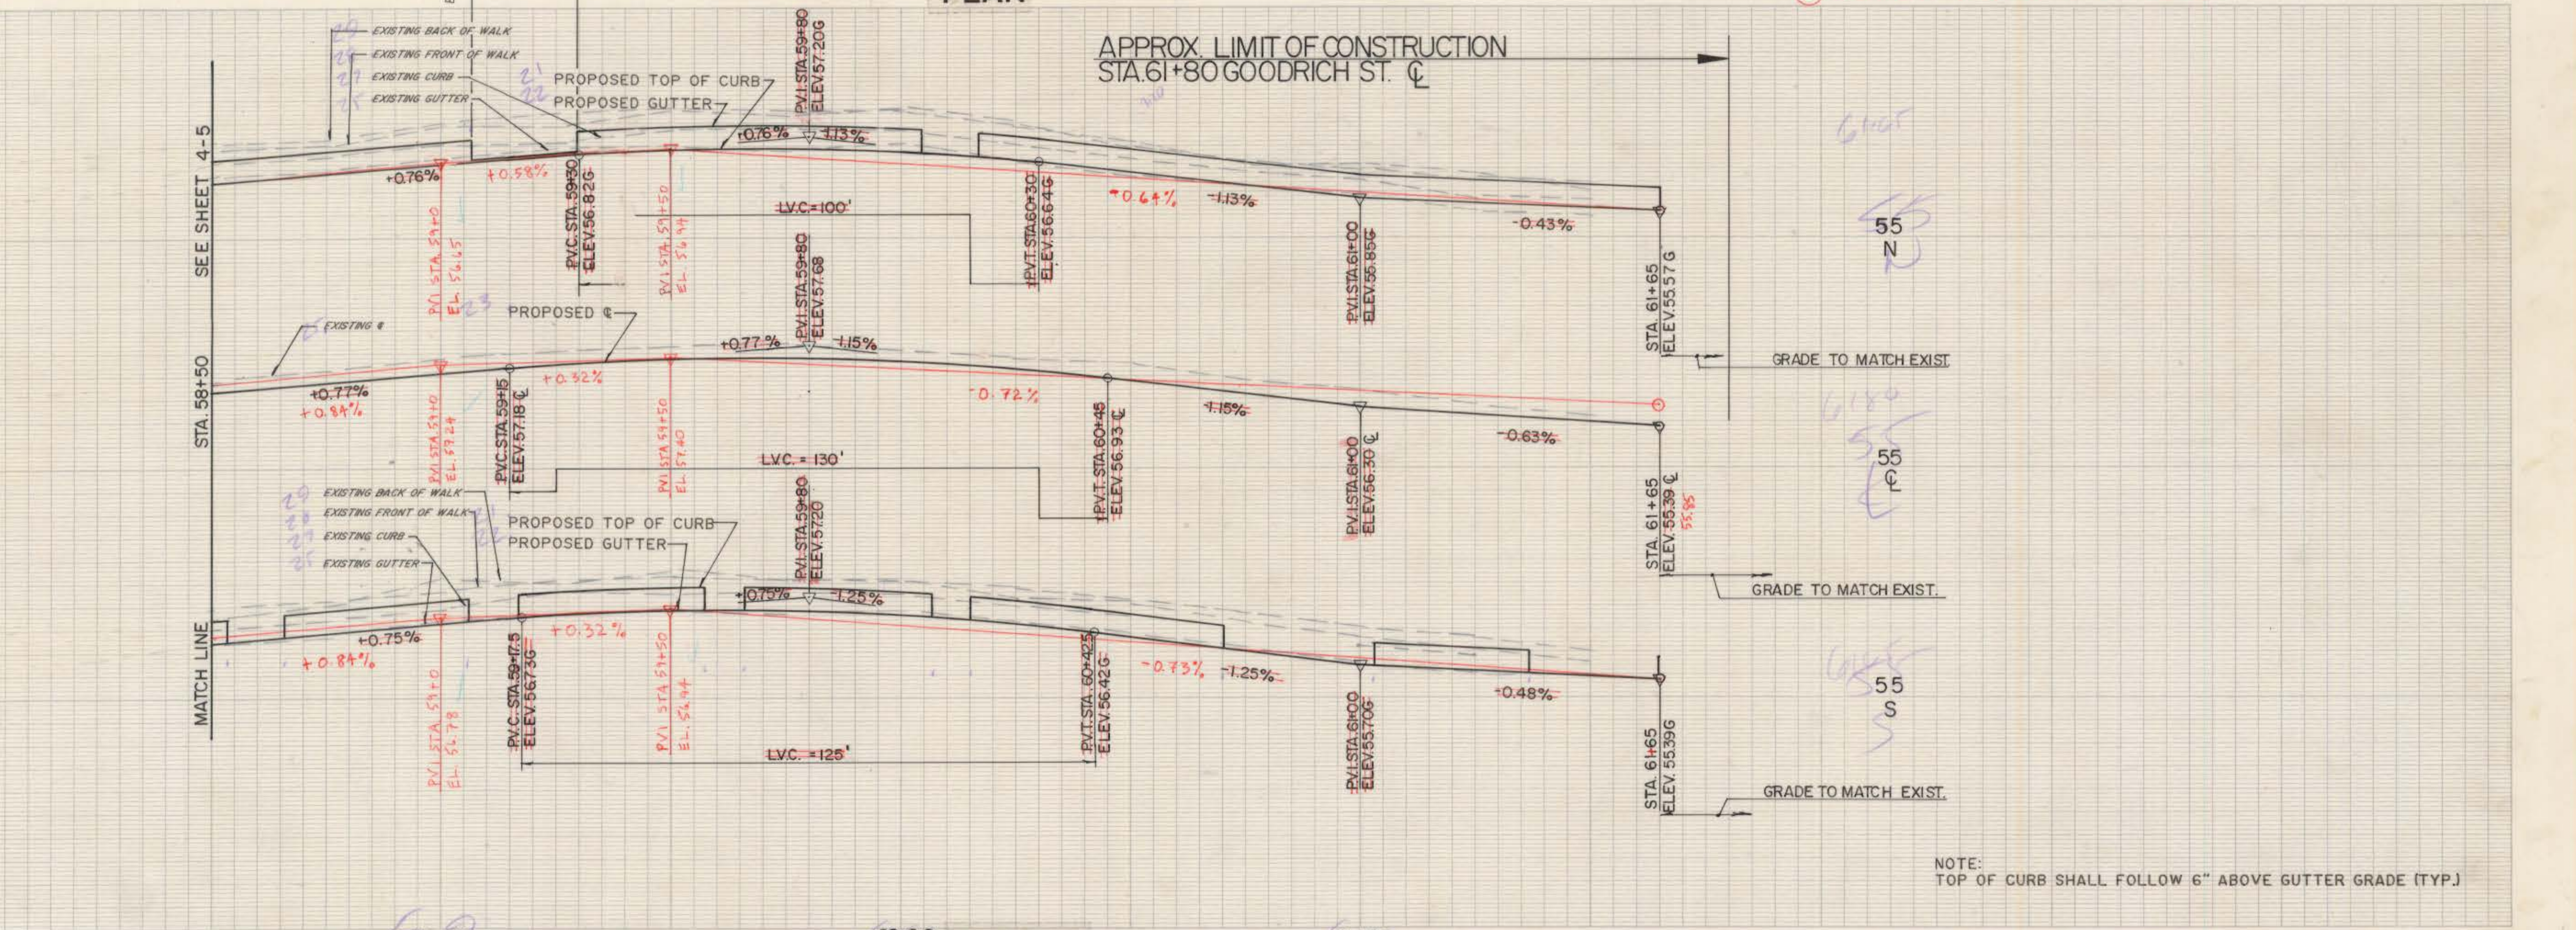


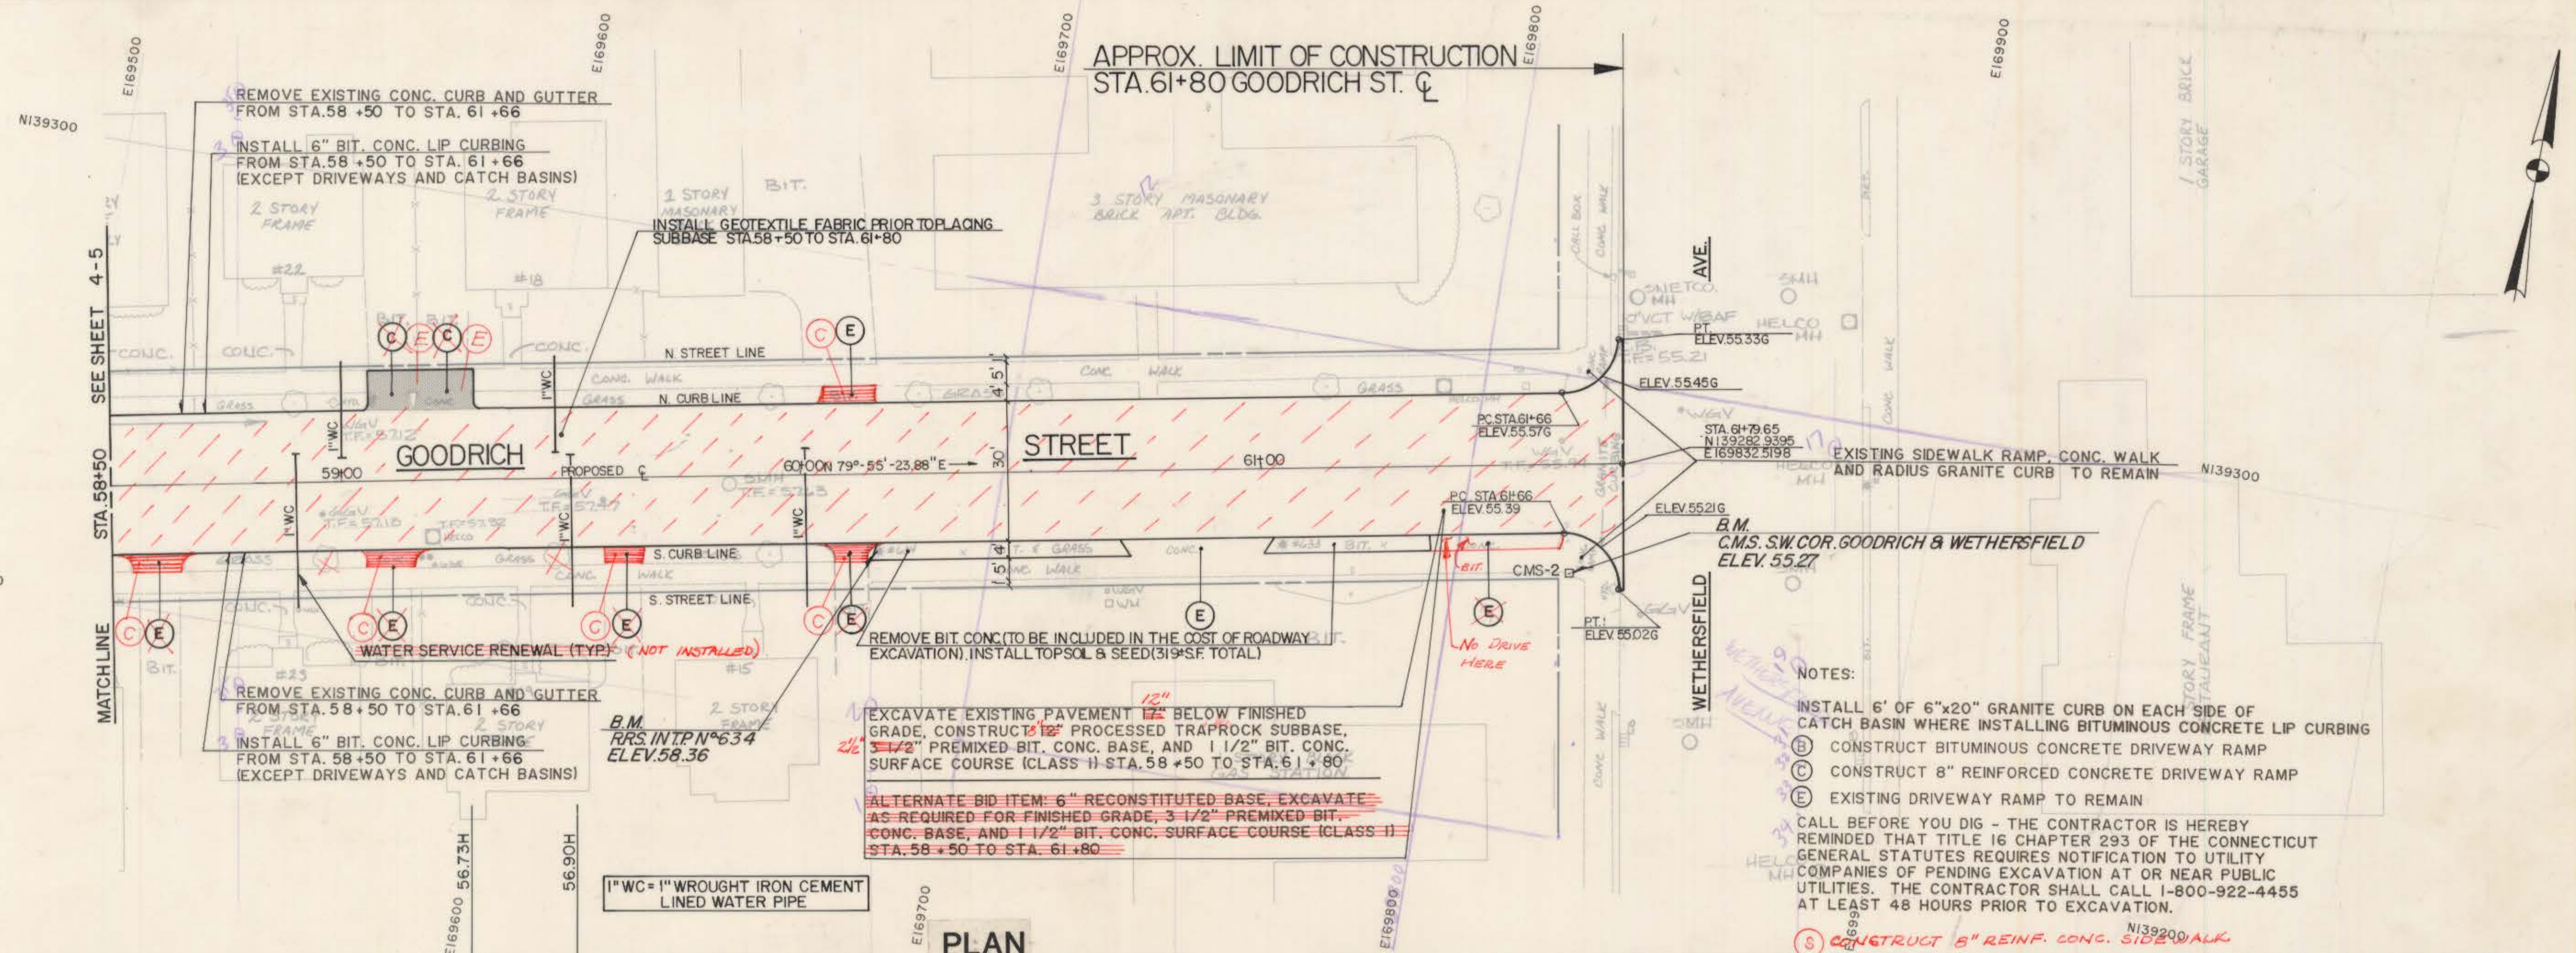

NOTE: CHECK GRAPHIC SCALES BEFORE USING DRAWINGS

SUPV. ARW DESIGN MDH/AEC DRAWN MDH CHECKED JAC DATE 6/3/85		GRAPHIC SCALES HORIZ. 1" = 20' VERT. 1" = 2'	ROADWAY RECONSTRUCTION HARTFORD, CONNECTICUT		Hayden Wegman Consulting Engineers WEST HARTFORD NEW YORK • BOSTON • BUFFALO ATLANTA • MEMPHIS	CITY OF HARTFORD, CONNECTICUT DEPARTMENT OF PUBLIC WORKS BUREAU OF ENGINEERING SERVICES	GOODRICH STREET STA. 58+50 TO STA. 61+80 PLAN AND PROFILE	SHEET 5-5 Contract No. E85-28 Job No. 845304
---	--	--	---	--	---	---	---	---