

- NOTES:
- INSTALL 6" OF 6"x20" GRANITE CURB ON EACH SIDE OF CATCH BASIN WHERE INSTALLING BITUMINOUS CONCRETE LIP CURBING
- (B) CONSTRUCT BITUMINOUS CONCRETE DRIVEWAY RAMP
- (C) CONSTRUCT 8" REINFORCED CONCRETE DRIVEWAY RAMP
- (E) EXISTING DRIVEWAY RAMP TO REMAIN
- (S) **CONSTRUCT 8" REINF. SIDEWALK**
- CALL BEFORE YOU DIG - THE CONTRACTOR IS HEREBY REMINDED THAT TITLE 16 CHAPTER 293 OF THE CONNECTICUT GENERAL STATUTES REQUIRES NOTIFICATION TO UTILITY COMPANIES OF PENDING EXCAVATION AT OR NEAR PUBLIC UTILITIES. THE CONTRACTOR SHALL CALL 1-800-922-4455 AT LEAST 48 HOURS PRIOR TO EXCAVATION.
- INSTALL STOP BAR (12" WHITE PREFORMED PLASTIC PAVEMENT MARKINGS)

EXCAVATE EXISTING PAVEMENT 17" BELOW FINISHED GRADE, CONSTRUCT 12" PROCESSED TRAPROCK SUBBASE, 3 1/2" PREMIXED BIT. CONC. BASE, AND 1 1/2" BIT. CONC. SURFACE COURSE (CLASS I) STA. 20+28 TO STA. 26+00

~~ALTERNATE BID ITEM: 10" RECONSTITUTED BASE, EXCAVATE AS REQUIRED FOR FINISHED GRADE, 3 1/2" PREMIXED BIT. CONC. BASE, AND 1 1/2" BIT. CONC. SURFACE COURSE (CLASS I) STA. 20+28 TO STA. 26+00.~~

CONSTRUCT 5" CONC. SIDEWALK

RESET EXISTING STRAIGHT GRANITE CURB ON NEW FOUNDATION FROM STA. 20+28 TO STA. 26+00 (EXCEPT DRIVEWAYS)


RESET EXISTING STRAIGHT GRANITE CURB ON NEW FOUNDATION FROM STA. 20+28 TO STA. 26+00 (EXCEPT DRIVEWAYS)

BM RR SPIKE TP NO. 468 ELEV.=55.18'

1" WC=1" WROUGHT IRON CEMENT LINED WATER PIPE

BM RR SPIKE TP NO. 466 ELEV.=50.59

PLAN

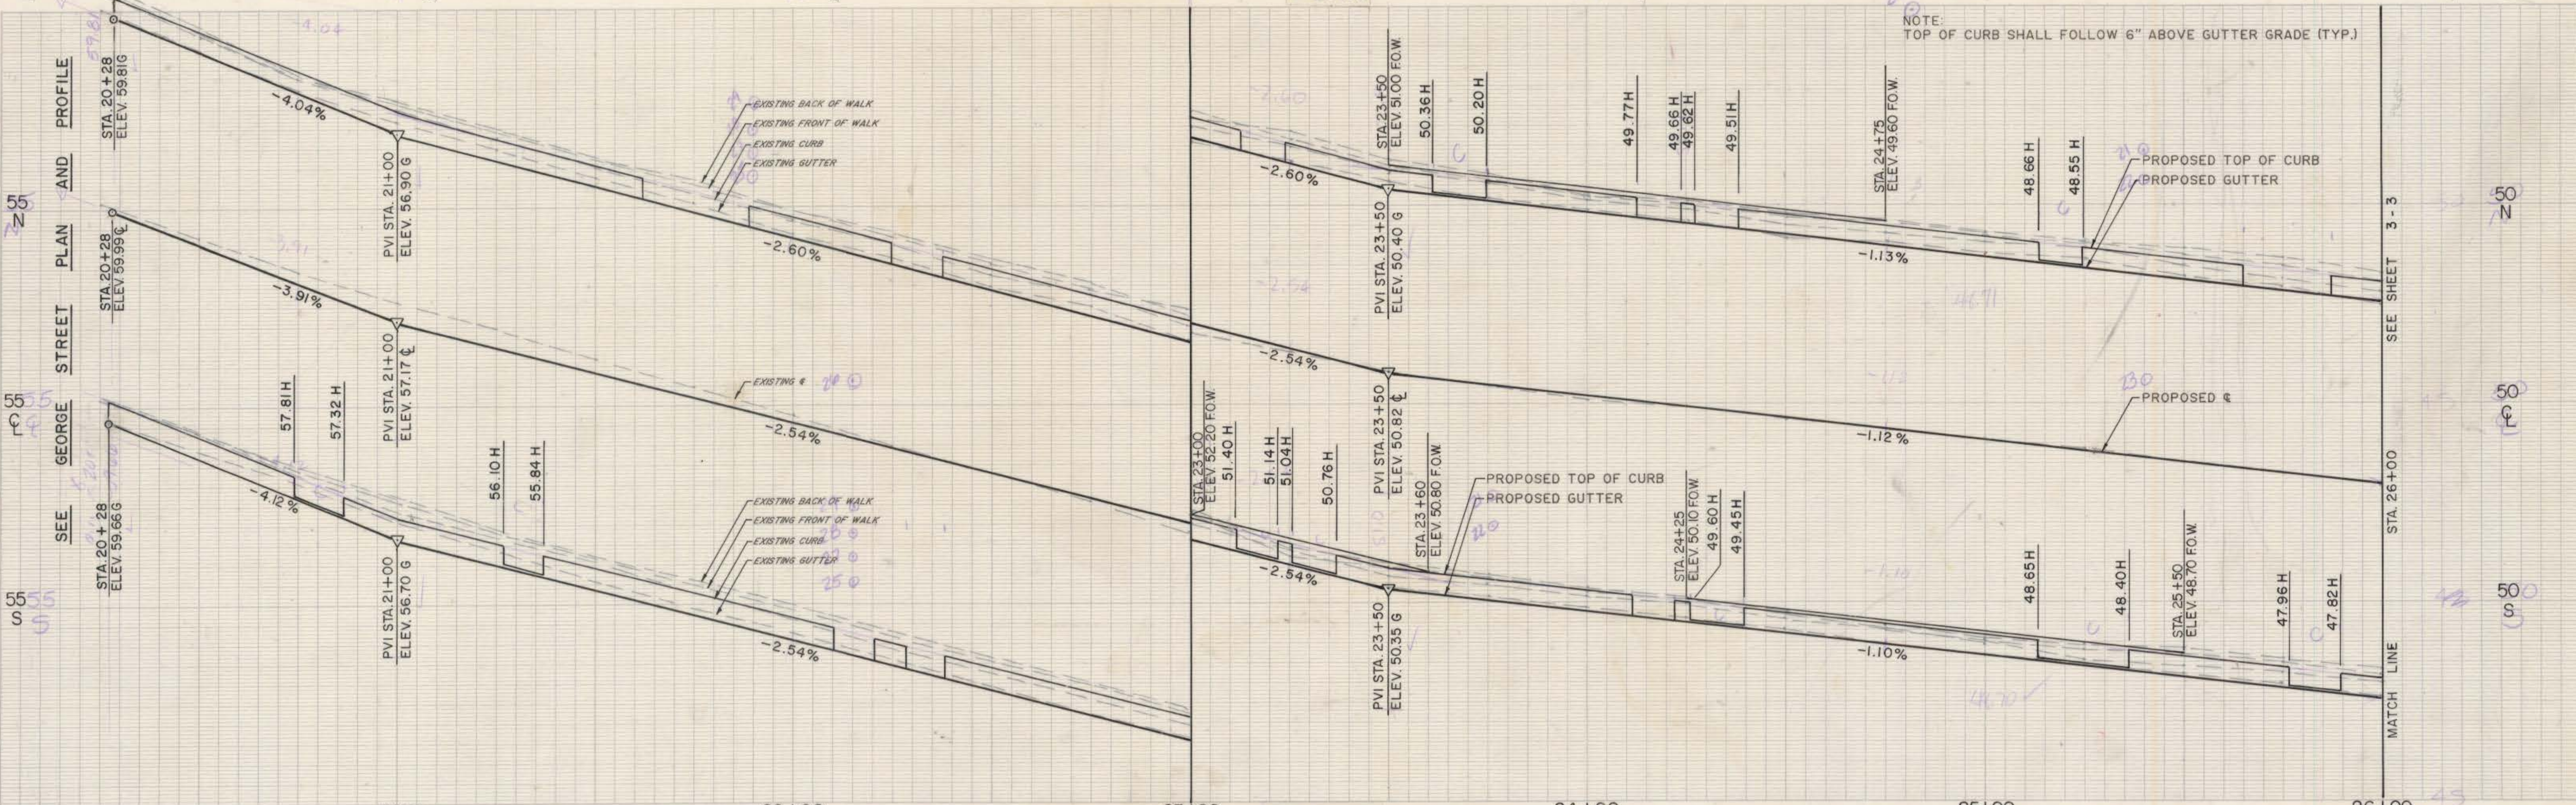

PROFILE

NOTE: CHECK GRAPHIC SCALES BEFORE USING DRAWINGS

SUPV. ARW		GRAPHIC SCALES			Hayden Wegman Consulting Engineers WEST HARTFORD NEW YORK • BOSTON • BUFFALO ATLANTA • MEMPHIS	CITY OF HARTFORD, CONNECTICUT DEPARTMENT OF PUBLIC WORKS BUREAU OF ENGINEERING SERVICES		STANDISH STREET STA. 20+28 TO STA. 26+00		PLAN AND PROFILE SHEET 2-3		
DESIGN MDH / AEC		HORIZ. 1"=20'				DRAWN KHT		SCALE			DAYBOOK NO. 010947	
CHECKED VAC		VERT. 1"=2'				DATE 6.3.85		DATE			Contract No. E 85-28	
NO. DATE DESCRIPTION		REVISIONS				Job No. 845304		OF				