

NOTES:

INSTALL 6' OF 6"x20" GRANITE CURB ON EACH SIDE OF CATCH BASIN WHERE INSTALLING BITUMINOUS CONCRETE LIP CURBING
CONSTRUCT BITUMINOUS CONCRETE DRIVEWAY RAMP

CONSTRUCT 8" REINFORCED CONCRETE DRIVEWAY RAMP

EXISTING DRIVEWAY RAMP TO REMAIN:

CONSTRUCT 8" REINF. CONC. SIDEWALK

CALL BEFORE YOU DIG - THE CONTRACTOR IS HEREBY REMINDED THAT TITLE 16 CHAPTER 293 OF THE CONNECTICUT GENERAL STATUTES REQUIRES NOTIFICATION TO UTILITY COMPANIES OF PENDING EXCAVATION AT OR NEAR PUBLIC UTILITIES. THE CONTRACTOR SHALL CALL 1-800-922-4455 AT LEAST 48 HOURS PRIOR TO EXCAVATION. CALL BEFORE YOU DIG -

EXCAVATE EXISTING PAVEMENT 12" BELOW FINISHED GRADE. CONSTRUCT 12" PROCESSED TRAPROCK SUBBASE, 3 1/2" PREMIXED BIT. CONC. BASE, AND 1 1/2" BIT. CONC. SURFACE COURSE (CLASS II) STA. 26+00 TO STA. 31+10.75

ALTERNATE BID ITEM: 10" RECONSTITUTED BASE, EXCAVATE AS REQUIRED FOR FINISHED GRADE, 3 1/2" PREMIXED BIT. CONC. BASE, AND 1 1/2" BIT. CONC. SURFACE COURSE (CLASS II) STA. 26+00 TO STA. 31+10.75

RESET EXISTING STRAIGHT GRANITE CURB ON NEW FOUNDATION FROM STA. 26+00 TO STA. 30+97 (EXCEPT DRIVEWAYS)


RESET EXISTING STRAIGHT GRANITE CURB ON NEW FOUNDATION FROM STA. 26+00 TO STA. 30+93 (EXCEPT DRIVEWAYS)

WATER SERVICE RENEWAL (TYP.) (NOT INSTALLED)

B.M. R.R.S. TPN#462 ELEV. 46.16


1"WC=1" WROUGHT IRON CEMENT LINED WATER PIPE

APPROX. LIMIT OF CONSTRUCTION STA. 31+10.75 STANDISH STREET CL

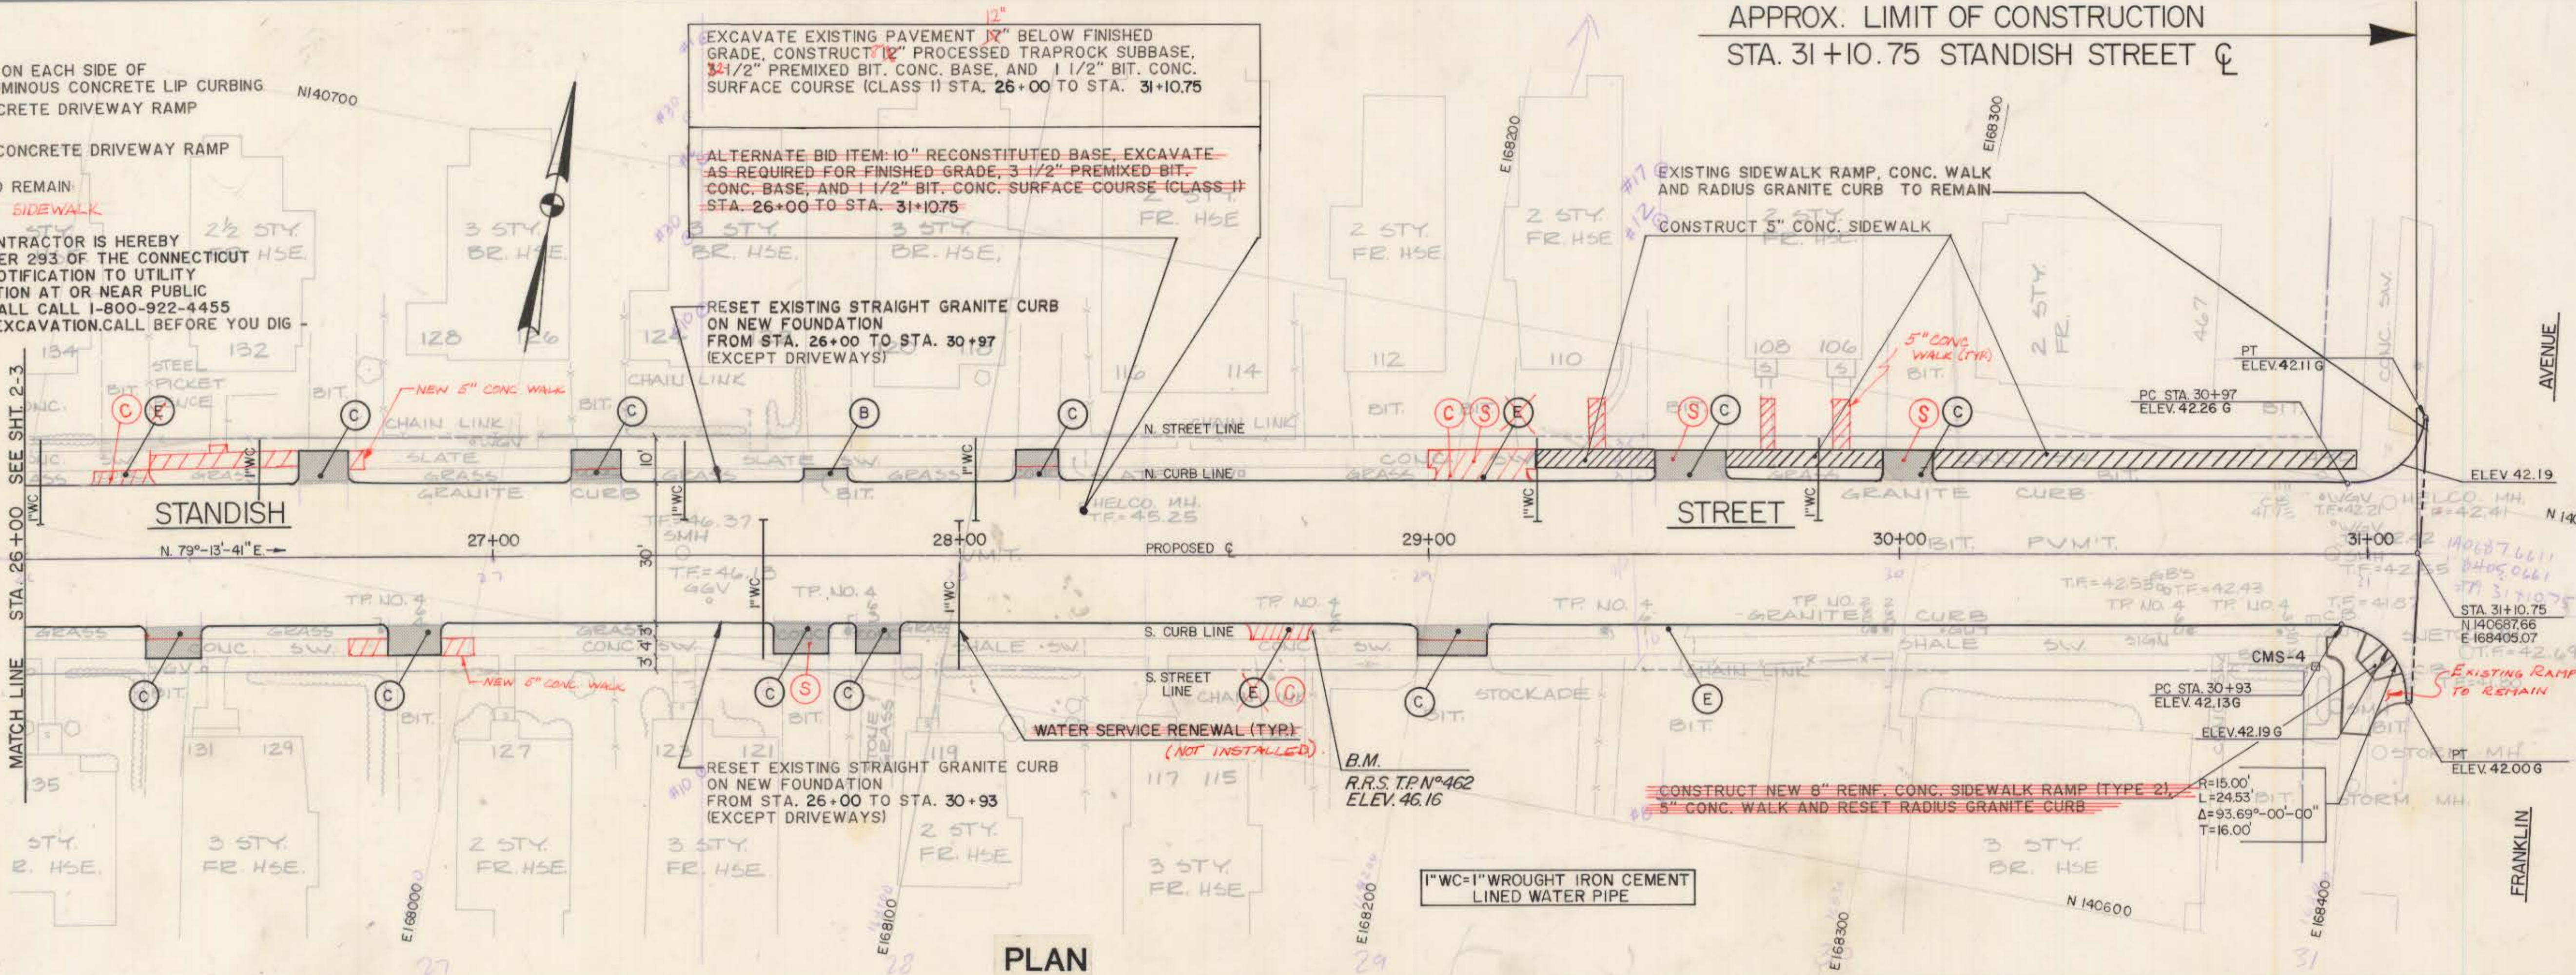

PLAN

APPROX. LIMIT OF CONSTRUCTION STA. 31+10.75 STANDISH STREET CL

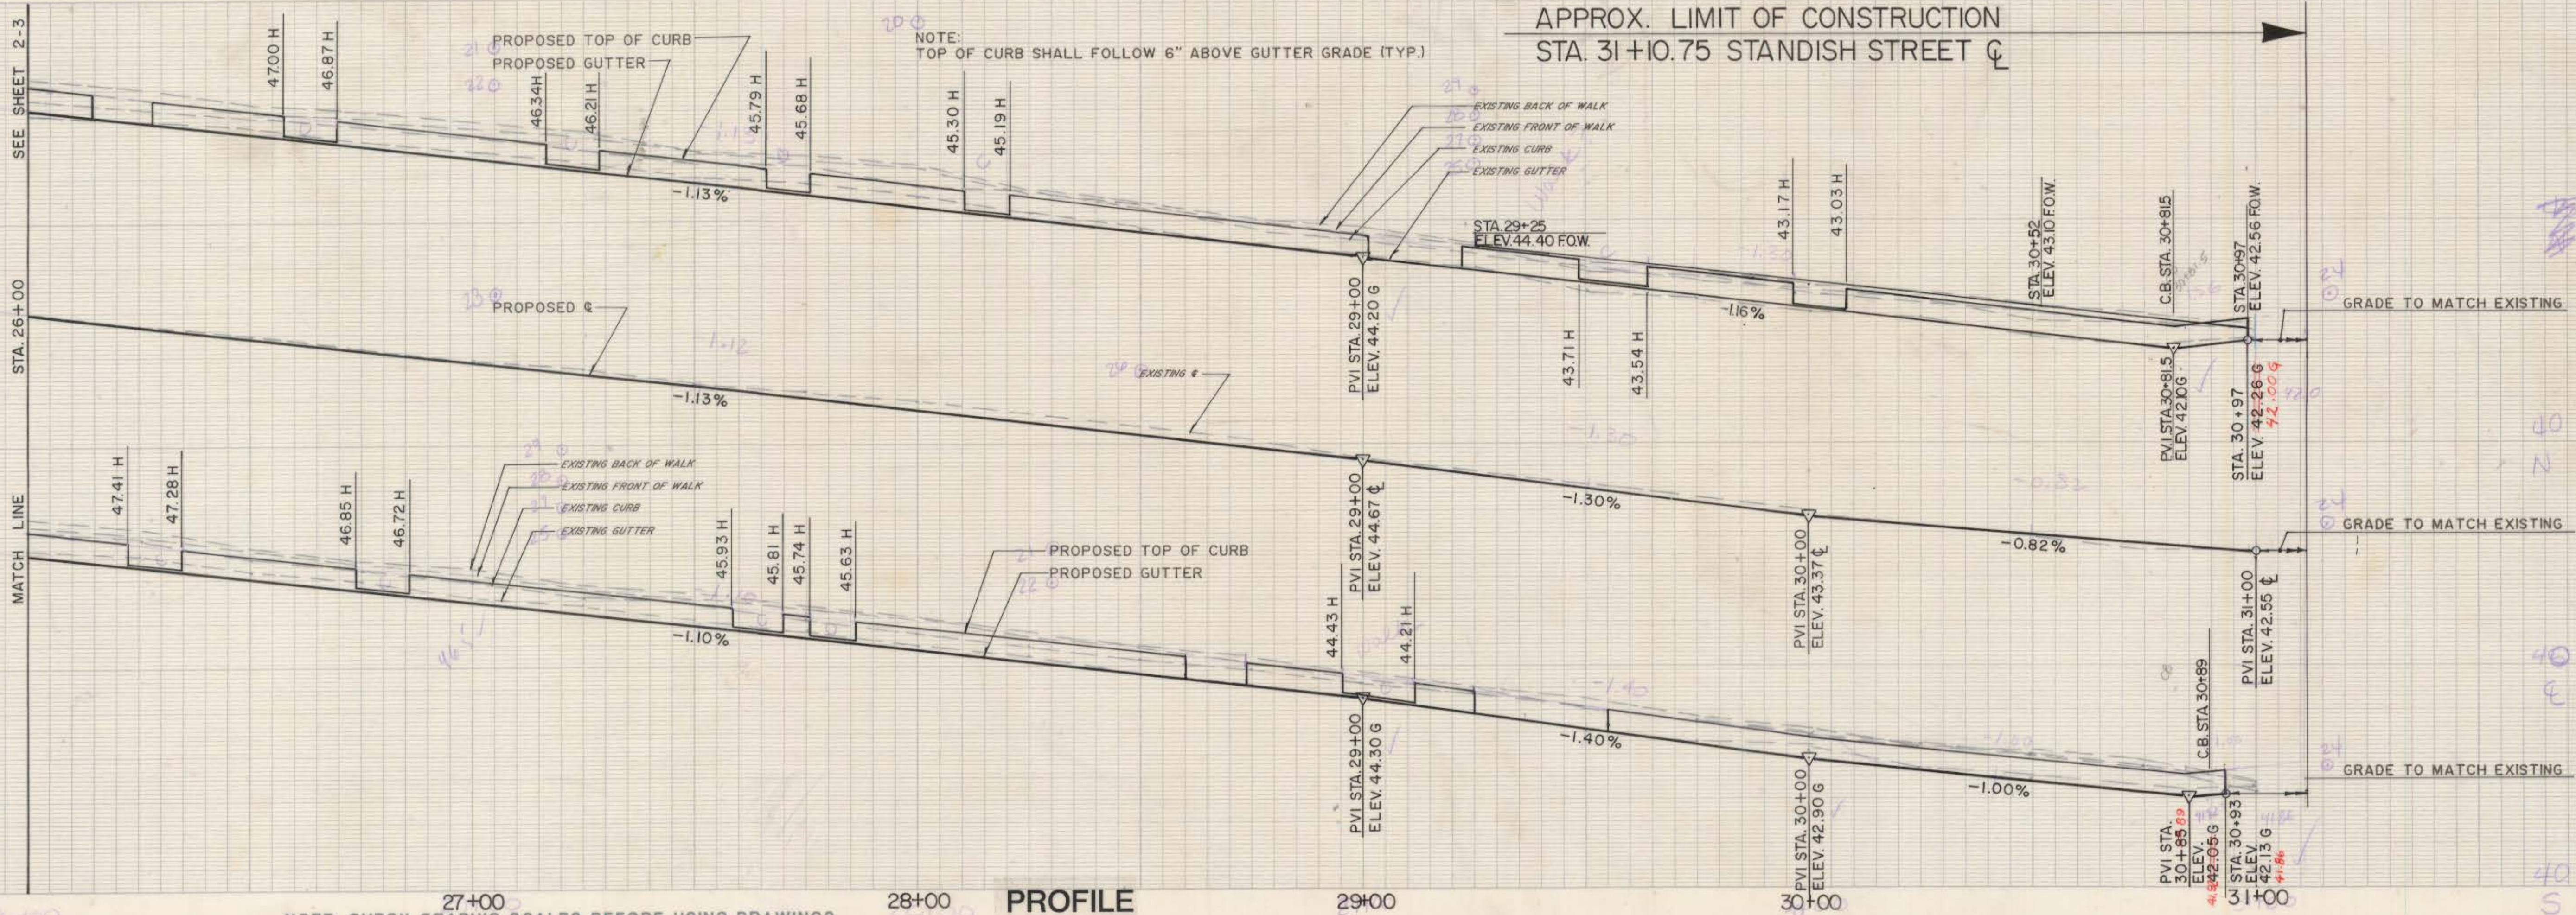

PROFILE

NOTE: CHECK GRAPHIC SCALES BEFORE USING DRAWINGS

NO.	DATE	DESCRIPTION
1	NOV 14	REVISED BY JAC - CHECKED BY MDH
2	NOV 14	REVISED BY JAC - CHECKED BY MDH

SUPV.	ARW
DESIGN	MDH/ABC
DRAWN	MDH/ABC
CHECKED	JAC
DATE	6-3-85

GRAPHIC SCALES
HORIZ. 1"=20'
VERT. 1"=2'

ROADWAY RECONSTRUCTION
HARTFORD, CONNECTICUT



Hayden | Wegman
Consulting Engineers
WEST HARTFORD
NEW YORK • BOSTON • BUFFALO
ATLANTA • MEMPHIS

CITY OF HARTFORD, CONNECTICUT
DEPARTMENT OF PUBLIC WORKS
BUREAU OF ENGINEERING SERVICES
DRAWN
CHECKED
SCALE
DAYBOOK NO. 010947
DATE

STANDISH STREET
STA. 26+00 TO STA. 31+10.75
PLAN AND PROFILE
SHEET 3-3
Contract No. E85-28 Job No. 845304 OF