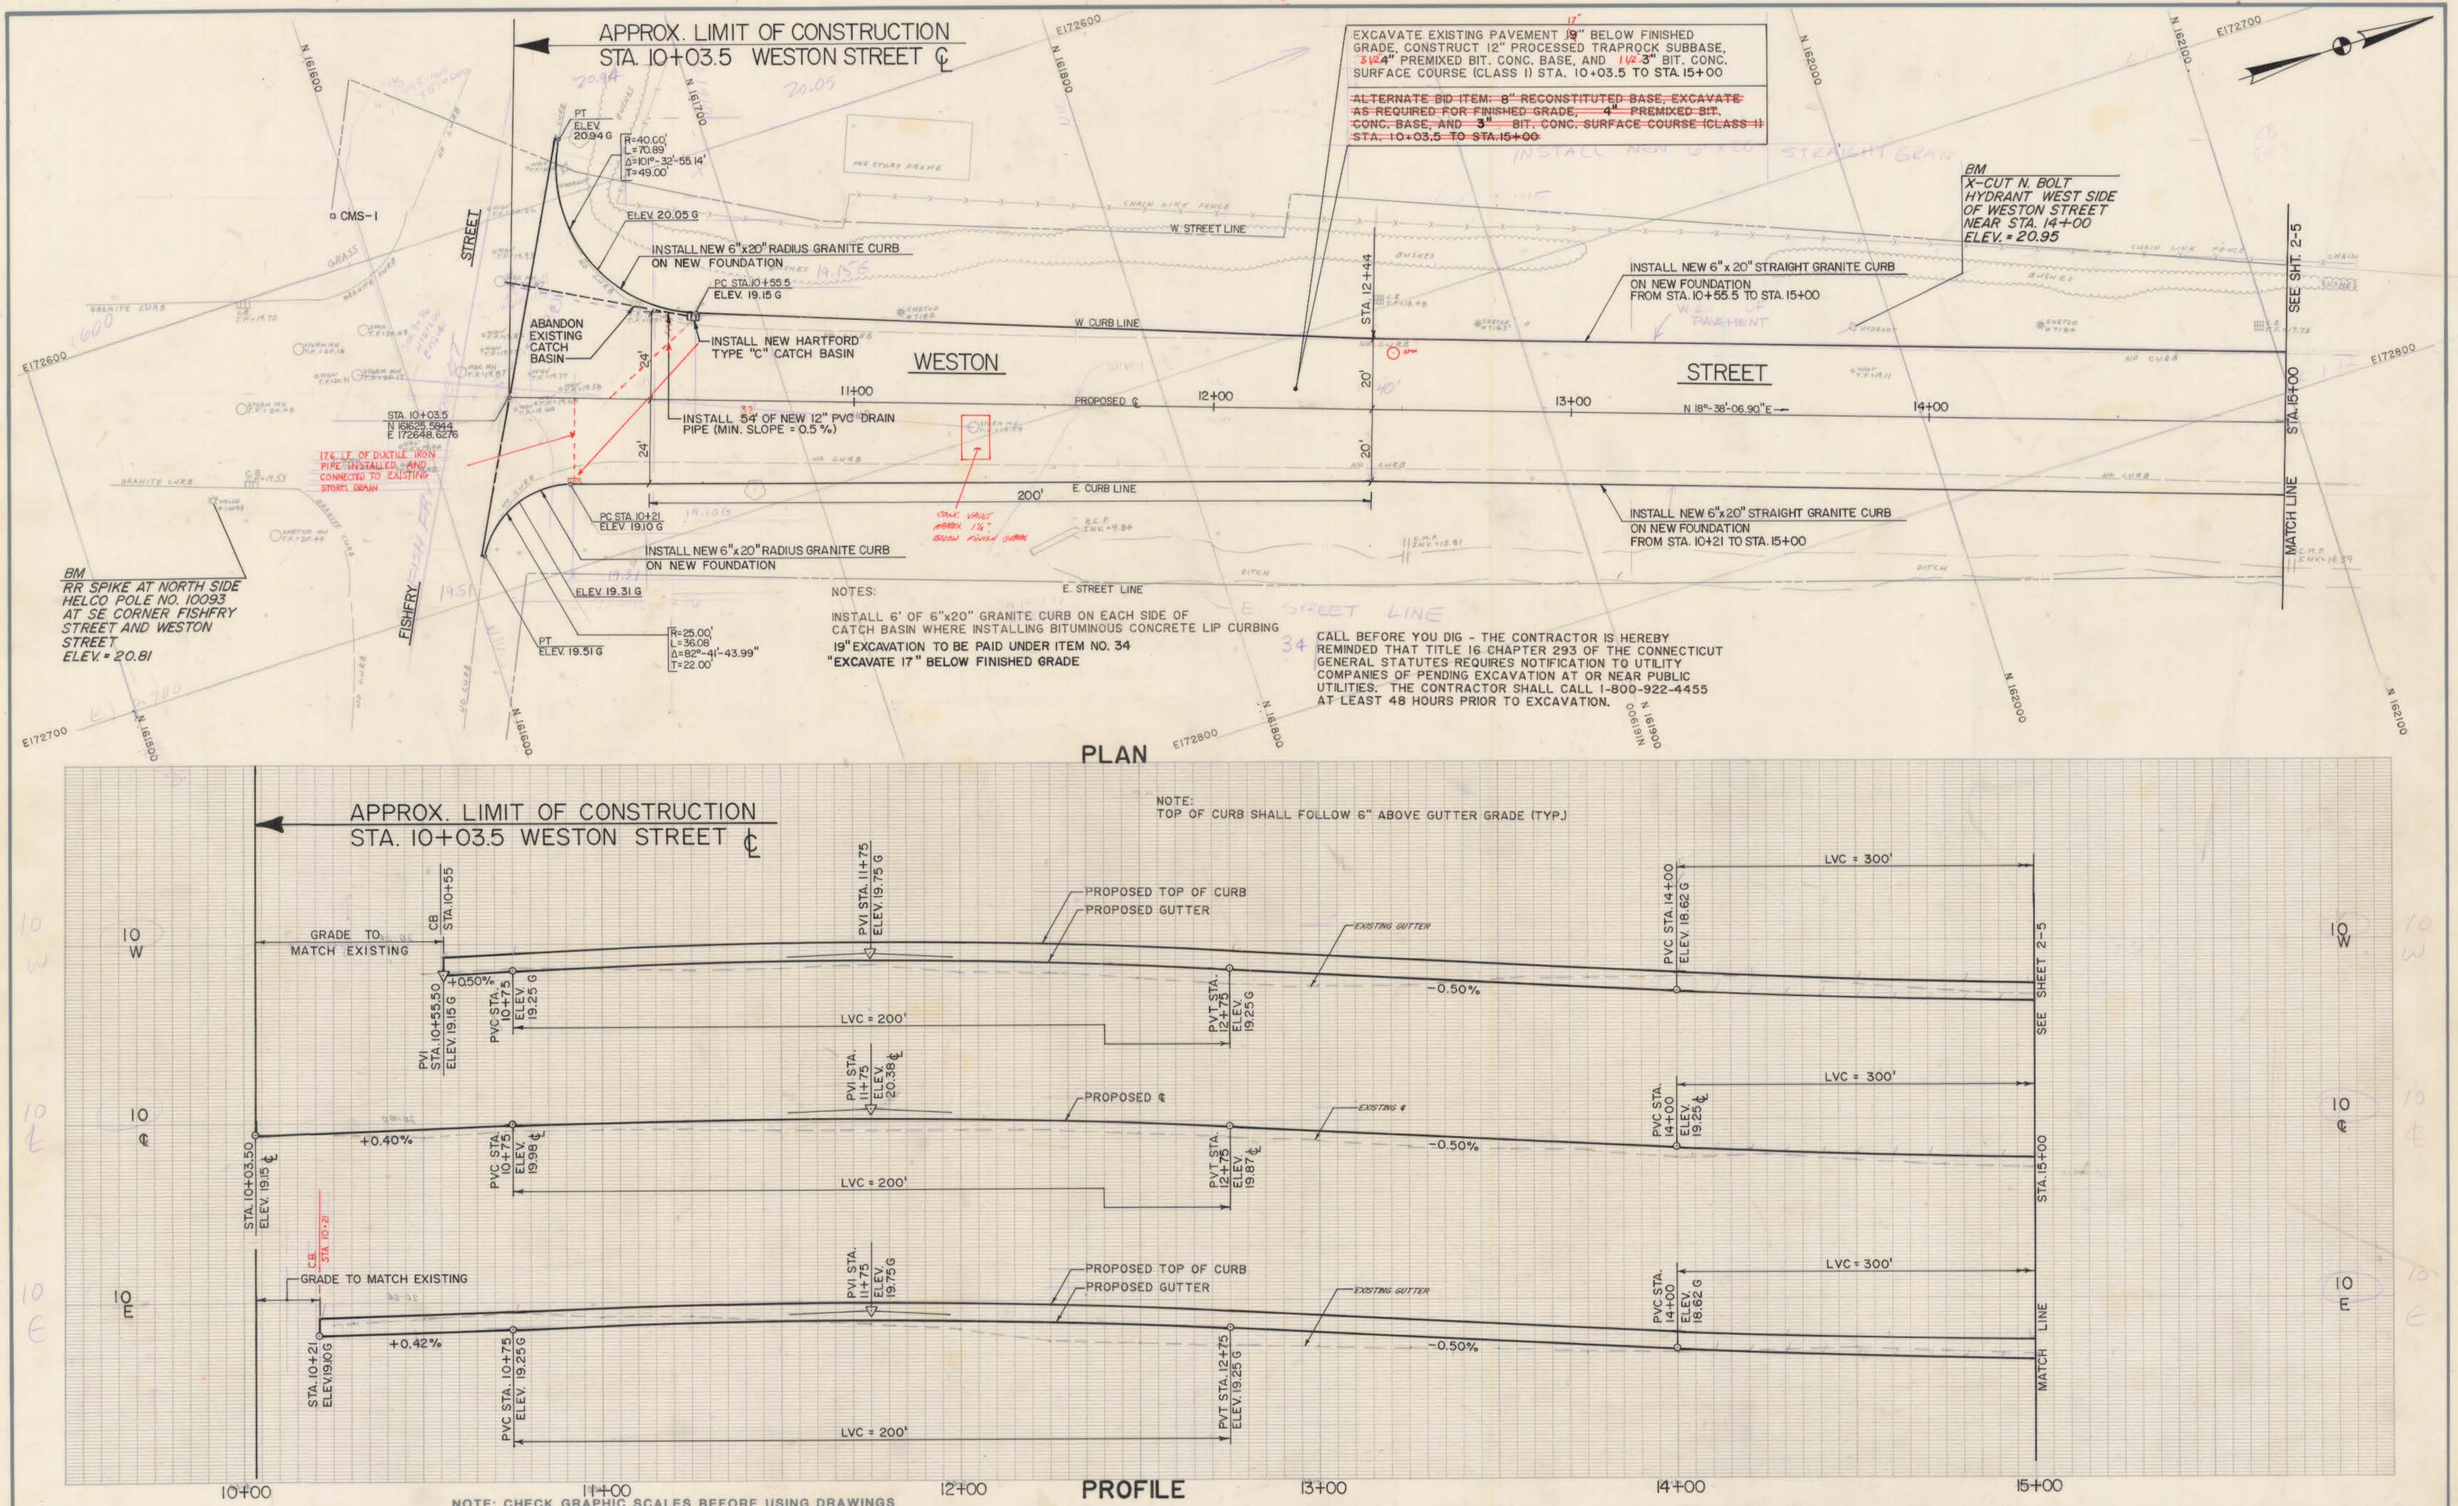

NOTE: CHECK GRAPHIC SCALES BEFORE USING DRAWINGS

NO.	DATE	DESCRIPTION