
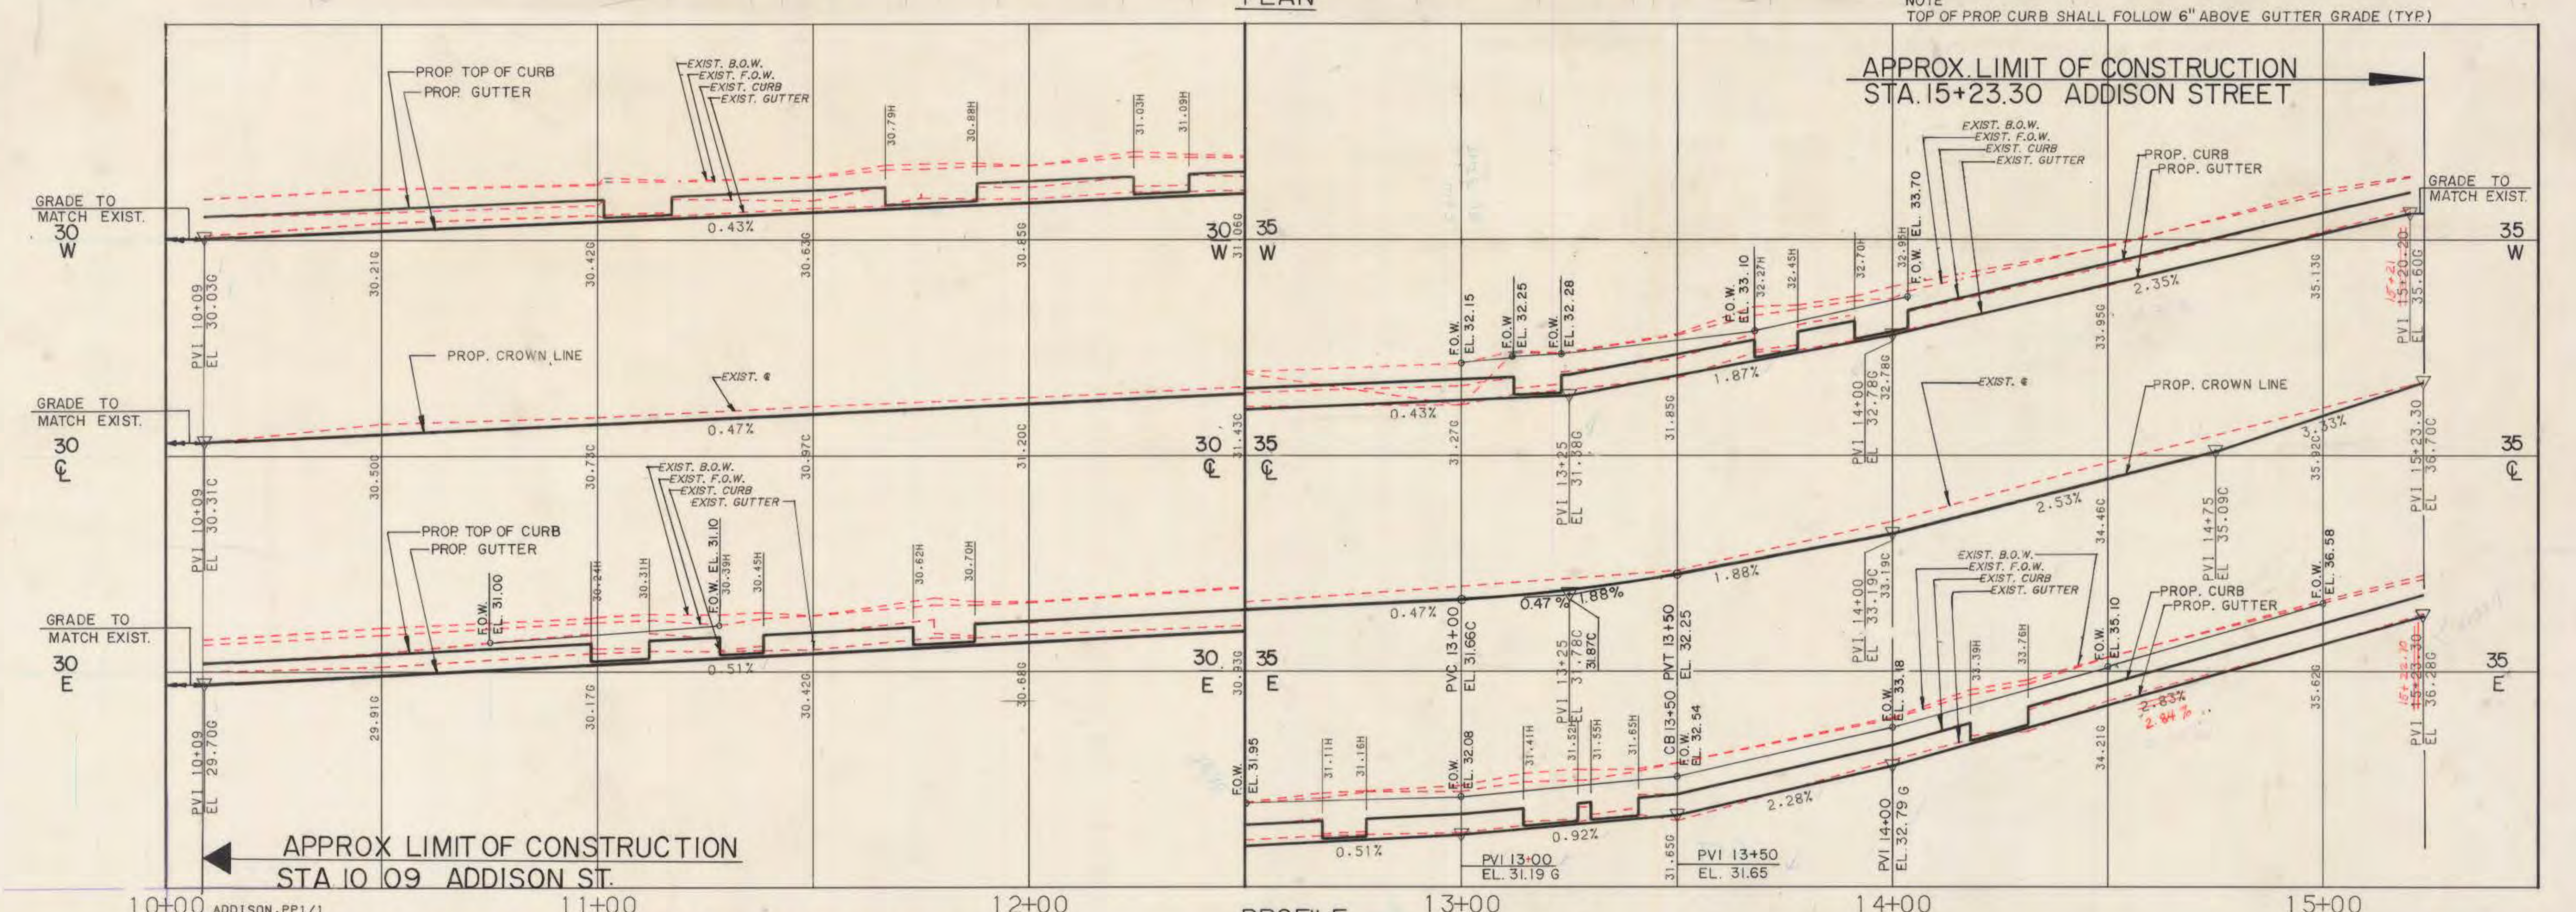


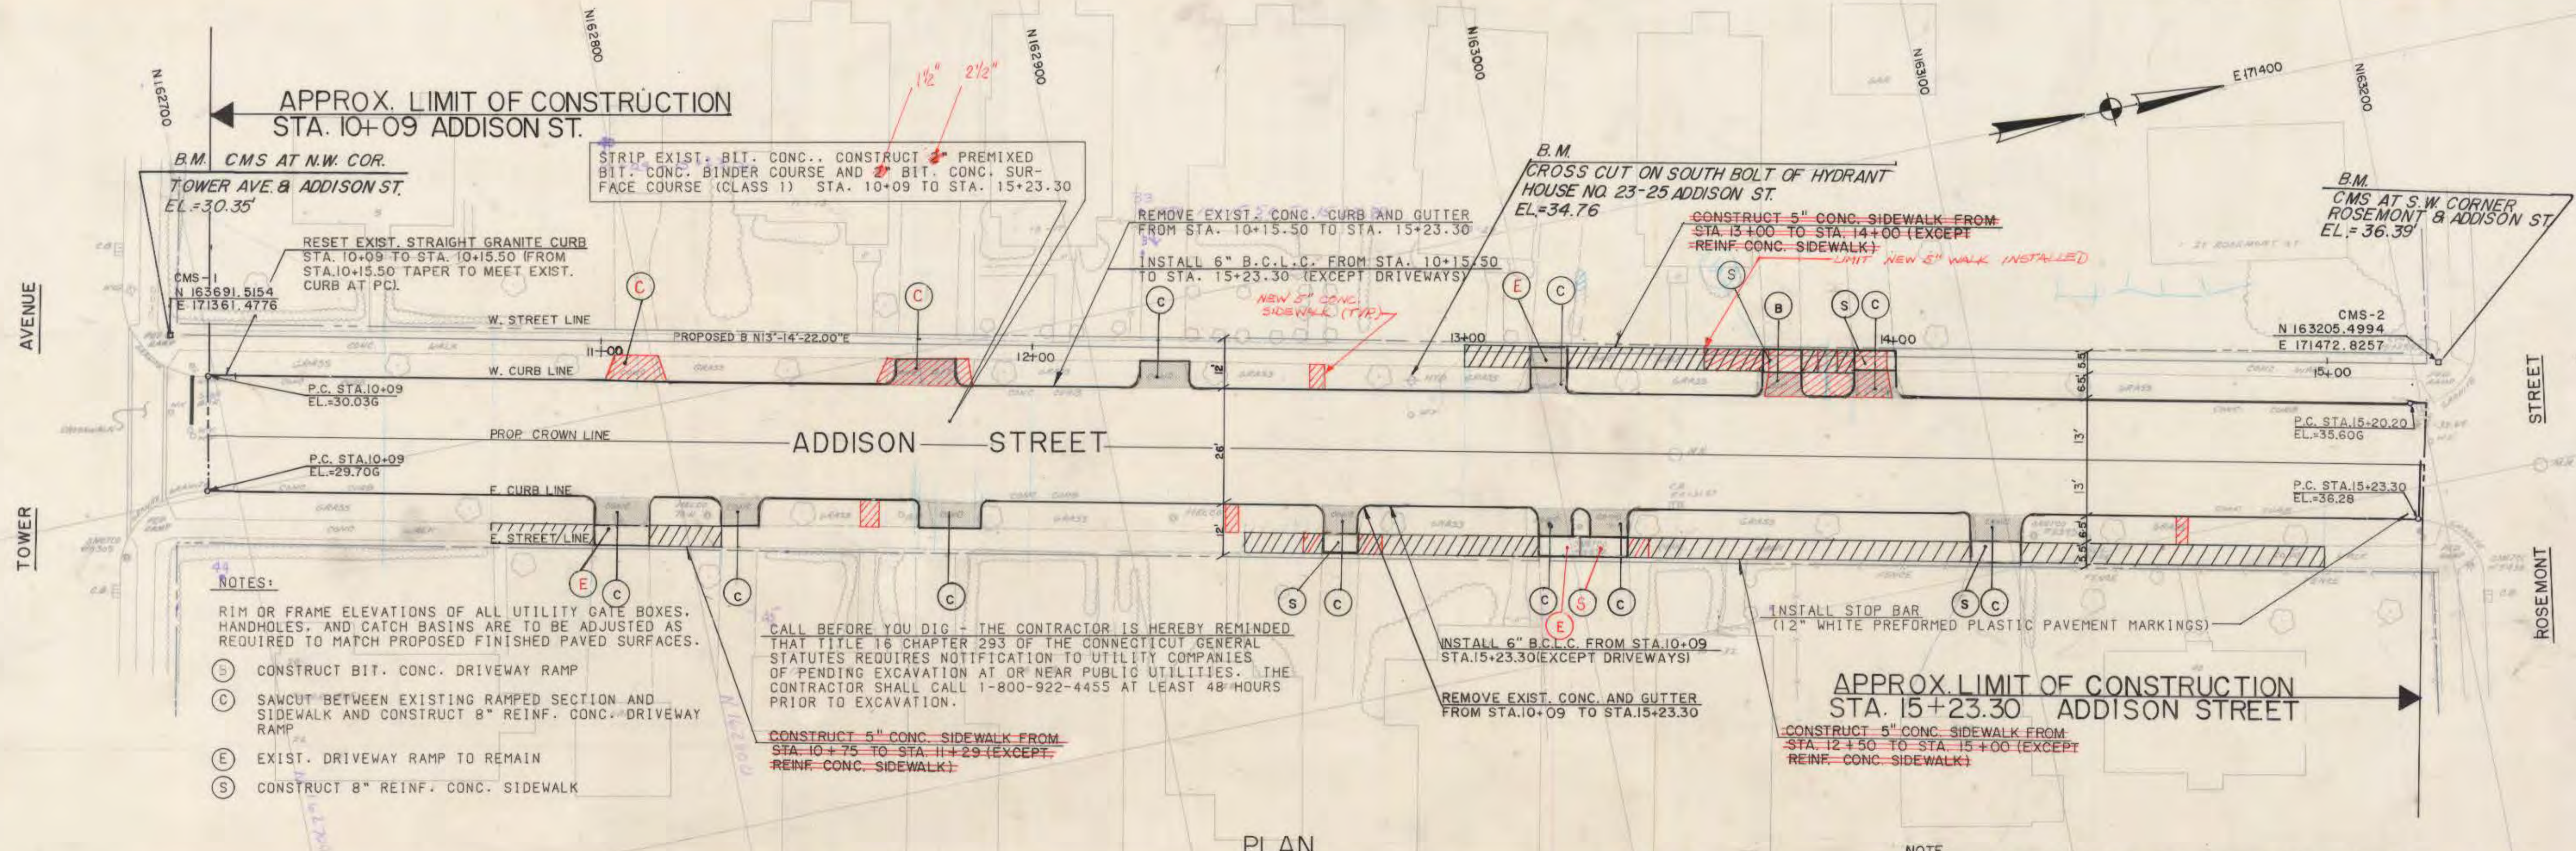

SUPV. JAC DESIGN MDH/AEC DRAWN RUC CHECKED AEC DATE 01-30-86		GRAPHIC SCALES HORIZ. 1" = 20' VERT. 1" = 2'		ROADWAY RECONSTRUCTION HARTFORD, CONNECTICUT		CITY OF HARTFORD, CONNECTICUT DEPARTMENT OF PUBLIC WORKS BUREAU OF ENGINEERING SERVICES		ADDISON STREET STA. 10+09 TO STA. 15+23.30		PLAN AND PROFILE CONTRACT NO. E86-9 Job No. 852534	
REVISIONS NO. DATE DESCRIPTION				HAYDEN WEGMAN Consulting Engineers WEST HARTFORD NEW YORK • BOSTON • BUFFALO ATLANTA • MEMPHIS		DAYBOOK NO. 011012 DATE		SHEET 1 OF 4			