APPROX. LIMIT OF CONSTRUCTION
STA. 10+09 MELROSE STREET

EXCAVATE EXIST. PAVEMENT 12" BELOW FINISHED GRADE, CONSTRUCT 8" PROCESSED TRAPROCK BASE, 2" PREMIXED CONC. BINDER COURSE, AND 2" BIT. CONC. SURFACE COURSE (CLASS I) STA. 10+09 TO STA. 15+04.60

APPROX. LIMIT OF CONSTRUCTION
STA. 15+04.60 MELROSE STREET

REMOVE EXIST. CONC. CURB AND GUTTER FROM STA. 10+09 TO STA. 15+04.40

INSTALL 6" B.C.L.C. FROM STA. 10+09 TO STA. 15+04.40 (EXCEPT DRIVEWAYS)

INSTALL GEOTEXTILE FABRIC STA. 10+09 TO STA. 15+04.60 PRIOR TO PLACING BASE.

BM E. BOLT ON HYD. AT HOUSE No. 19 EL.= 37.60

CONSTRUCT 5" CONC. SIDEWALK FROM STA. 12+50 TO STA. 13+00 (EXCEPT REINF. CONC. SIDEWALK)

INSTALL STOP BAR (12" WHITE PREFORMED PLASTIC PAVEMENT MARKINGS)

W. STREET LINE
W. CURB LINE
PC STA. 10+09 EL. 32.37G
PC STA. 10+09.40 EL. 32.28G
E. CURB LINE
PROP. ℄ N 12°-13'-58.00" E
E. STREET LINE
CMS-1 N 162749.6018 E 171093.6003

TOWER AVENUE

MELROSE STREET

PROP. CROWN LINE

INSTALL STOP BAR (12" WHITE PREFORMED PLASTIC PAVEMENT MARKINGS)

PC STA. 15+04.40 EL. 40.56G
PC STA. 15+04.60 EL. 39.79G

INSTALL STOP BAR (12" WHITE PREFORMED PLASTIC PAVEMENT MARKINGS)

ROSEMONT STREET

CMS-2 N 163250.6937 E 171202.2409

BM TOP CENTER NUT ON HYD. OPP. MELROSE ST. EL.= 43.99'

CONSTRUCT 5" CONC. WALK FROM STA. 11+68 TO STA. 12+00 (EXCEPT REINF. CONC. SIDEWALK)

REMOVE EXIST. CONC. CURB AND GUTTER FROM STA. 10+09.40 TO STA. 15+04.60

INSTALL 6" B.C.L.C. FROM STA. 10+09.40 TO STA. 15+04.60 (EXCEPT DRIVEWAYS)

STRIP EXIST. BITUMINOUS CONC. SURFACE FROM STONE BASE. CONSTRUCT 2 1/2" PREMIXED CONC. BINDER COURSE AND 1 1/2" BIT. SURFACE COURSE (CLASS I) STA 10+09 TO STA 15+04.6 (EXCEPT INDICATED AREAS).

NOTES:

RIM OR FRAME ELEVATIONS OF ALL UTILITY GATE BOXES, HANDHOLES, AND CATCH BASINS ARE TO BE ADJUSTED AS REQUIRED TO MATCH PROPOSED FINISHED PAVED SURFACES.

(B) CONSTRUCT BIT. CONC. DRIVEWAY RAMP

(C) SAWCUT BETWEEN EXISTING RAMPED SECTION AND SIDEWALK AND CONSTRUCT 8" REINF. CONC. DRIVEWAY RAMP

(E) EXIST. DRIVEWAY RAMP TO REMAIN

(S) CONSTRUCT 8" REINF. CONC. SIDEWALK

CALL BEFORE YOU DIG - THE CONTRACTOR IS HEREBY REMINDED THAT TITLE 16 CHAPTER 293 OF THE CONNECTICUT GENERAL STATUTES REQUIRES NOTIFICATION TO UTILITY COMPANIES OF PENDING EXCAVATION AT OR NEAR PUBLIC UTILITIES. THE CONTRACTOR SHALL CALL 1-800-922-4455 AT LEAST 48 HOURS PRIOR TO EXCAVTION

PLAN

NOTE:
TOP OF PROP. CURB SHALL FOLLOW 6" ABOVE GUTTER GRADE (TYP.)

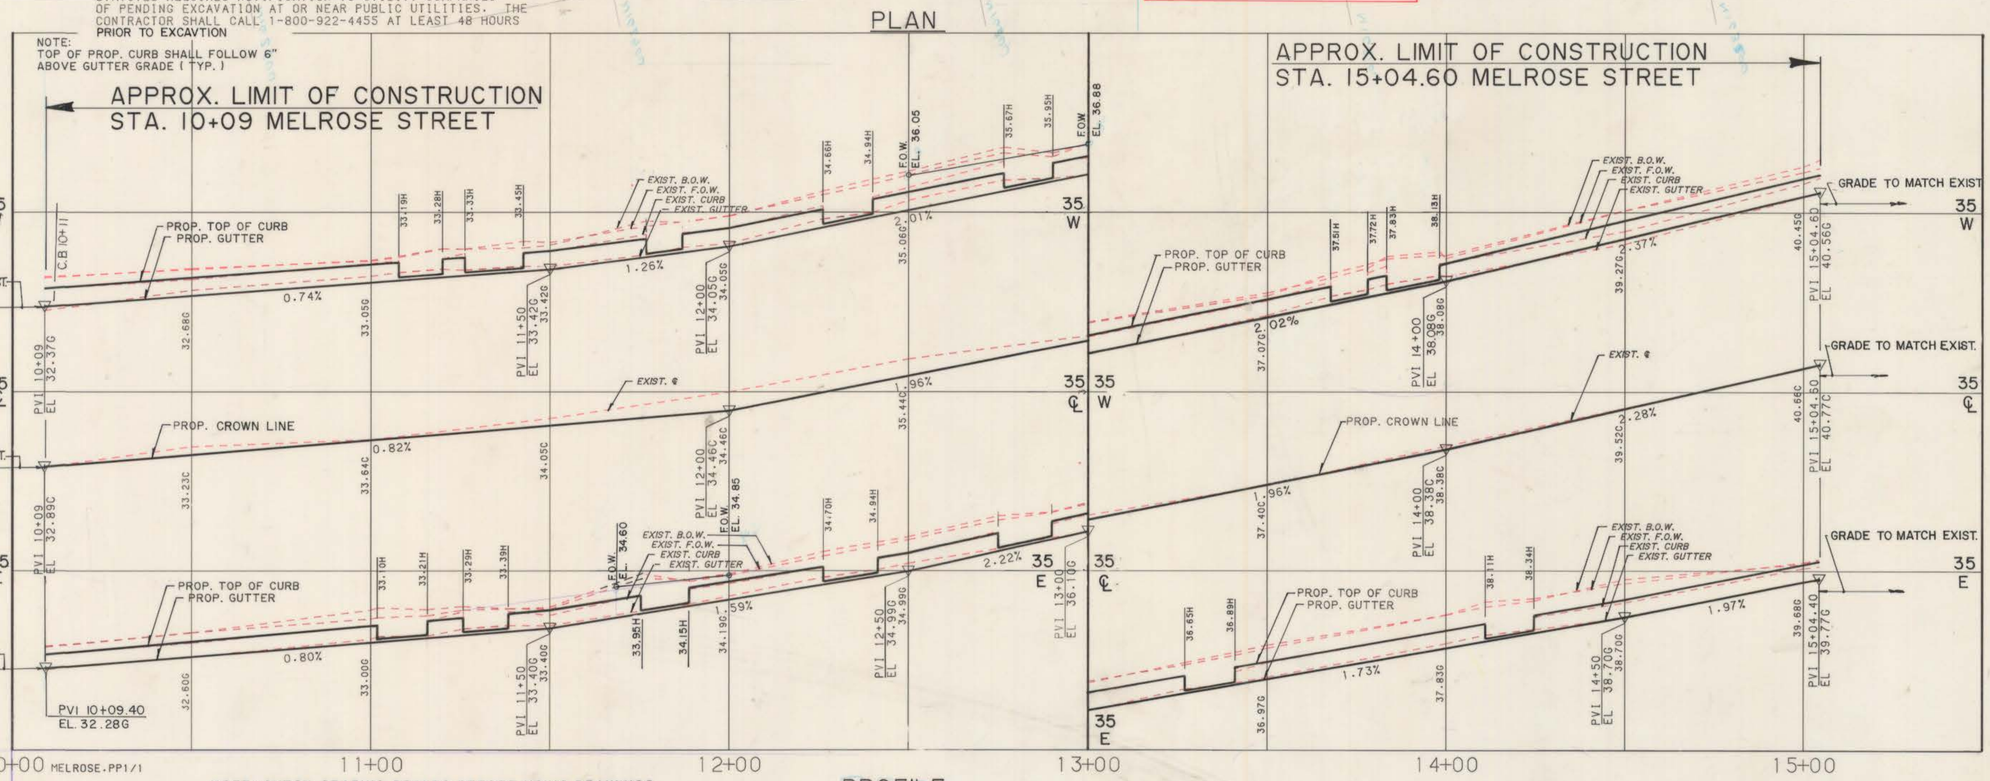

PROFILE

NOTE: CHECK GRAPHIC SCALES BEFORE USING DRAWINGS

NO.	DATE	DESCRIPTION
	NOV 86	AS BUILTS BY RJF CHECKED BY MCC

REVISIONS

SUPV. JAC
DESIGN MDH/AEC
DRAWN J.R. MOORE
CHECKED AEC
DATE 01·30·86

GRAPHIC SCALES
HORIZ. 1" = 20'
VERT. 1" = 2'

ROADWAY RECONSTRUCTION
HARTFORD, CONNECTICUT

STATE OF CONNECTICUT ALAN R. WEGMAN NO. 10606 REGISTERED PROFESSIONAL ENGINEER

Hayden | Wegman
Consulting Engineers
WEST HARTFORD
NEW YORK • BOSTON • BUFFALO
ATLANTA • MEMPHIS

CITY OF HARTFORD, CONNECTICUT
DEPARTMENT OF PUBLIC WORKS
BUREAU OF ENGINEERING SERVICES

DAYBOOK NO. 011012
DATE

MELROSE STREET
STA. 19+09 TO 15+04.60

PLAN AND PROFILE
Contract No. E86-9 Job No.- 852534

SHEET 2 OF 4