



RIM OR FRAME ELEVATIONS OF ALL UTILITY GATE BOXES, HANDHOLES, AND CATCH BASINS ARE TO BE ADJUSTED AS REQUIRED TO MATCH PROPOSED FINISHED PAVED SURFACES.

- (B) CONSTRUCT BIT. CONC. DRIVEWAY RAMP
- (C) SAWCUT BETWEEN EXISTING RAMPED SECTION AND ^{TO} SIDEWALK AND CONSTRUCT 8" REINF. CONC. DRIVEWAY RAMP
- (E) EXIST. DRIVEWAY RAMP TO REMAIN
- (S) CONSTRUCT 8" REINF. CONC. SIDEWALK

CALL BEFORE YOU DIG - THE CONTRACTOR IS HEREBY REMINDED
THAT TITLE 16 CHAPTER 293 OF THE CONN. CUT GENERAL
STATUTES REQUIRES NOTIFICATION TO UTILITY COMPANIES
OF PENDING EXCAVATION OR NEAR PUBLIC UTILITIES. THE
CONTRACTOR SHALL CALL 1-800-922-4455 AT LEAST 48 HOURS
PRIOR TO EXCAVATION.

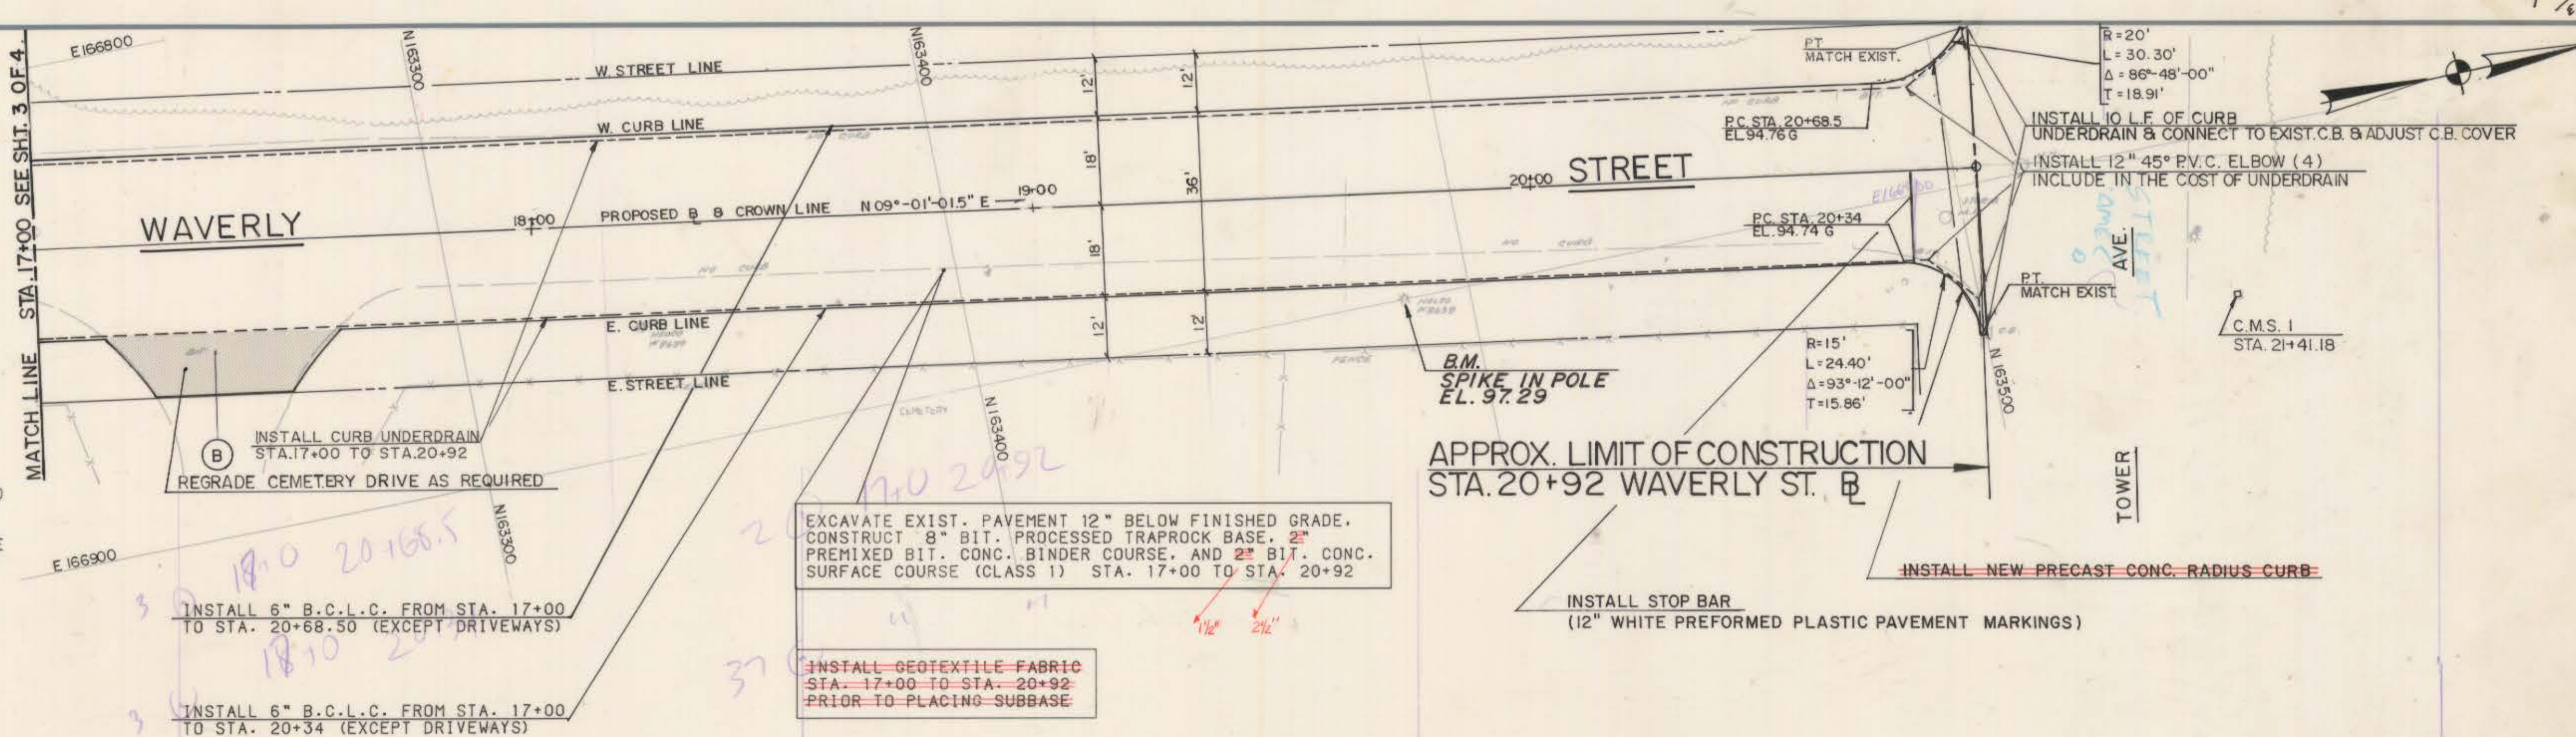

PLAN

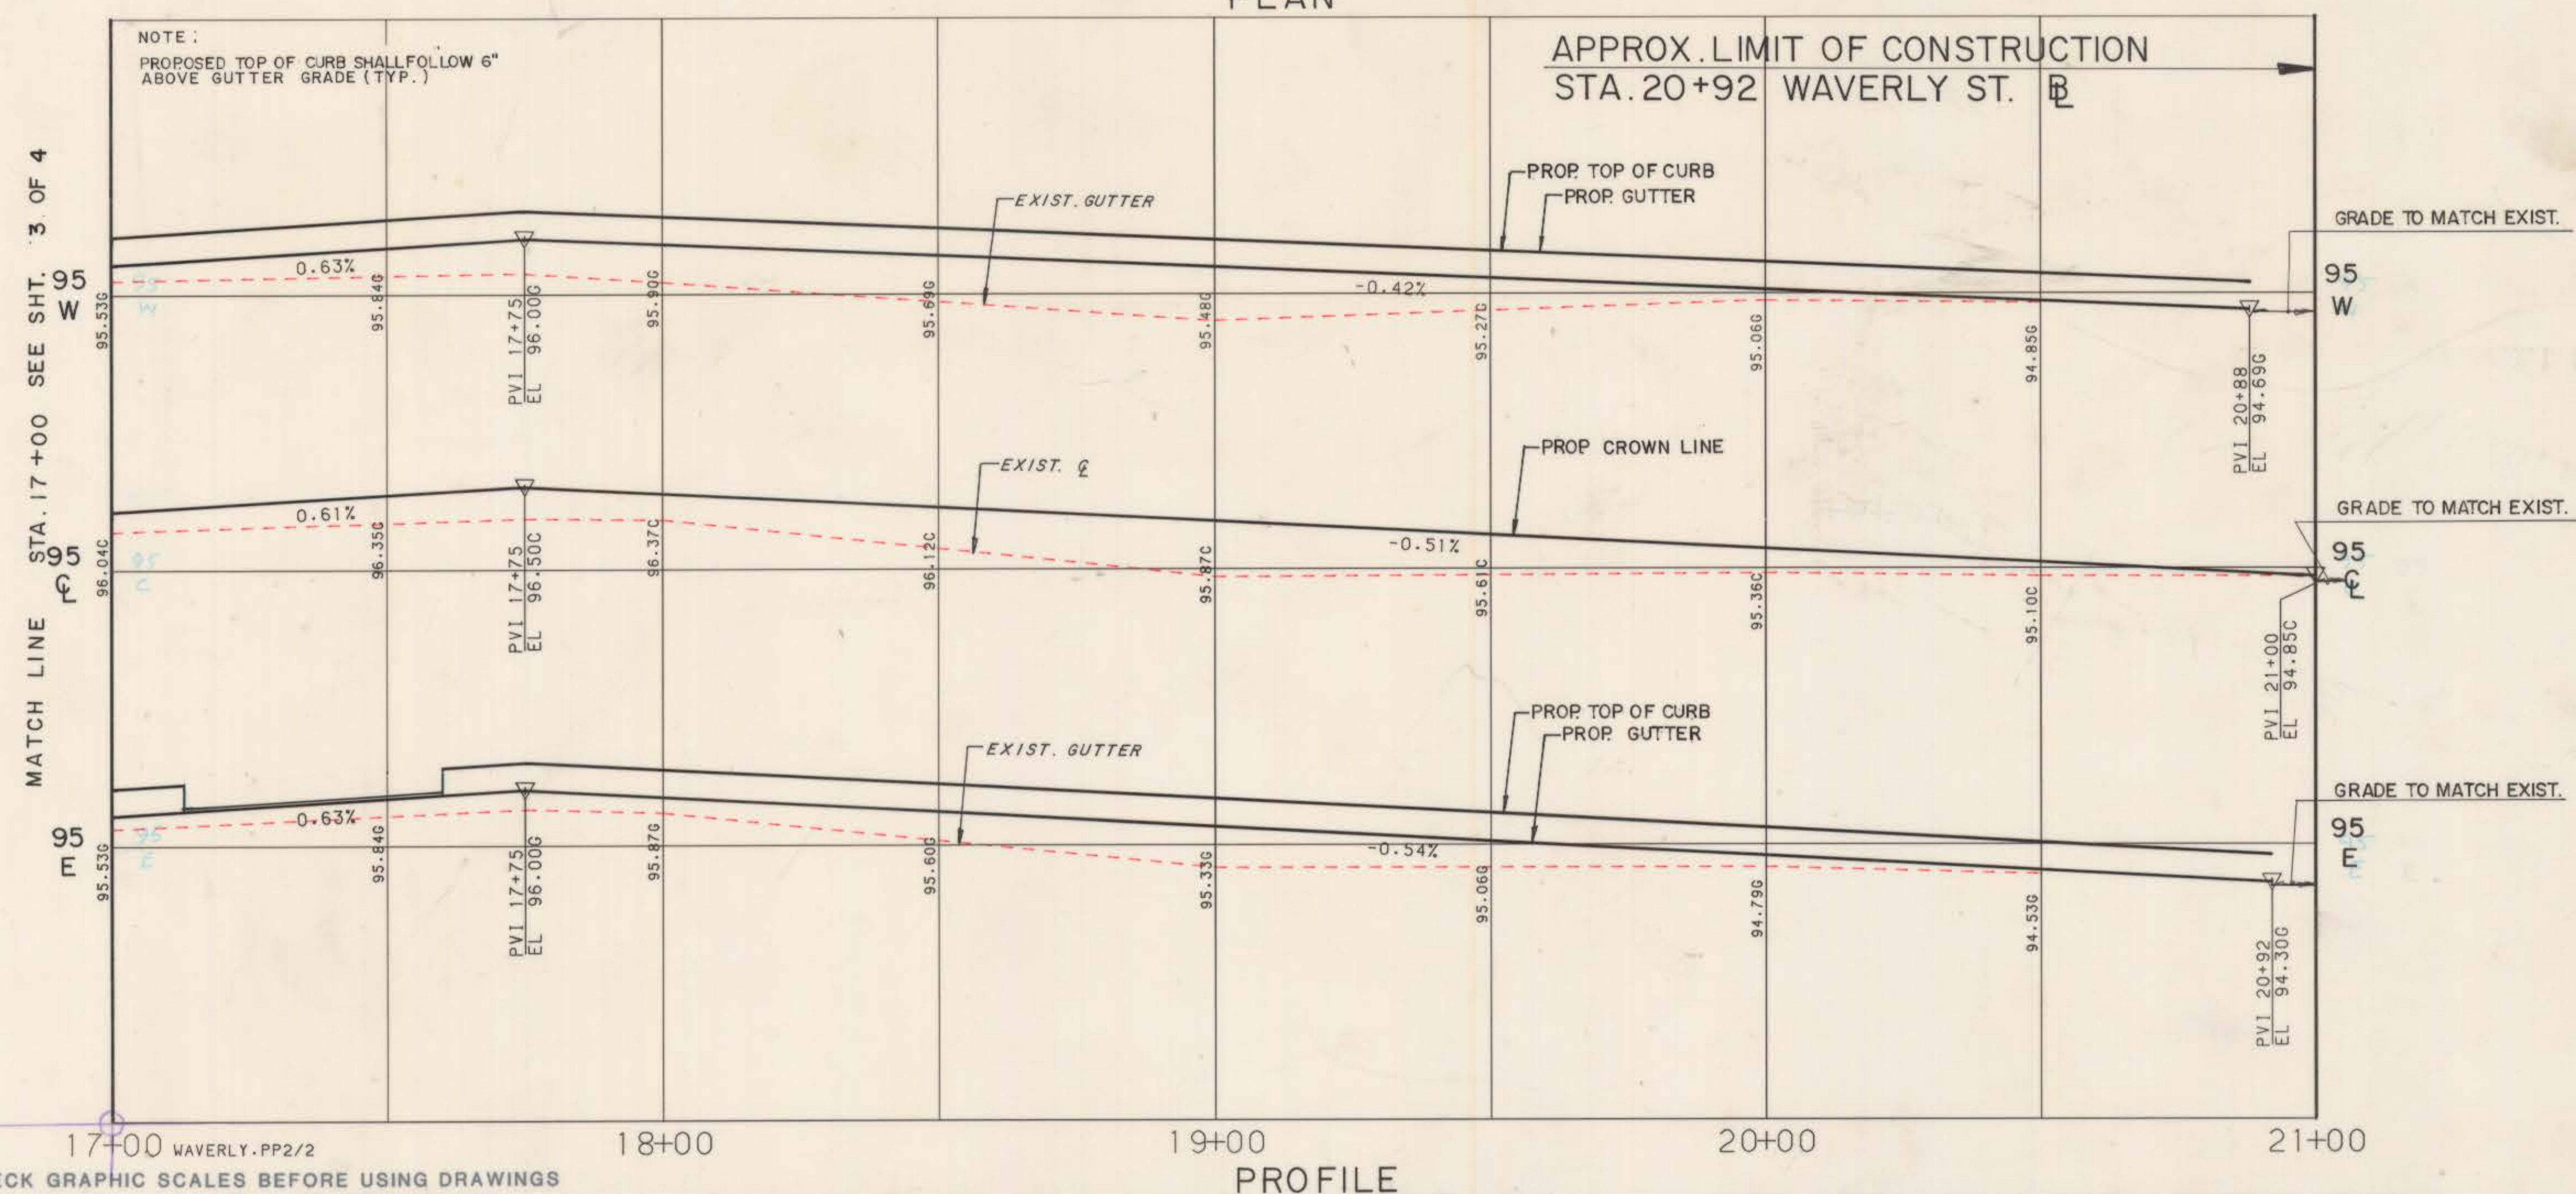

				SUPV. JAC	GRAPHIC SCALES		CITY OF HARTFORD, CONNECTICUT	WAVERLY STREET		
				DESIGN MDH/AEC	HORIZ. 1" = 20'	ROADWAY RECONSTRUCTION HARTFORD, CONNECTICUT	DEPARTMENT OF PUBLIC WORKS	STA. 17+00 TO STA. 20+92		
				DRAWN M J N	VERT. 1" = 2'			BUREAU OF ENGINEERING SERVICES		
				CHECKED AEC						
NO.	DATE	NOV 86	DESCRIPTION	DATE	01-30-86			DAYBOOK NO. 011012	PLAN AND PROFILE	
REVISIONS							DATE	Contract No. E 86 - 9	Job No. - 852534	SHEET 4
										OF 4