

# NOTES:

RIM OR FRAME ELEVATIONS OF ALL UTILITY GATE BOXES, HANDHOLES, AND CATCH BASINS ARE TO BE ADJUSTED AS REQUIRED TO MATCH PROPOSED FINISHED PAVED SURFACES.


(B) CONSTRUCT BIT. CONC. DRIVEWAY RAMP

(C) SAWCUT BETWEEN EXISTING RAMPED SECTION AND SIDEWALK AND CONSTRUCT 8" REINF. CONC. DRIVEWAY RAMP


(E) EXIST. DRIVEWAY RAMP TO REMAIN

(S) CONSTRUCT 8" REINF. CONC. SIDEWALK

CALL BEFORE YOU DIG - THE CONTRACTOR IS HEREBY REMINDED THAT TITLE 16 CHAPTER 293 OF THE CONNECTICUT GENERAL STATUTES REQUIRES NOTIFICATION TO UTILITY COMPANIES OF PENDING EXCAVATION AT OR NEAR PUBLIC UTILITIES. THE CONTRACTOR SHALL CALL 1-800-922-4455 AT LEAST 48 HOURS PRIOR TO EXCAVATION.

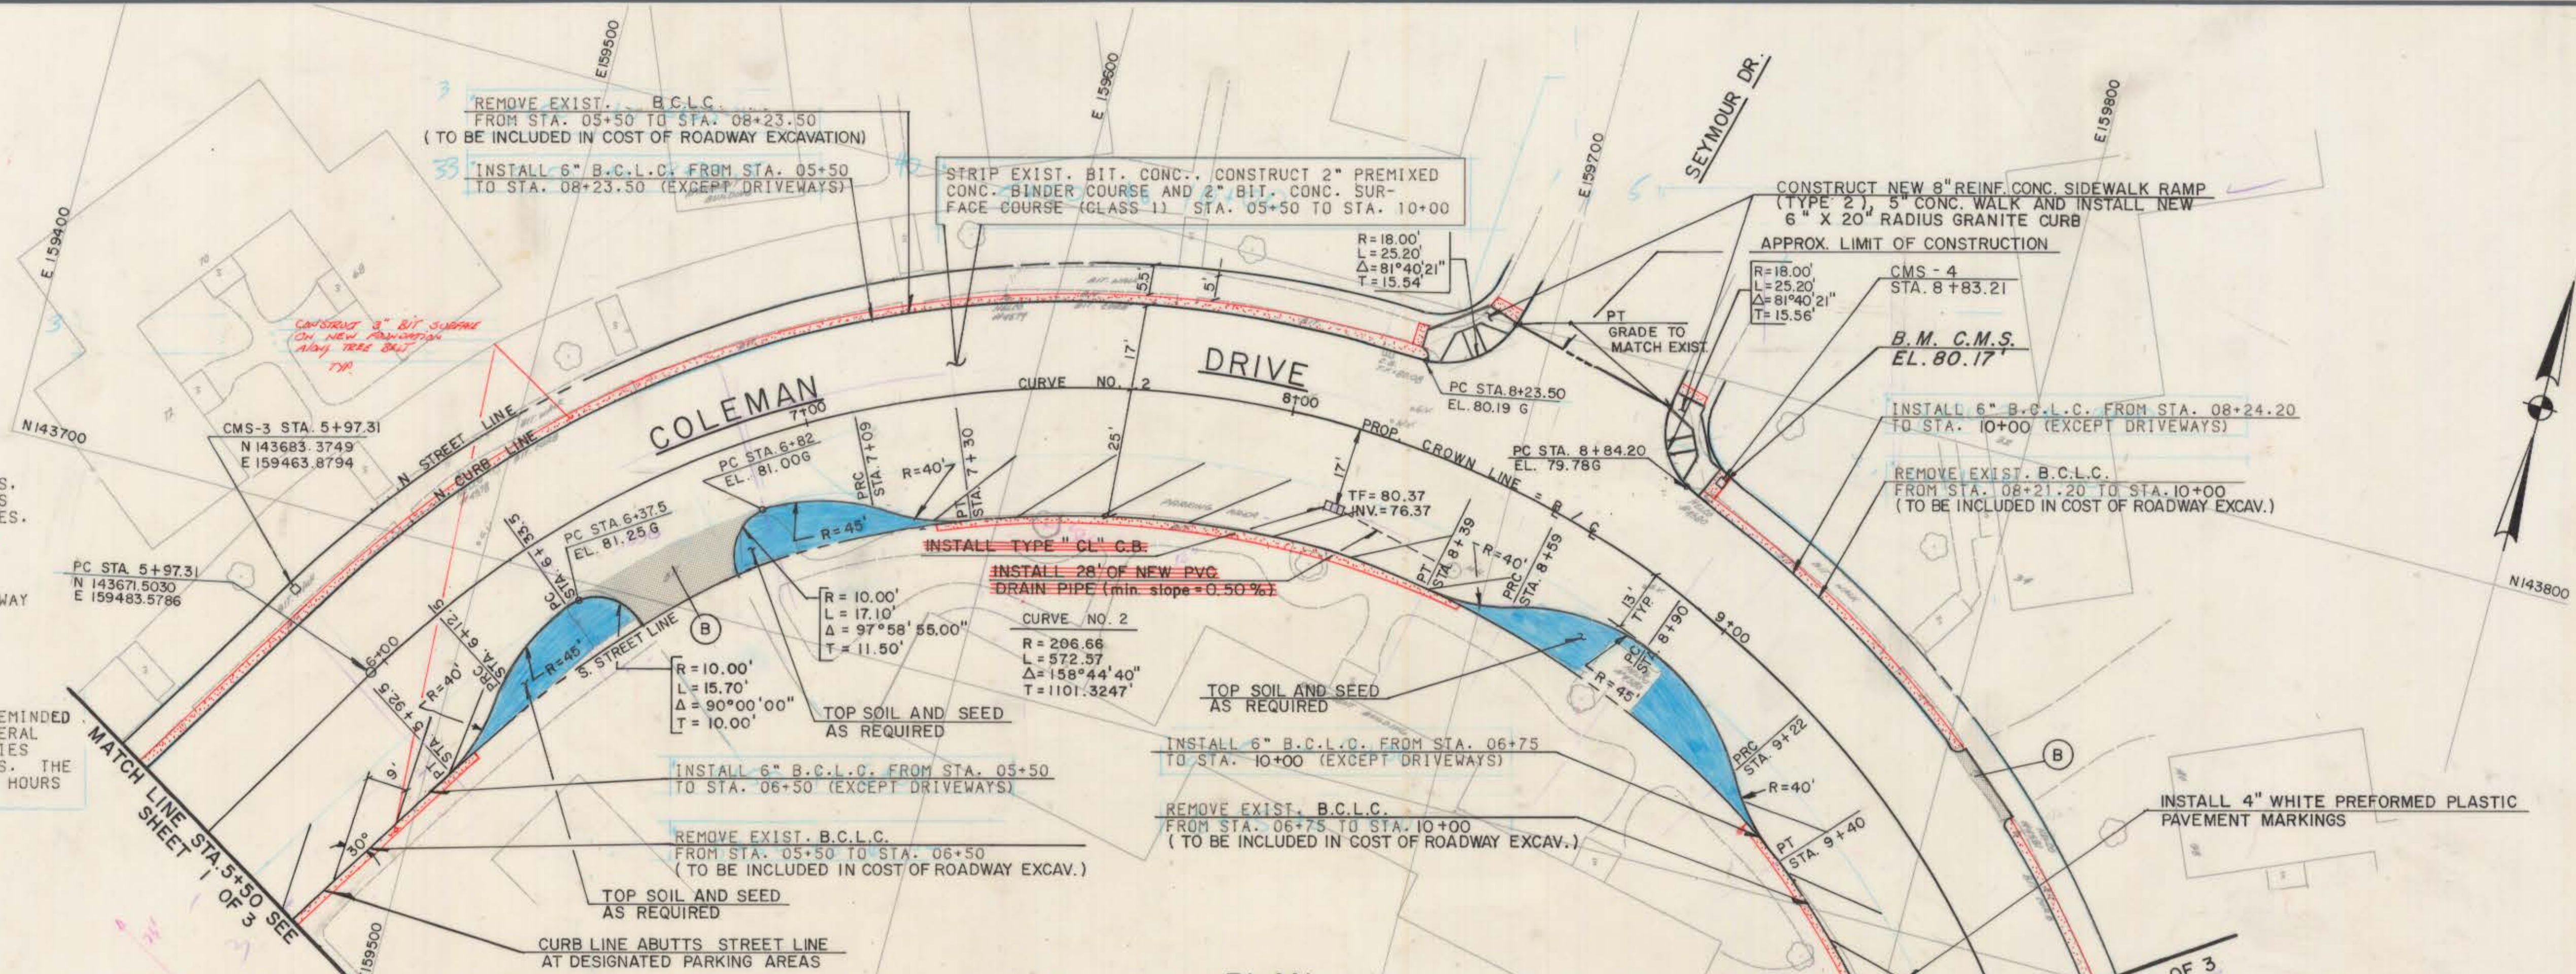

PLAN

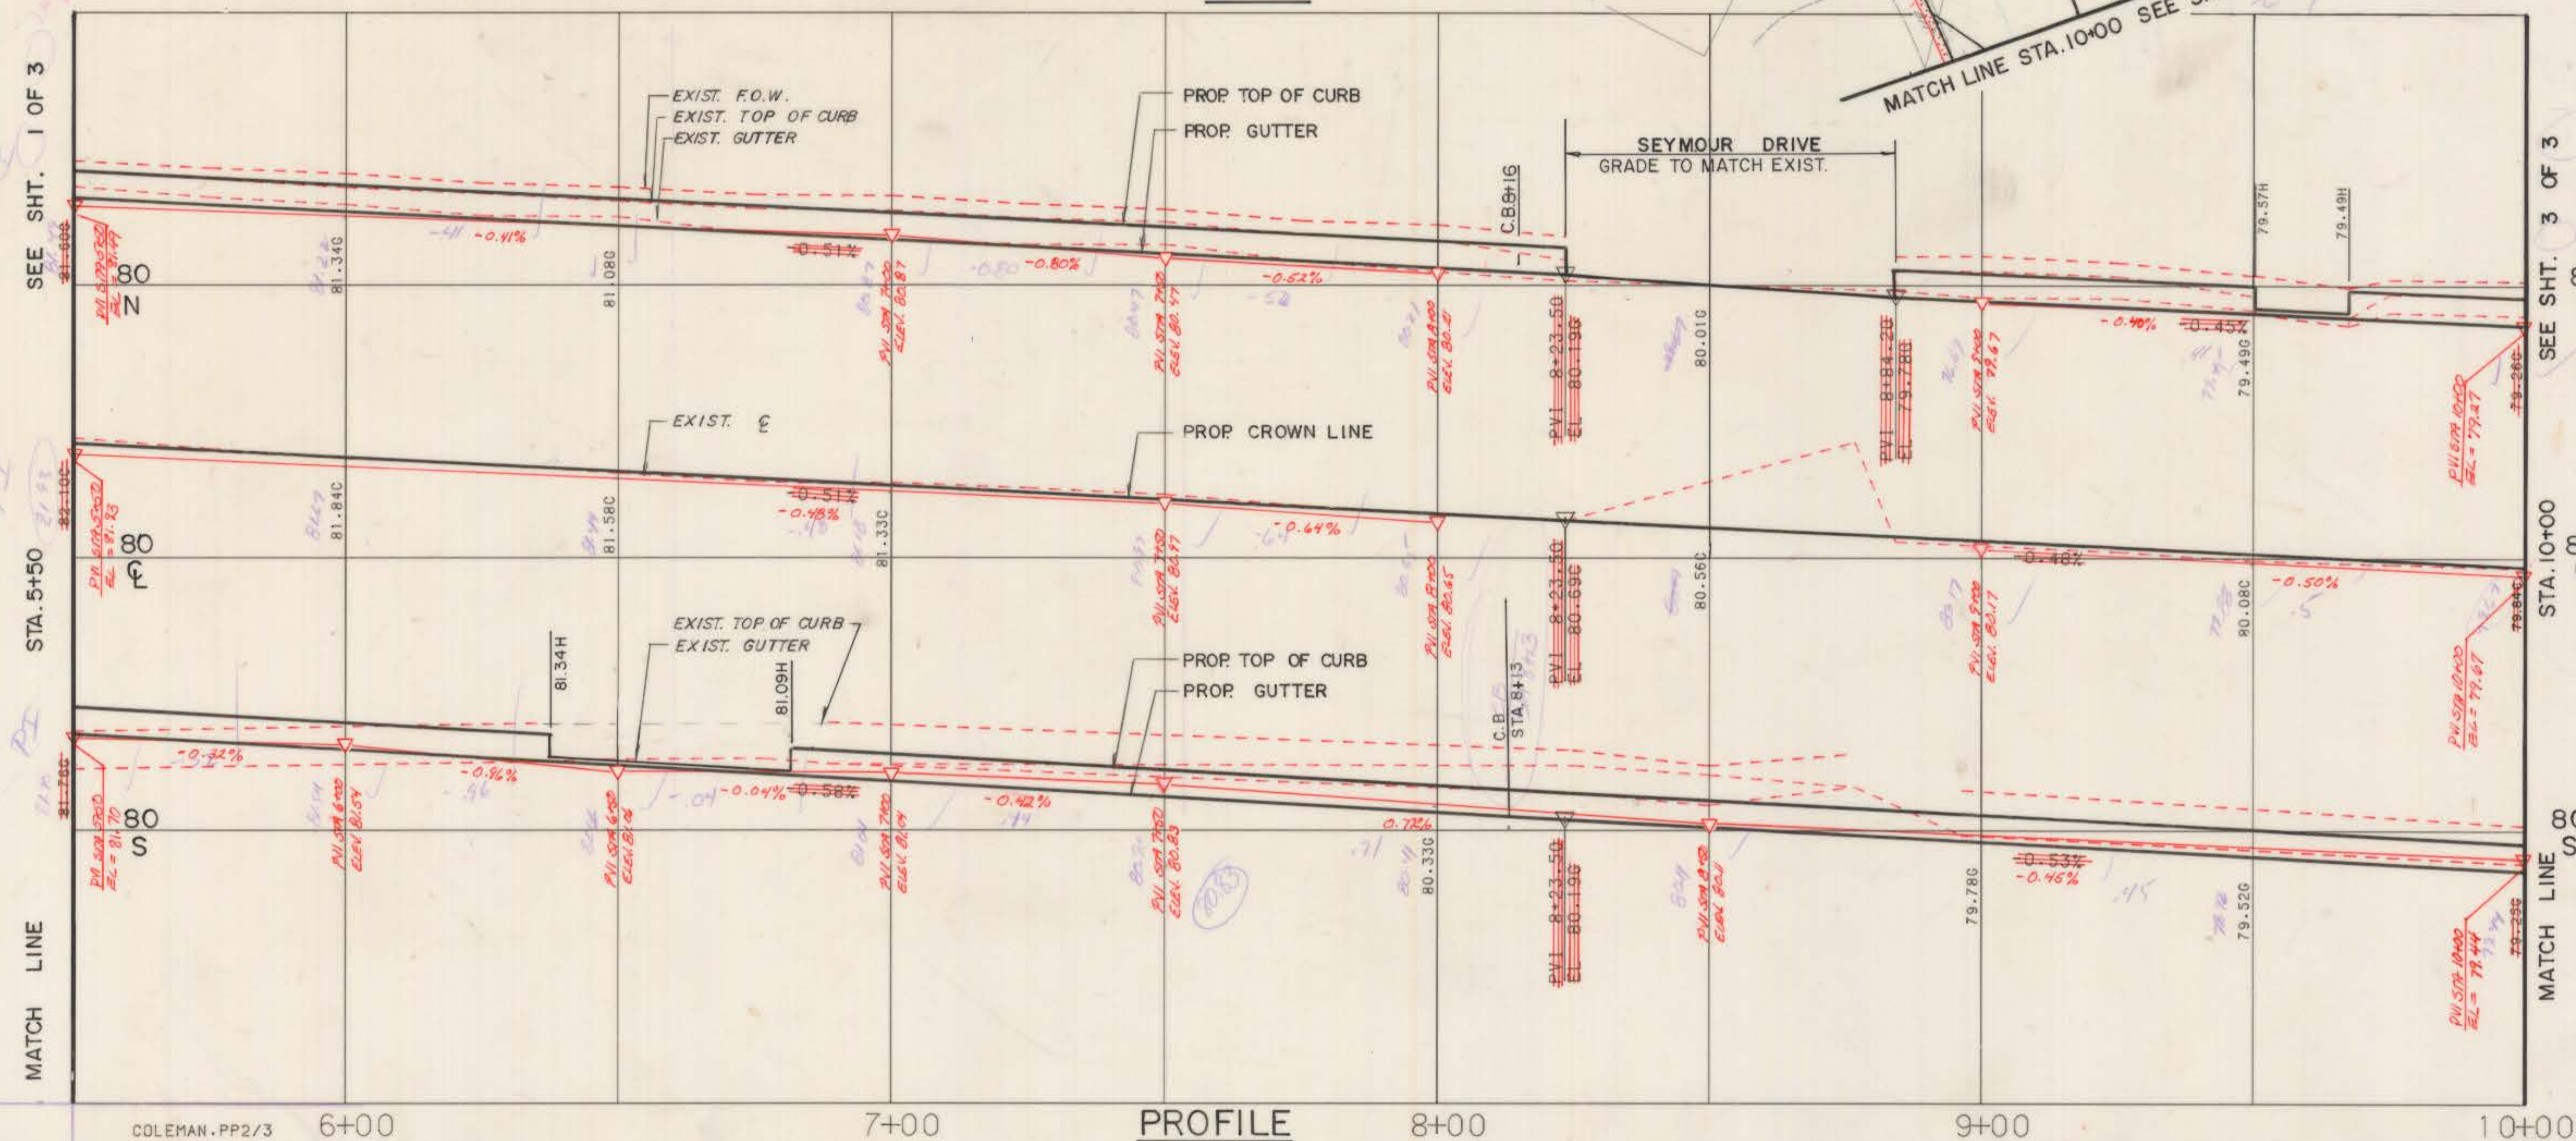

PROFILE

NOTE: CHECK GRAPHIC SCALES BEFORE USING DRAWINGS

NOTE: PROPOSED TOP OF CURB SHALL FOLLOW 6\"/>

|     |         |             |
|-----|---------|-------------|
| NO. | DATE    | DESCRIPTION |
| 1   | 3/10/86 | REVISIONS   |

|         |               |
|---------|---------------|
| SUPV.   | J.A.C.        |
| DESIGN  | M.D.H./A.E.C. |
| DRAWN   | M.J.N.        |
| CHECKED | A.E.C.        |
| DATE    | 3/10/86       |



**Hayden | Wegman**  
Consulting Engineers

WEST HARTFORD  
NEW YORK • BOSTON • BUFFALO  
ATLANTA • MEMPHIS

CITY OF HARTFORD, CONNECTICUT  
DEPARTMENT OF PUBLIC WORKS  
BUREAU OF ENGINEERING SERVICES

DAYBOOK NO. 011014  
DATE

COLEMAN DRIVE  
STA. 5+50 TO STA. 10+00

**PLAN AND PROFILE**

Contract No. E86-11 Job No. 852534

SHEET 2 OF 3