



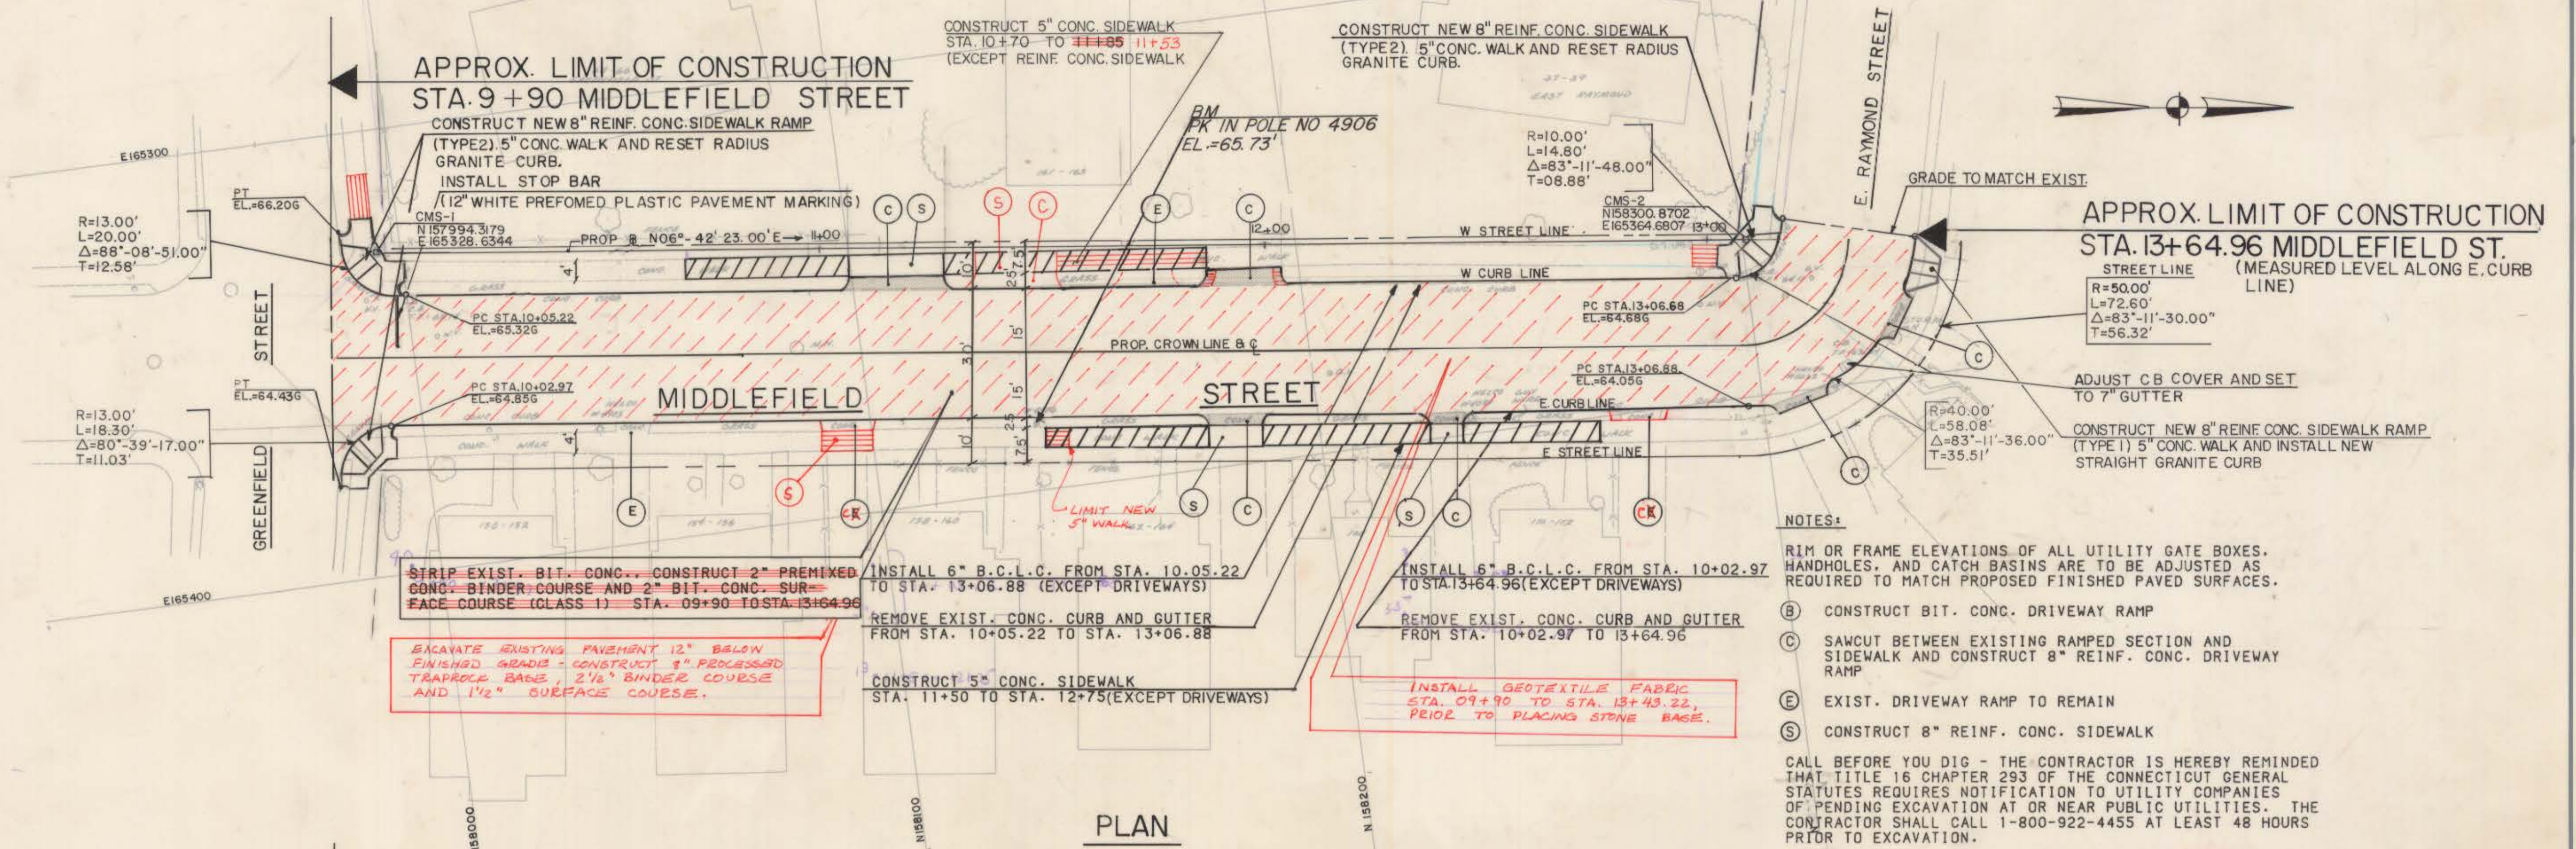

APPROX. LIMIT OF CONSTRUCTION
STA. 9+90 MIDDLEFIELD STREET

APPROX. LIMIT OF CONSTRUCTION
STA. 13+64.96 MIDDLEFIELD STREET

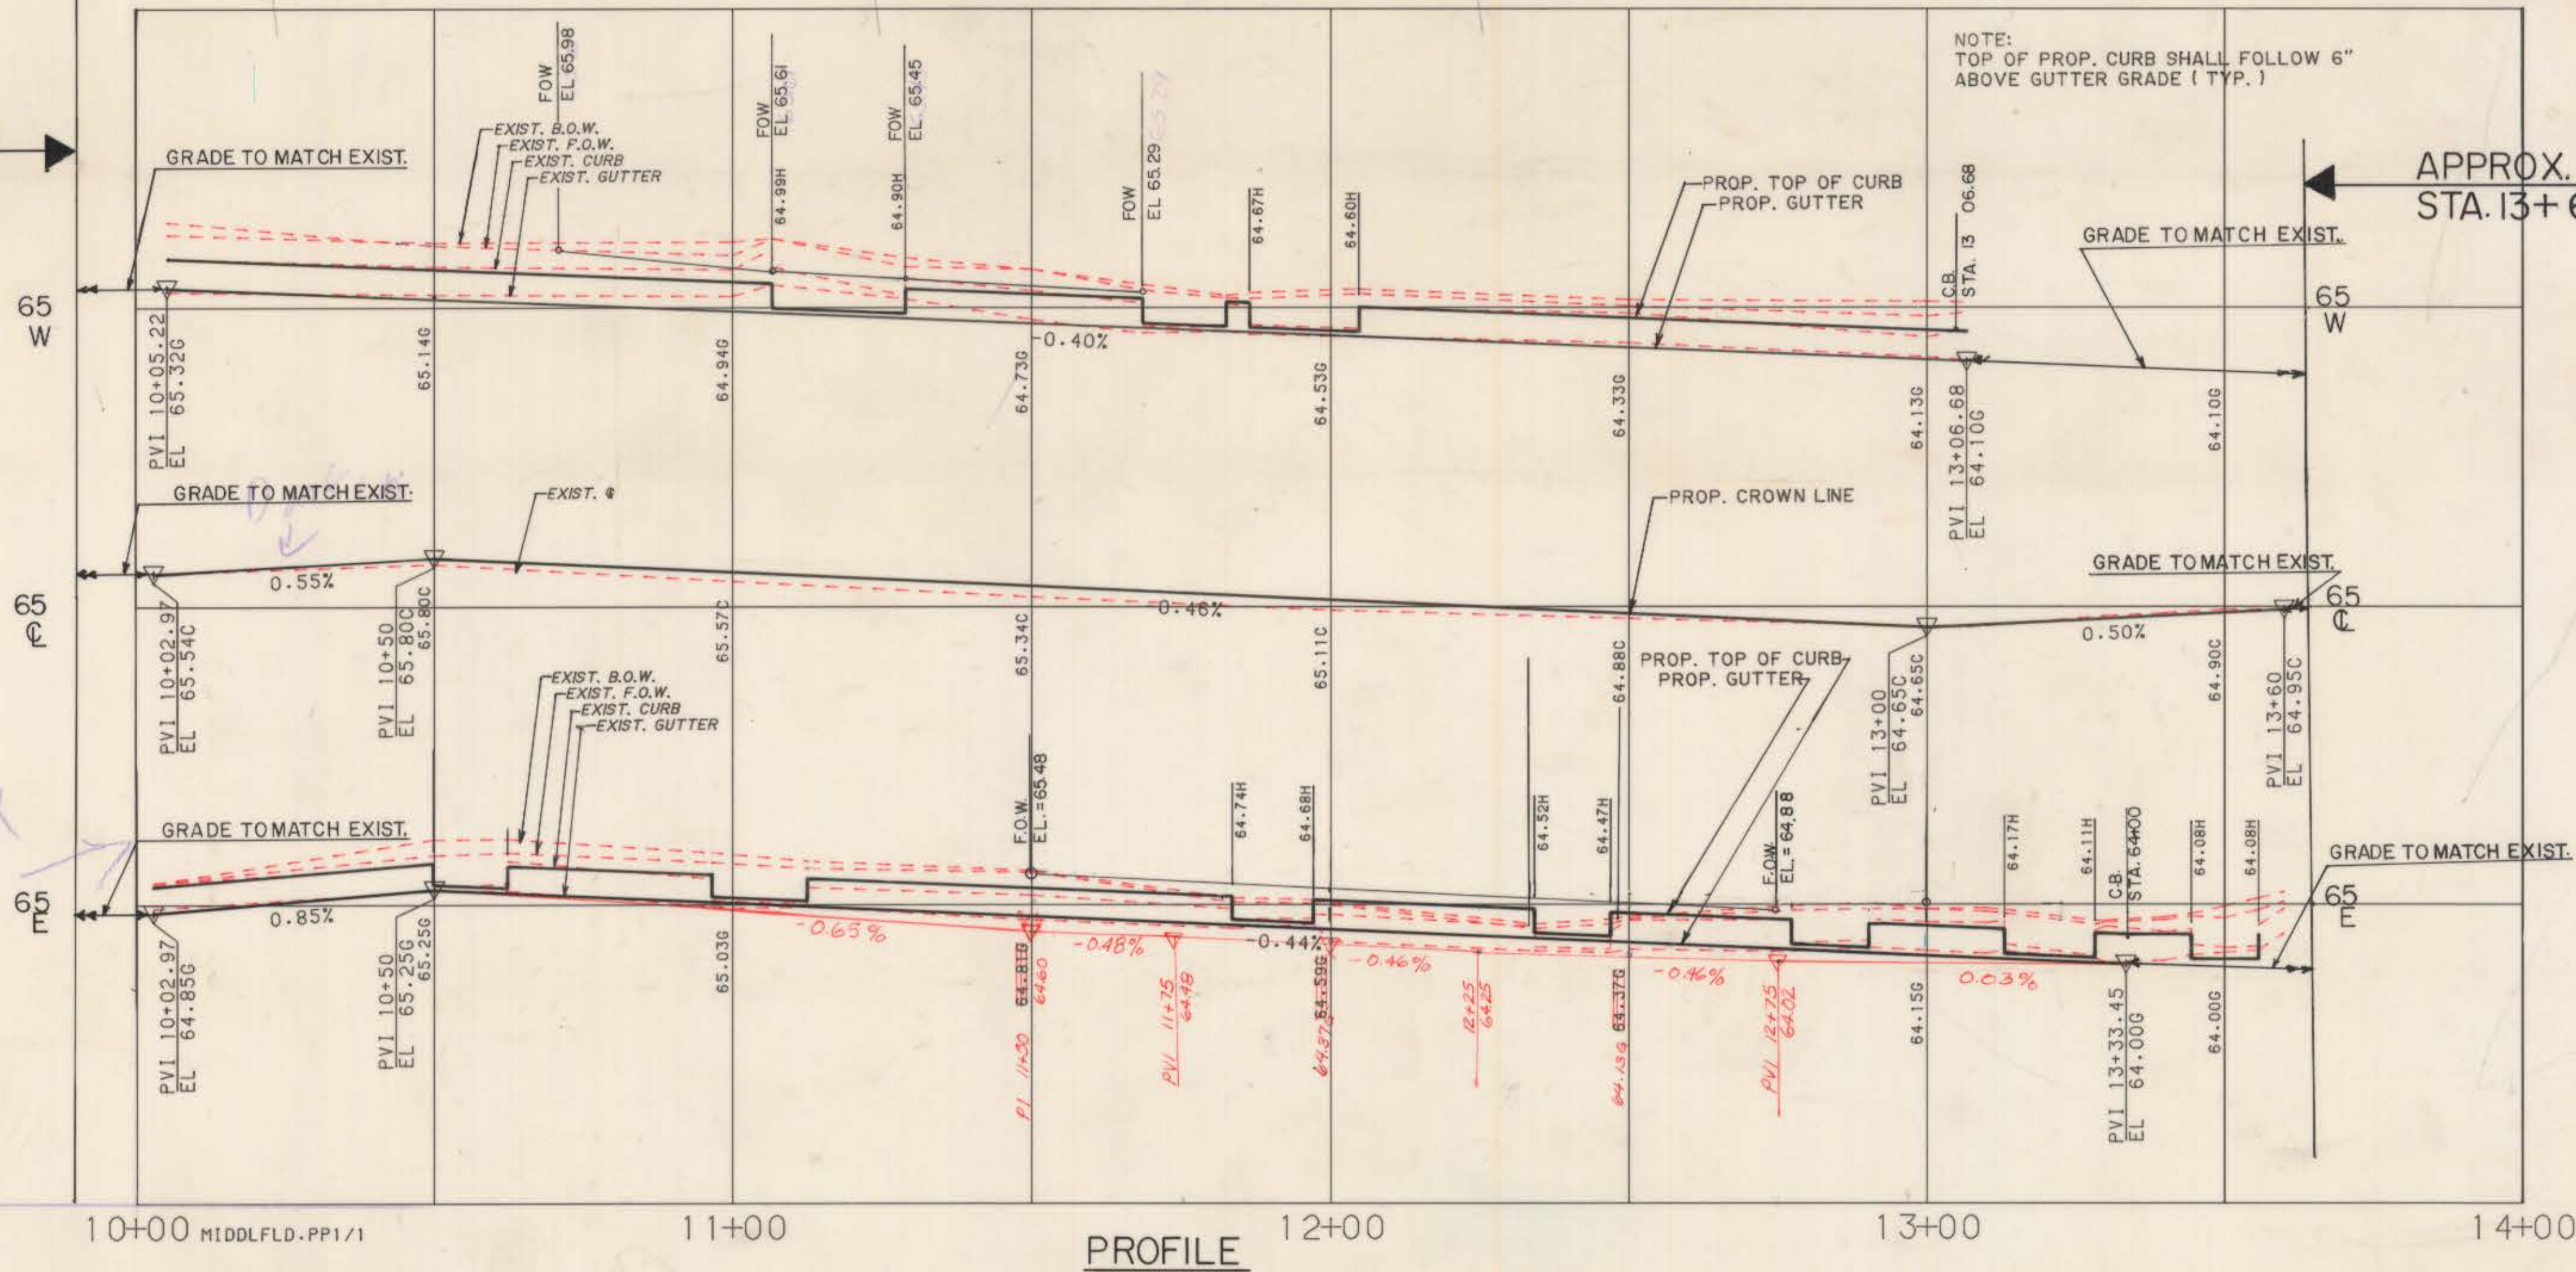

NO. DATE DESCRIPTION REVISIONS	SUPV. JAC DESIGN MDH/AEC DRAWN AEC CHECKED AEC DATE 02-19-86	GRAPHIC SCALES HORIZ. 1"=20' VERT. 1"=2' ROADWAY RECONSTRUCTION HARTFORD, CONNECTICUT	Hayden Wegman Consulting Engineers WEST HARTFORD NEW YORK • BOSTON • BUFFALO ATLANTA • MEMPHIS	CITY OF HARTFORD, CONNECTICUT DEPARTMENT OF PUBLIC WORKS BUREAU OF ENGINEERING SERVICES DAYBOOK NO. 010105 DATE	MIDDLEFIELD STREET STA. 9+90 TO STA. 13+64.96 PLAN AND PROFILE Job No. 852534 SHEET 4 OF 4
--	---	---	---	---	--