

NOTES:

INSTALL 6' OF 6"x20" GRANITE CURB ON EACH SIDE OF CATCH BASIN WHERE INSTALLING BITUMINOUS CONCRETE LIP CURBING

- (B) CONSTRUCT BITUMINOUS CONCRETE DRIVEWAY RAMP
- (C) CONSTRUCT 8" REINFORCED CONCRETE DRIVEWAY RAMP
- (E) EXISTING DRIVEWAY RAMP TO REMAIN

CALL BEFORE YOU DIG - THE CONTRACTOR IS HEREBY REMINDED THAT TITLE 16 CHAPTER 293 OF THE CONNECTICUT GENERAL STATUTES REQUIRES NOTIFICATION TO UTILITY COMPANIES OF PENDING EXCAVATION AT OR NEAR PUBLIC UTILITIES. THE CONTRACTOR SHALL CALL 1-800-922-4455 AT LEAST 48 HOURS PRIOR TO EXCAVATION.


APPROXIMATE LIMIT OF CONSTRUCTION
STA. 12+91 BRANFORD STREET

N 163148.0148
E 159838.6638

EXCAVATE EXISTING PAVEMENT 12" BELOW FINISHED GRADE, CONSTRUCT 8" PROCESSED TRAPROCK SUBBASE, 2 1/2" PREMIXED BIT. CONC. BASE, AND 1 1/2" BIT. CONC. SURFACE COURSE (CLASS II) STA. 12+91 TO STA. 17+00

BM
CMS AT NE CORNER
BRANFORD STREET & GRANBY STREET
ELEV. = 67.530

BM
4" CUT, S. BOLT
OF HYDRANT IN
BETWEEN NO. 312
AND NO. 320
ELEV. = 80.16

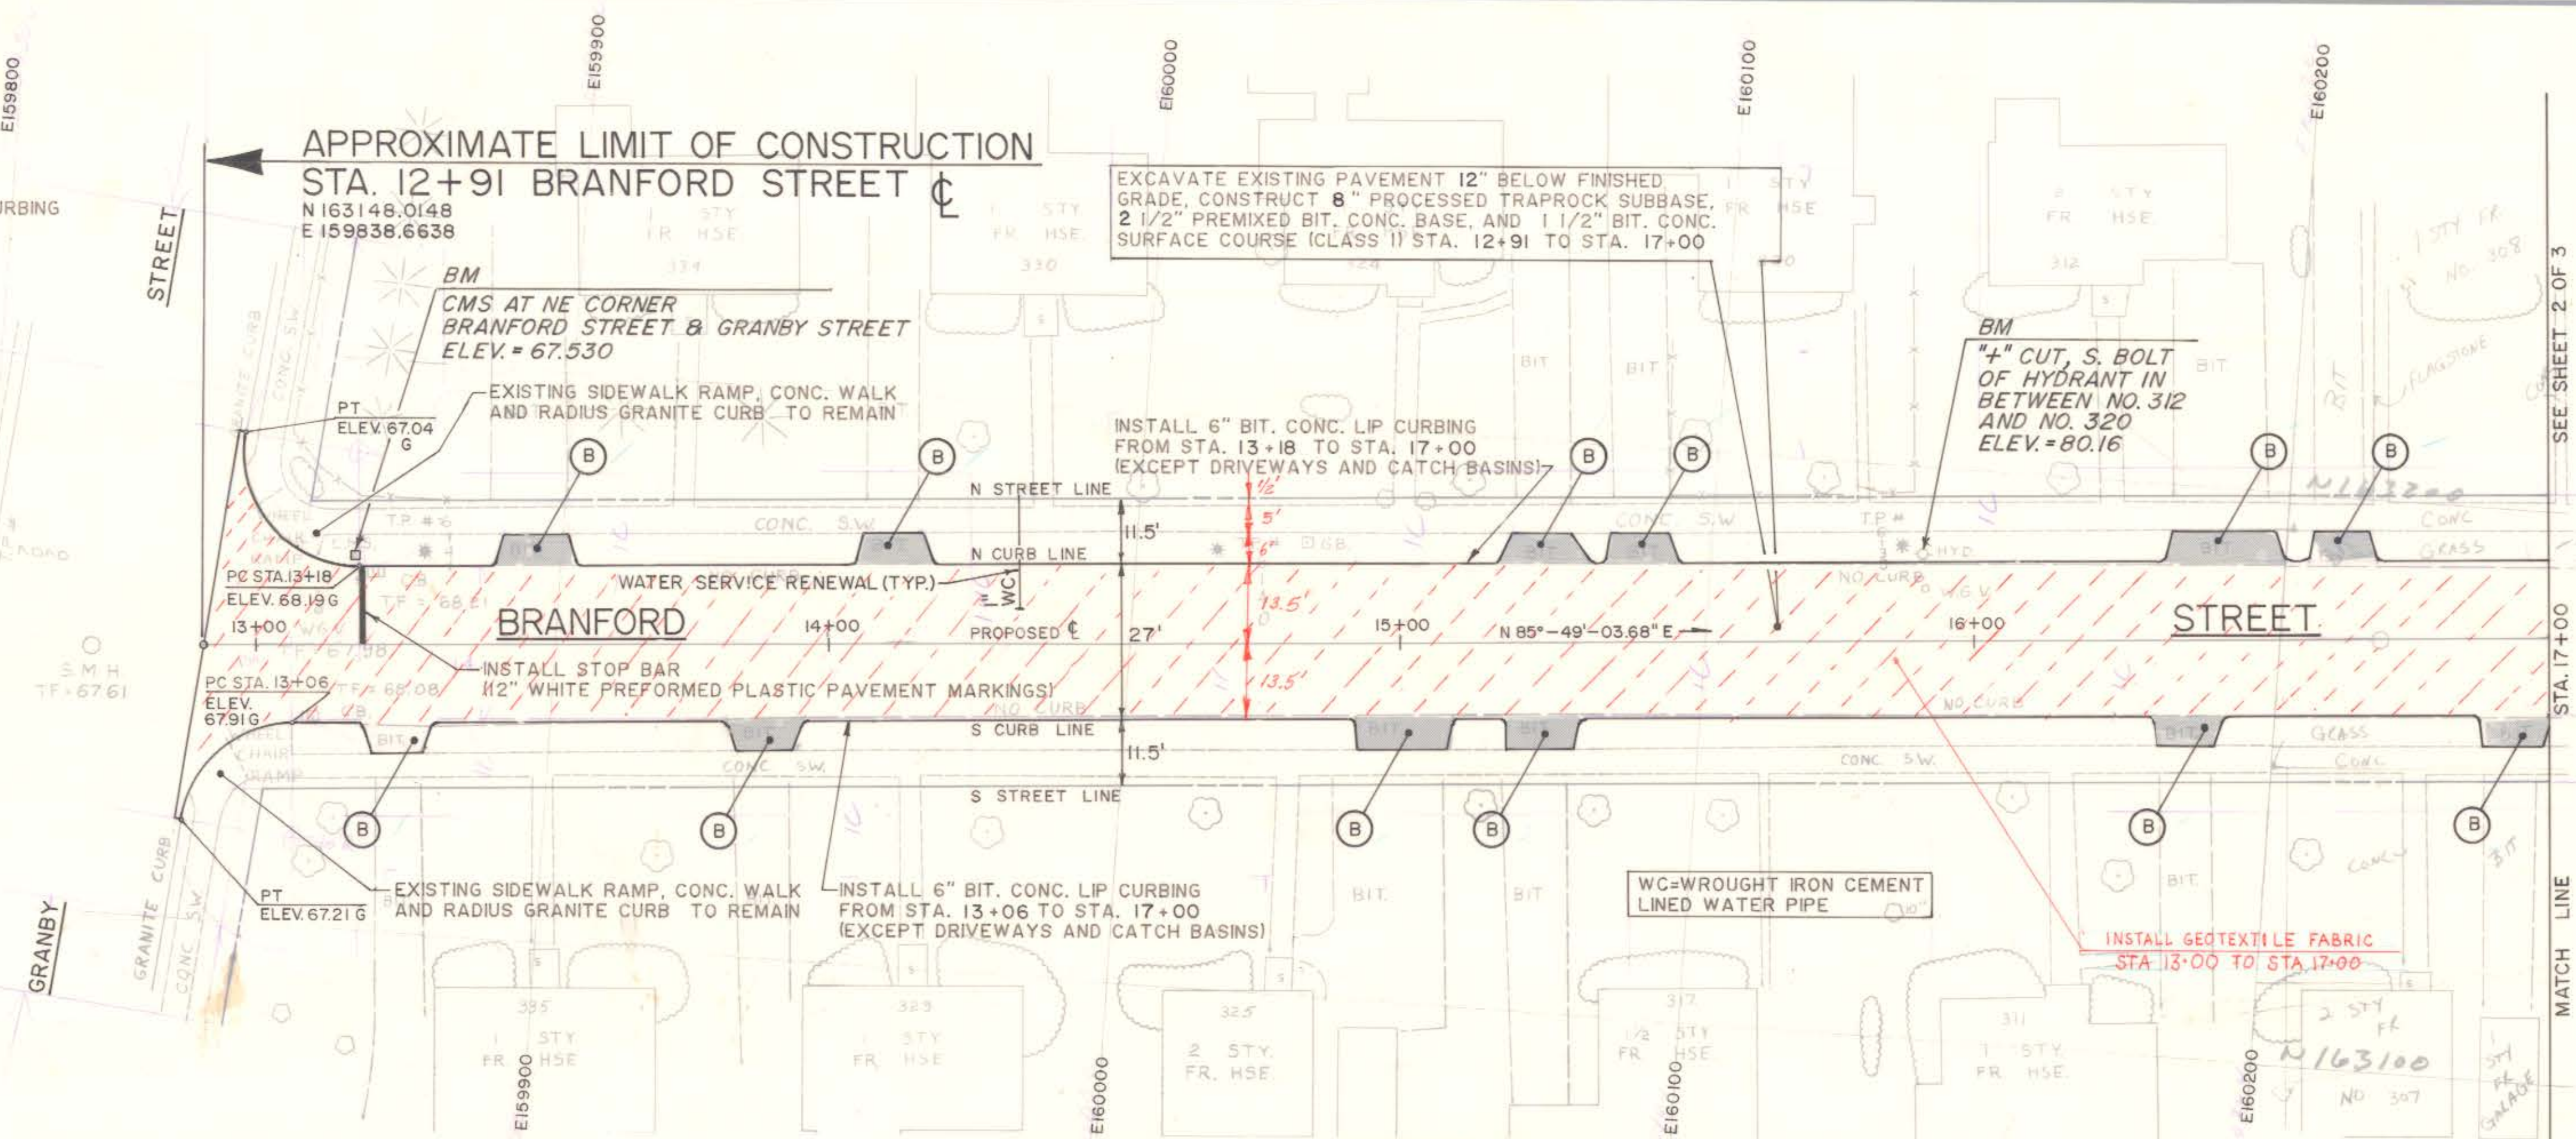


PLAN

APPROXIMATE LIMIT OF CONSTRUCTION
STA. 12+91 BRANFORD STREET

70 N

70 C

70 S

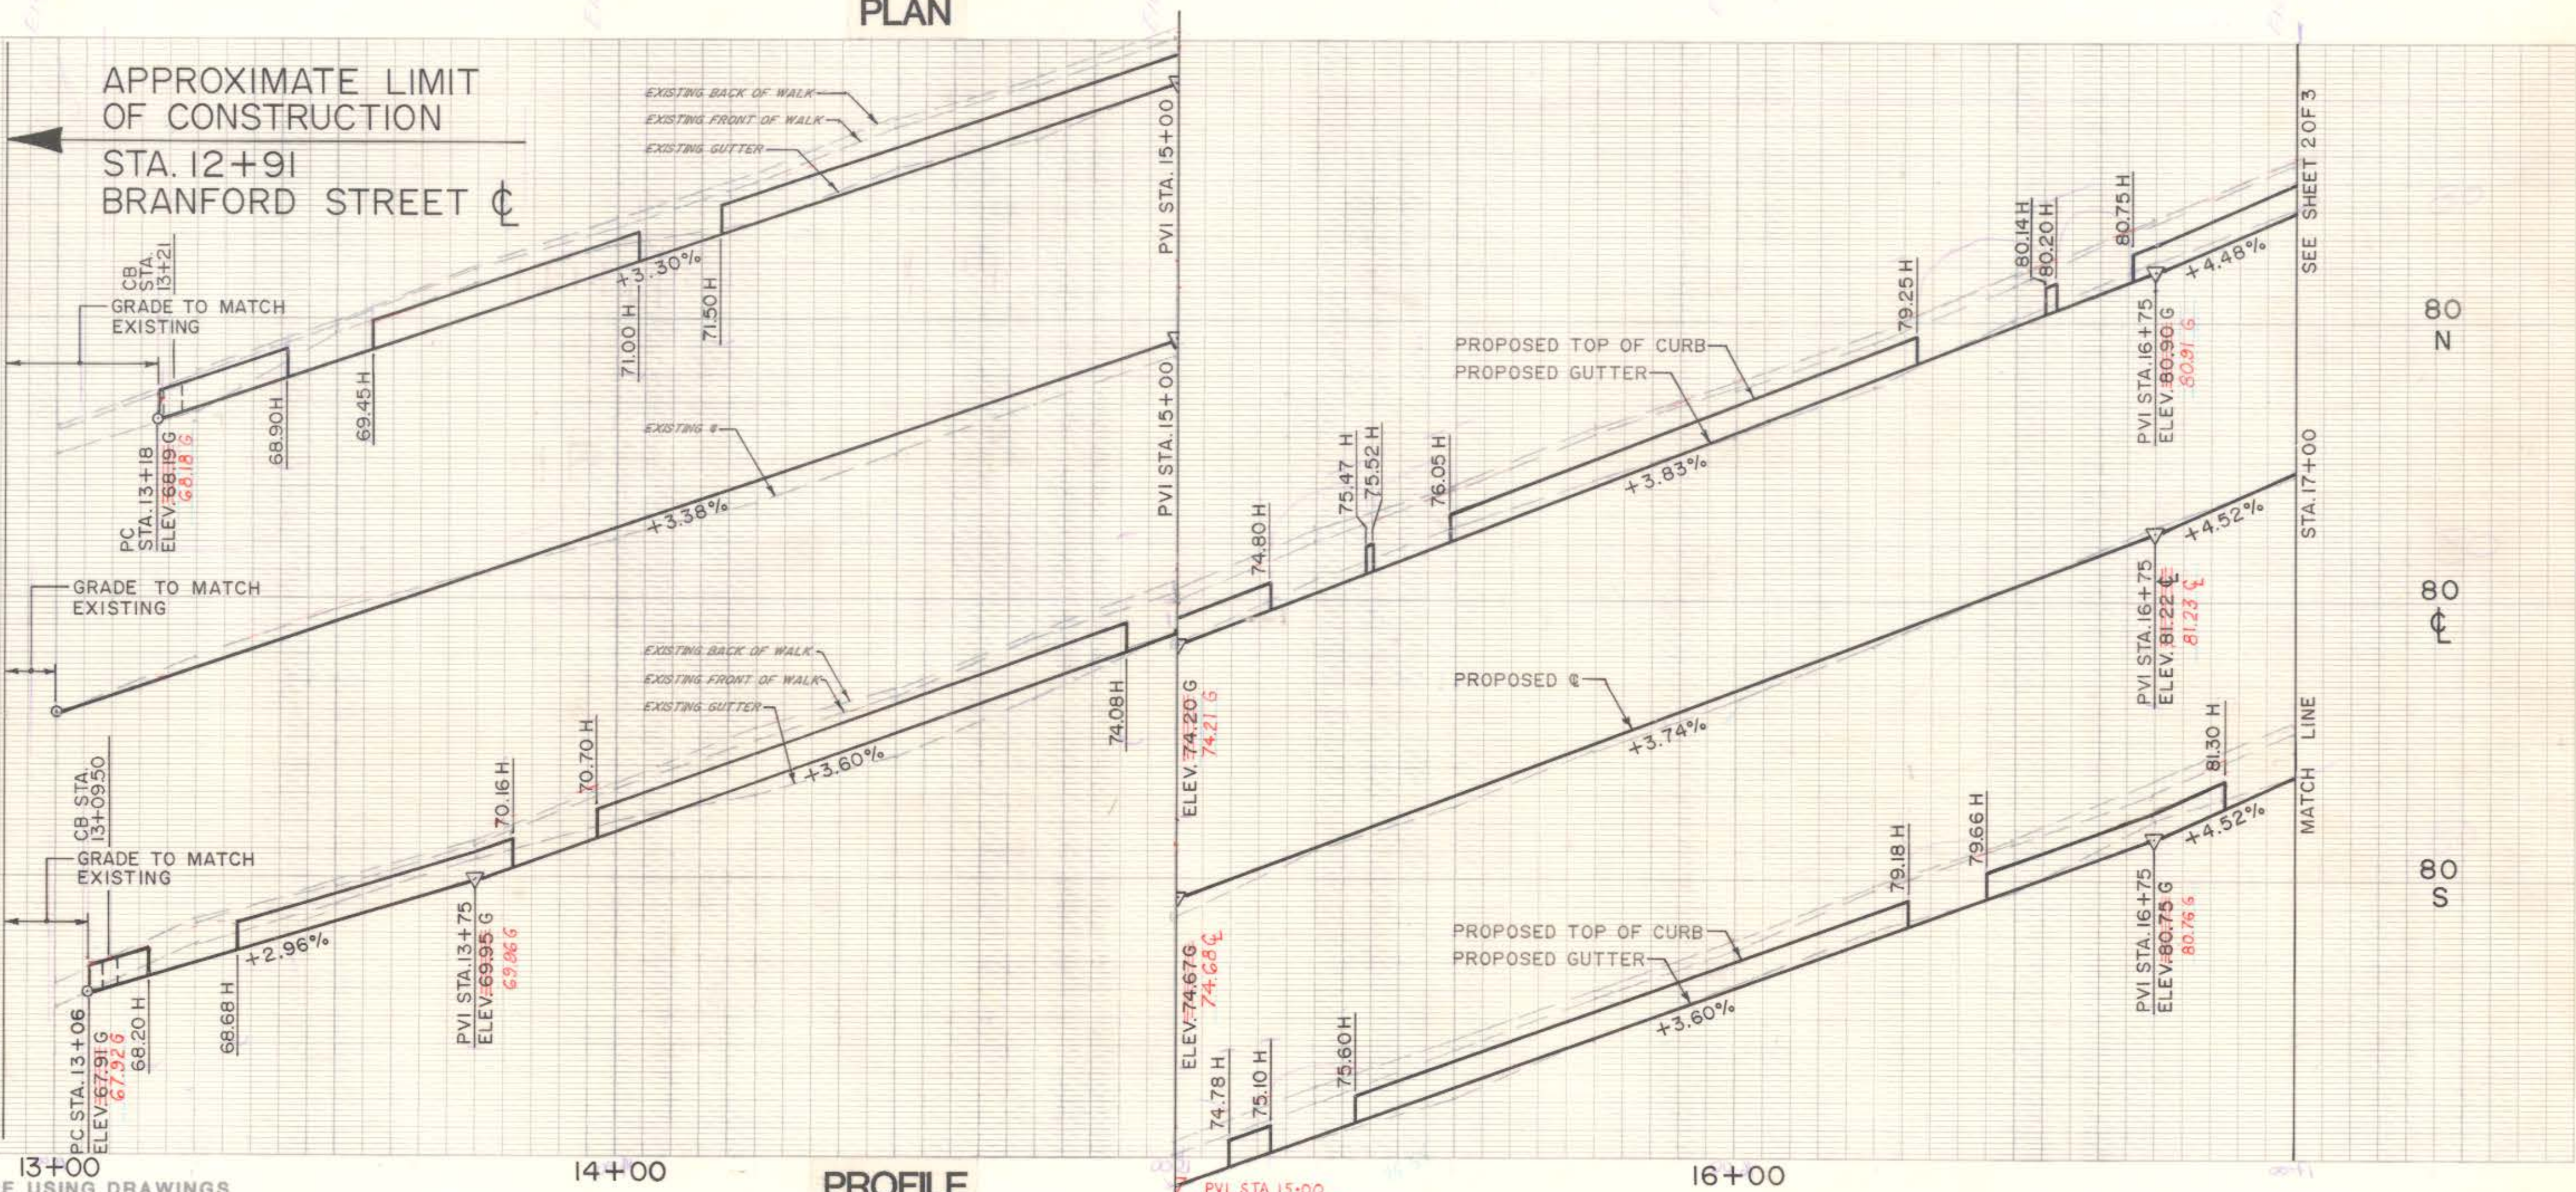

PROFILE

NOTE: CHECK GRAPHIC SCALES BEFORE USING DRAWINGS

NO.	DATE	DESCRIPTION
1	10/31/87	ADD GEO-TEX DRAFTED BY JAC
2	11/10/87	CHECKED BY JAC
3	11/10/87	NOTED BY JAC

SUPV.	APW
DESIGN	MDH/AEC
DRAWN	JAC
CHECKED	JAC
DATE	6-17-85

GRAPHIC SCALES
HORIZ. 1" = 20'
VERT. 1" = 2'

ROADWAY RECONSTRUCTION
HARTFORD, CONNECTICUT



Hayden | Wegman
Consulting Engineers

WEST HARTFORD
NEW YORK • BOSTON • BUFFALO
ATLANTA • MEMPHIS

CITY OF HARTFORD, CONNECTICUT
DEPARTMENT OF PUBLIC WORKS
BUREAU OF ENGINEERING SERVICES

DRAWN _____
CHECKED _____
SCALE _____
DAYBOOK NO. 010948
DATE _____

BRANFORD STREET

STA. 12-91 TO STA. 17-00

PLAN AND PROFILE

Contract # E85-29 Job No. 845304 OF 3

575/1A