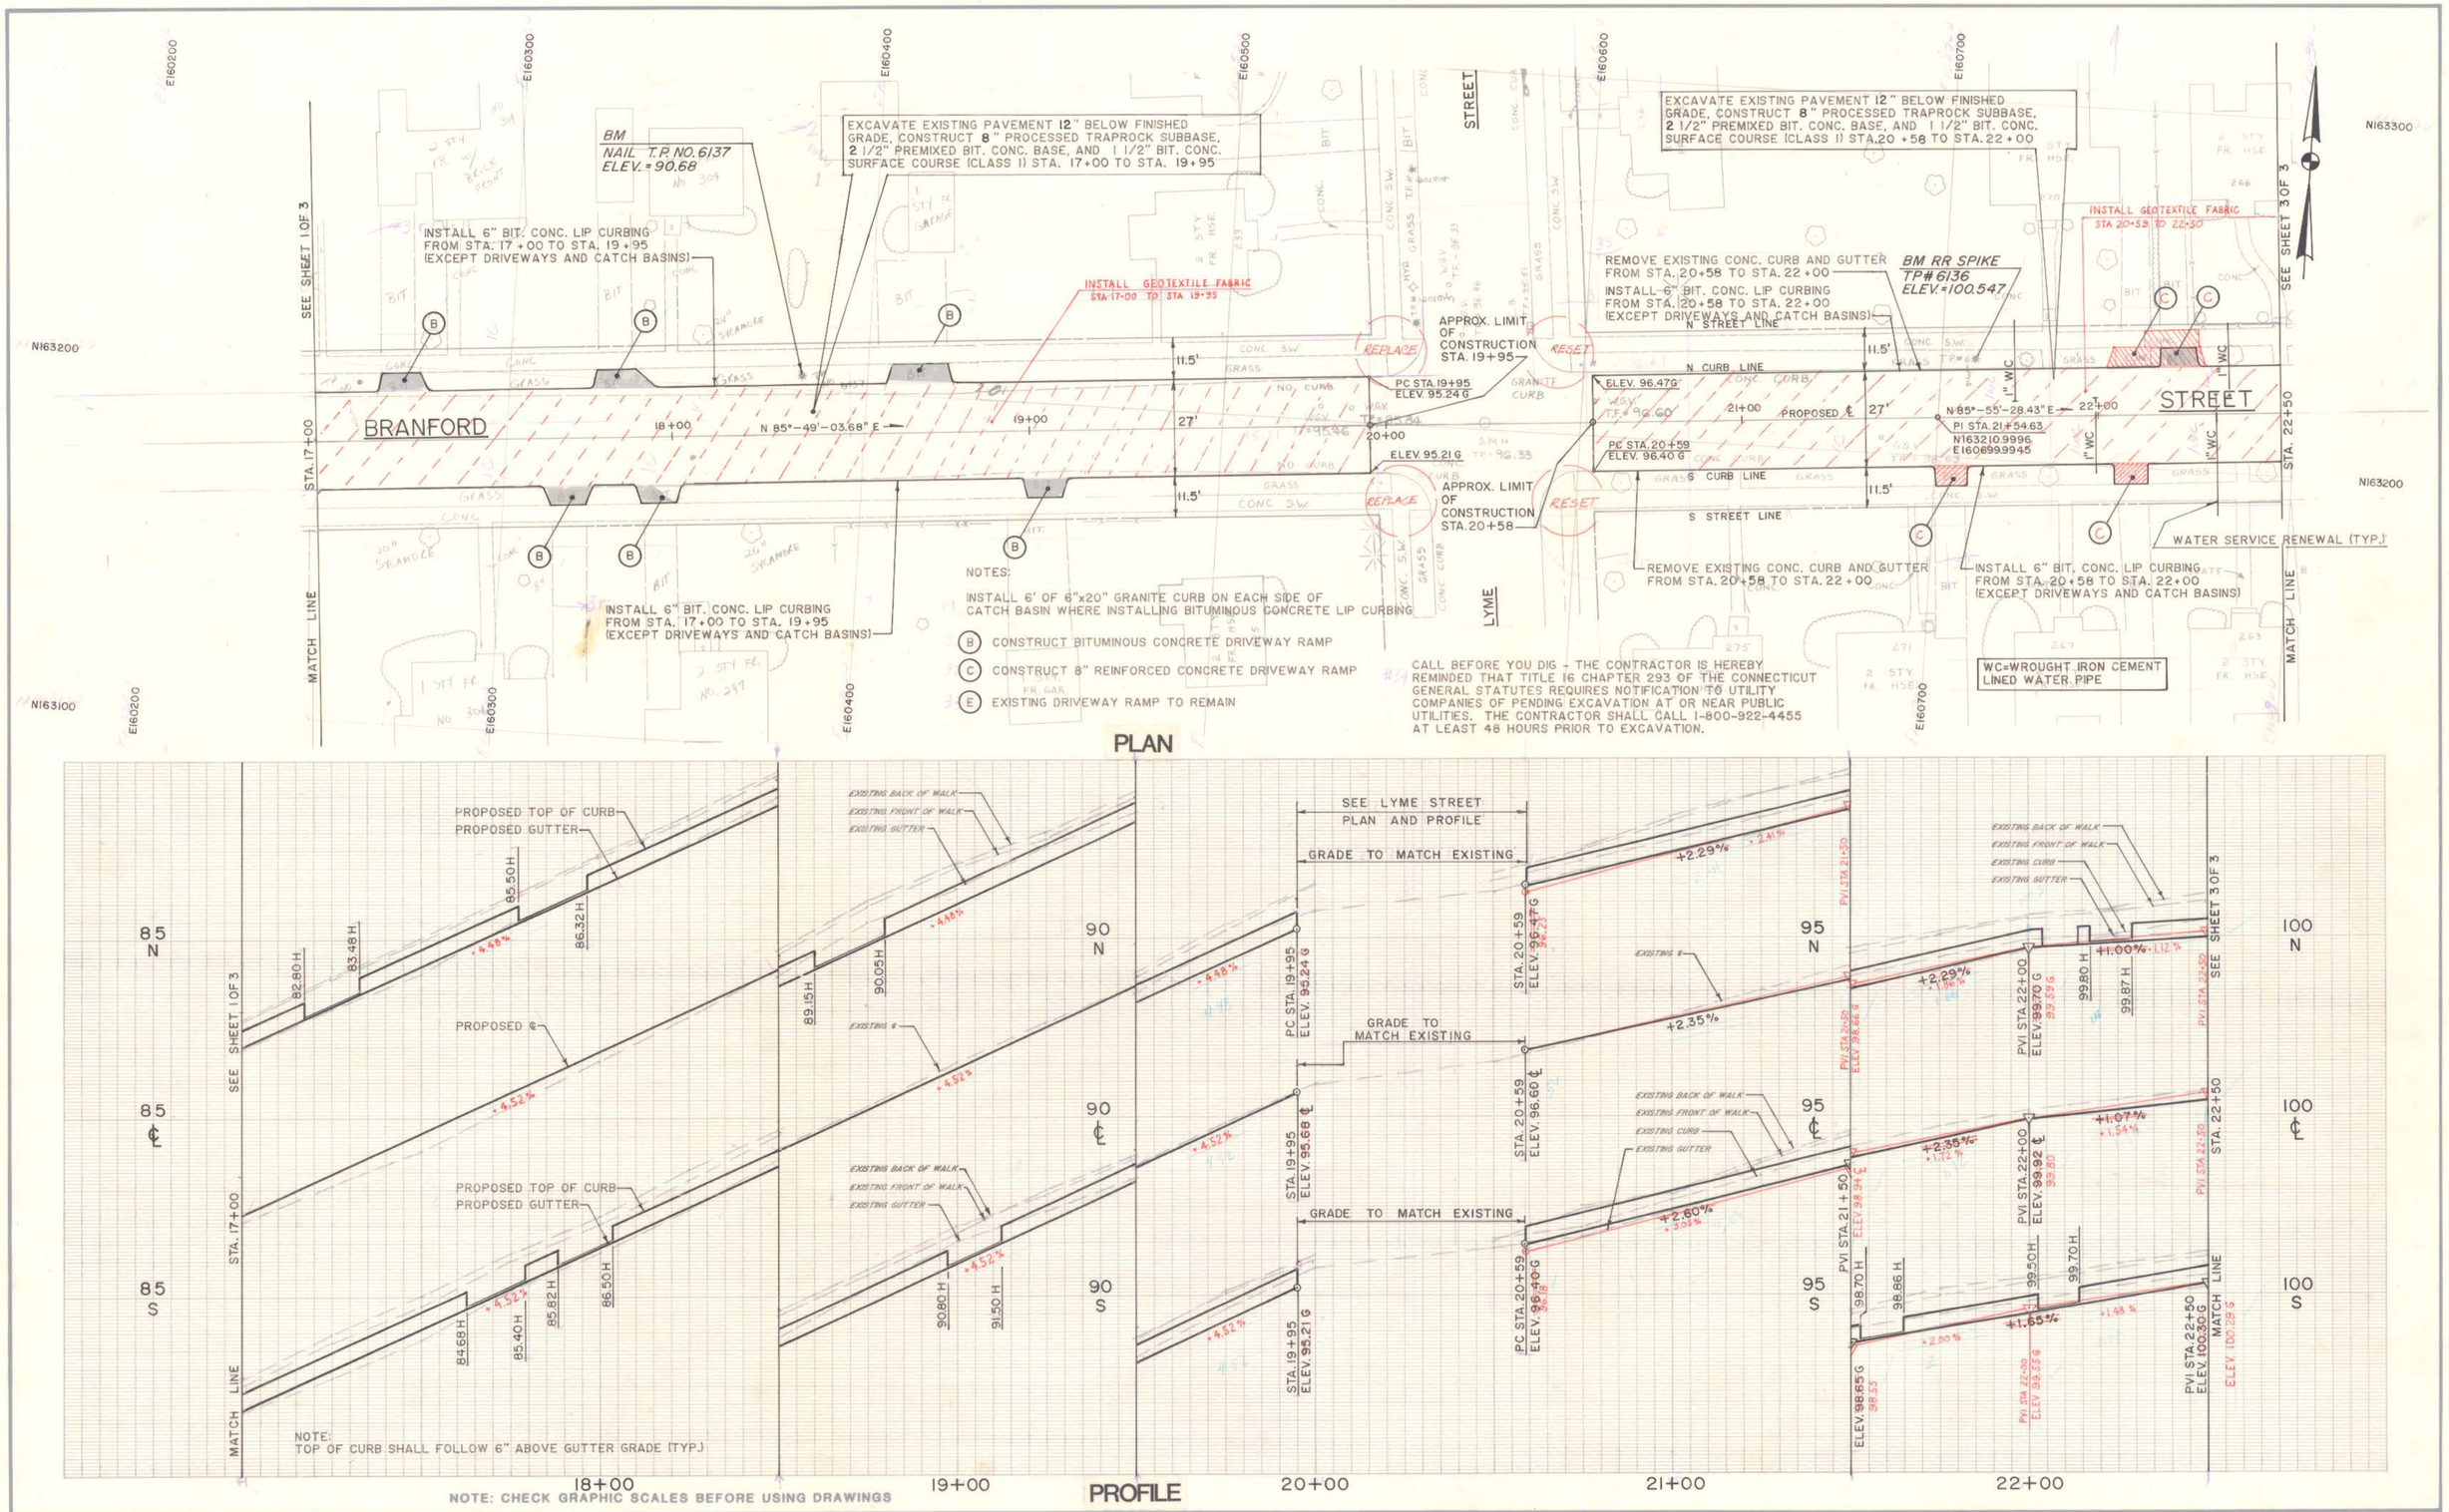

NOTE: CHECK GRAPHIC SCALES BEFORE USING DRAWINGS

NO.	DATE	DESCRIPTION
3	1/07/87	ADD GEO-TEX. DRAFTED BY: MJN
2	8/21/86	CHECKED BY: MJH
1	NOV 86	AS-BUILTS BY: EBS

REVISIONS

SUPV. ARW
DESIGN MDH/AEG
DRAWN
CHECKED JAC
DATE 6-17-85

GRAPHIC SCALES
HORIZ. 1" = 20'
VERT. 1" = 2'

ROADWAY RECONSTRUCTION
HARTFORD, CONNECTICUT

STATE OF CONNECTICUT
JAN 4, 1983
NO. 10606
REGISTERED PROFESSIONAL ENGINEER

Hayden | Wegman
Consulting Engineers
WEST HARTFORD
NEW YORK • BOSTON • BUFFALO
ATLANTA • MEMPHIS

CITY OF HARTFORD, CONNECTICUT
DEPARTMENT OF PUBLIC WORKS
BUREAU OF ENGINEERING SERVICES

DRAWN
CHECKED
SCALE
DAYBOOK NO. 010948
DATE

BRANFORD STREET

STA. 17-00 TO STA. 22-50

PLAN AND PROFILE

Contract # E85-29
Job No.- 845304
SHEET 2 OF 3

575/1A