
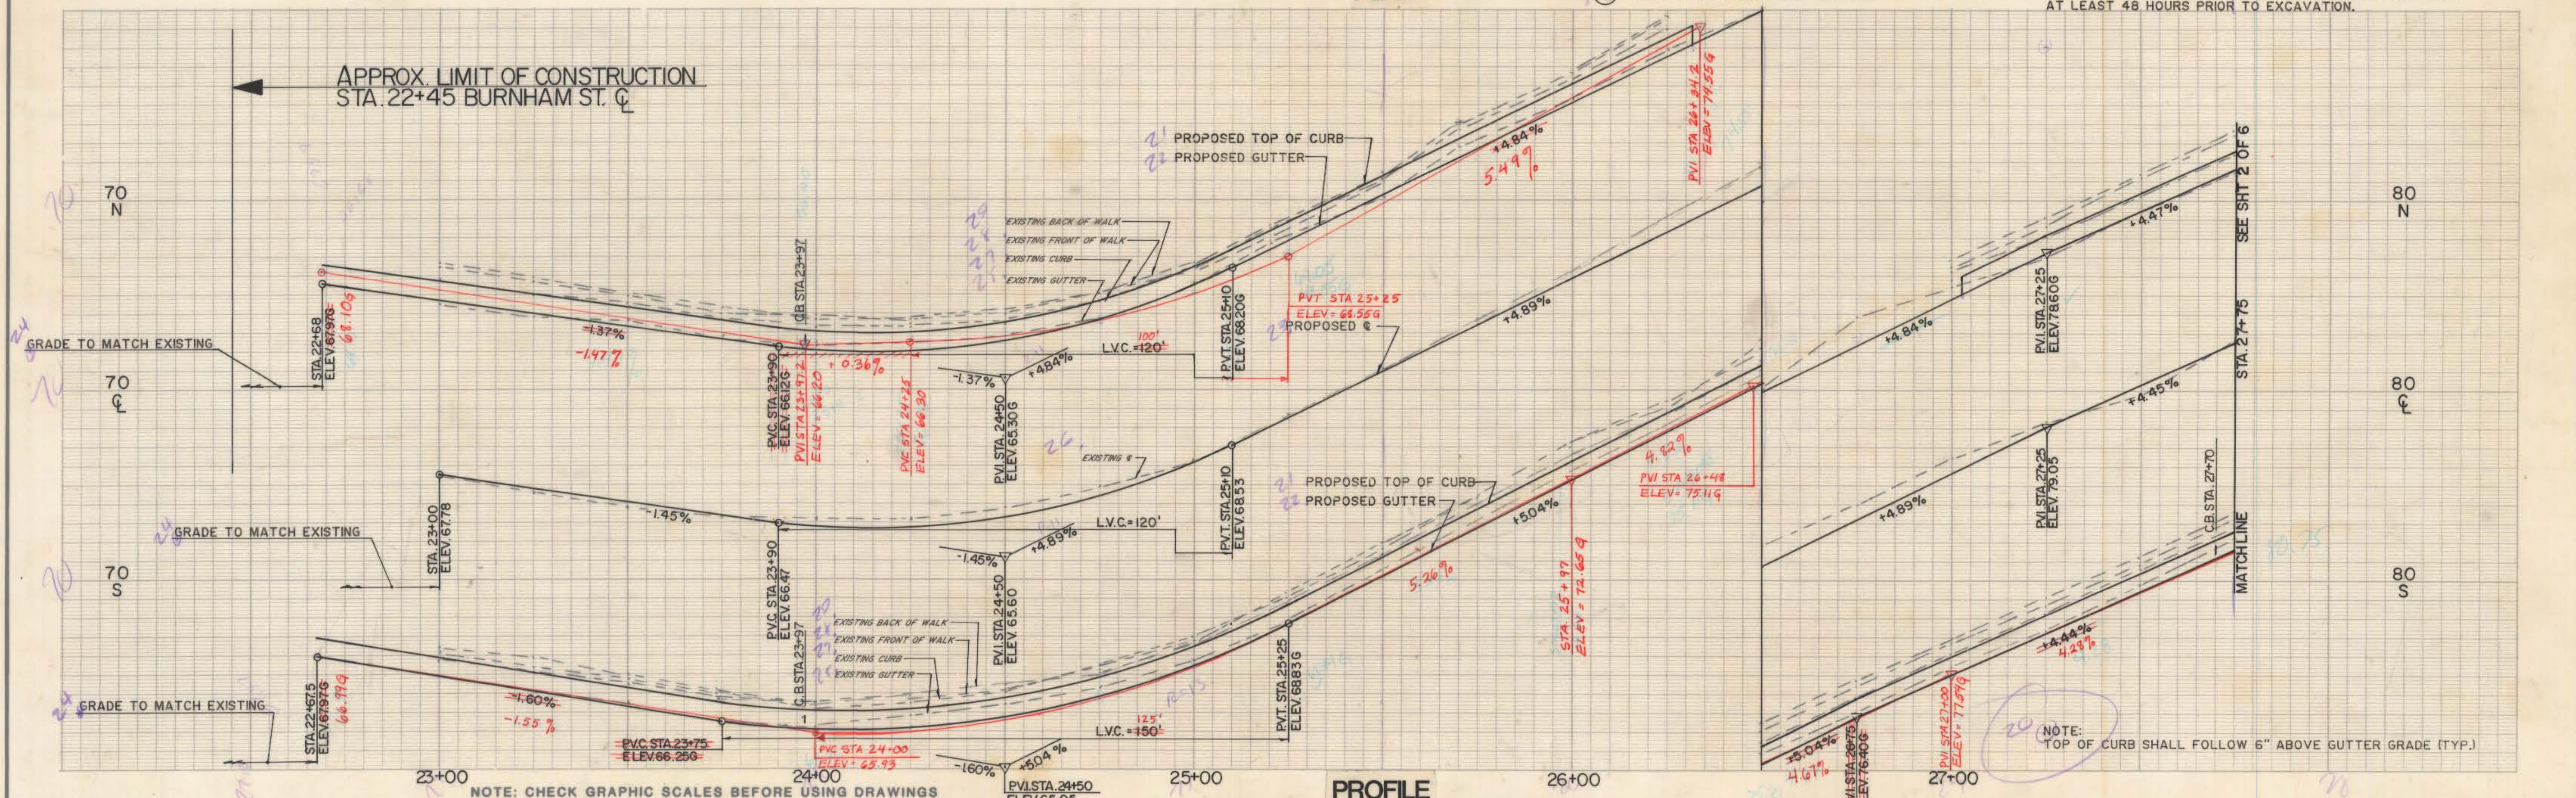


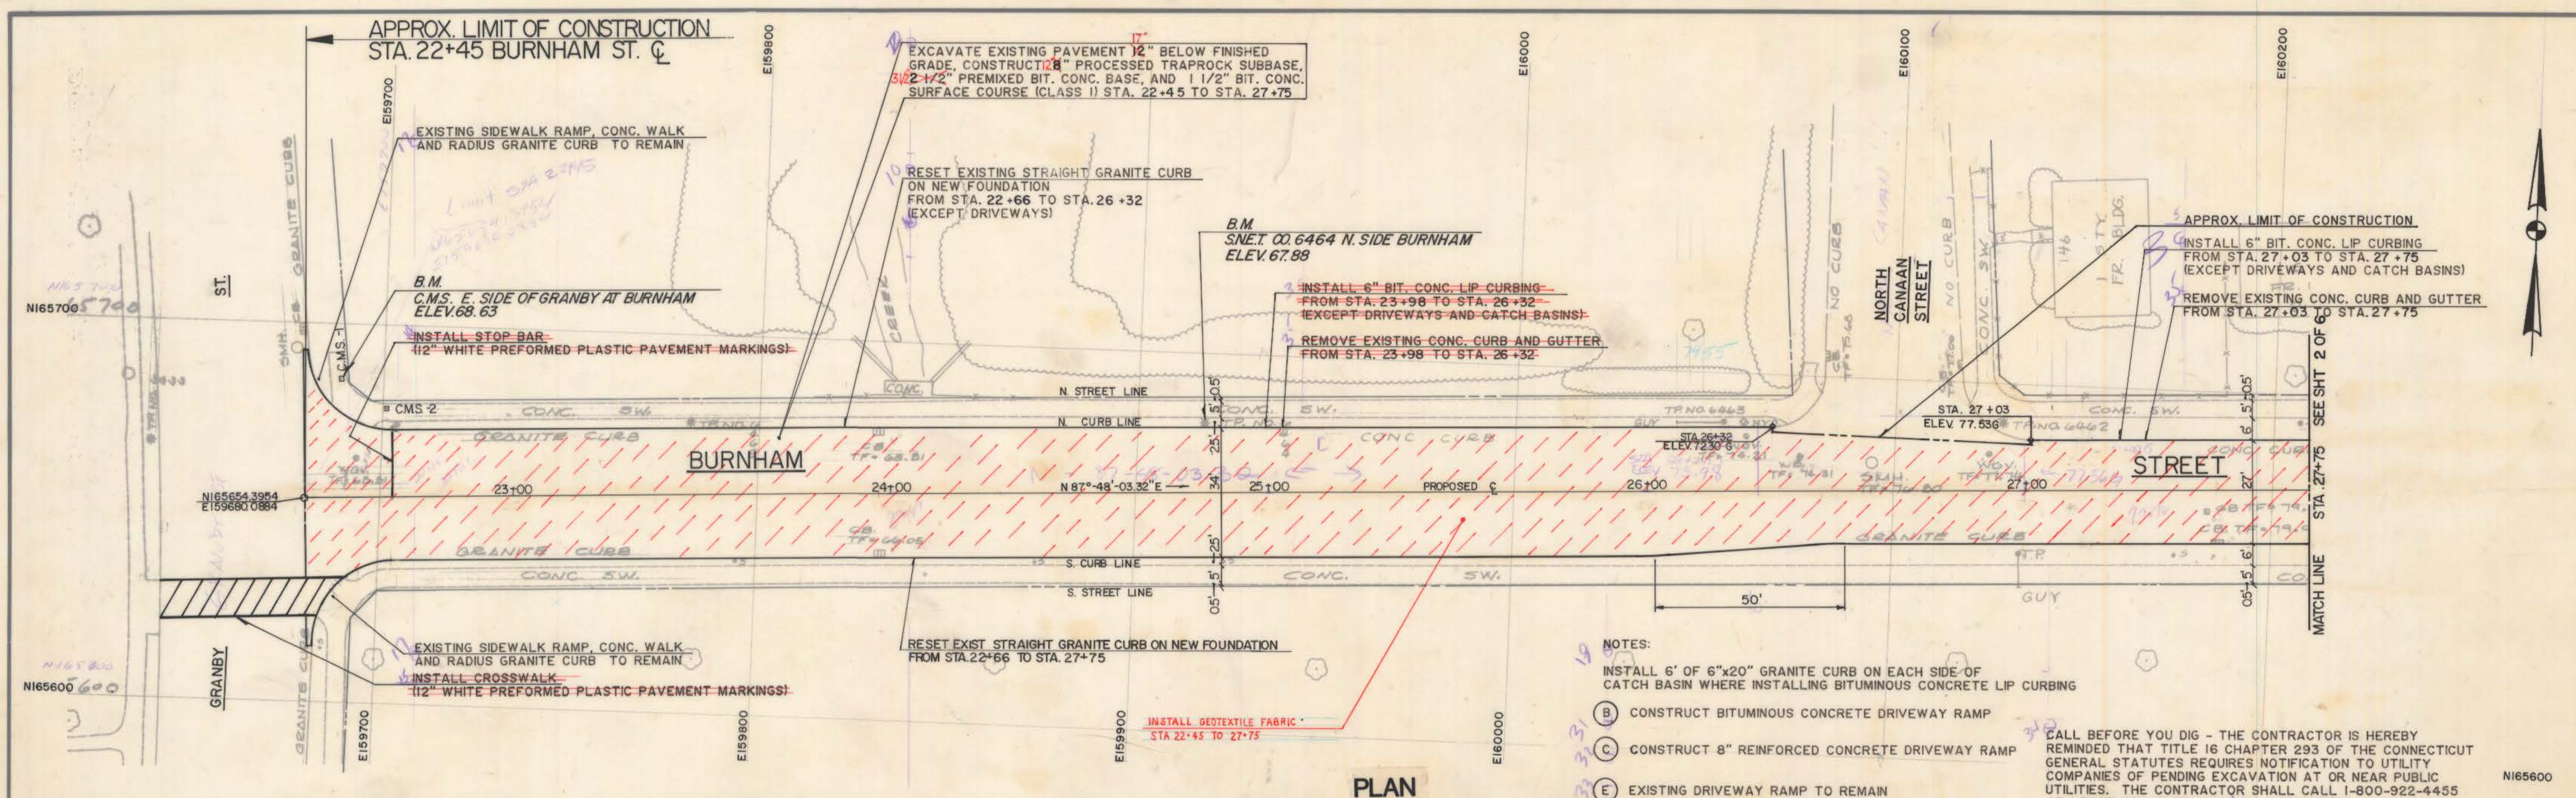

SUPV. APW DESIGN MDH/AEC DRAWN CB CHECKED JAC DATE 6/17/85		GRAPHIC SCALES HORIZ. 1" = 20' VERT. 1" = 2'		ROADWAY RECONSTRUCTION HARTFORD, CONNECTICUT				Hayden Wegman Consulting Engineers WEST HARTFORD NEW YORK • BOSTON • BUFFALO ATLANTA • MEMPHIS		CITY OF HARTFORD, CONNECTICUT DEPARTMENT OF PUBLIC WORKS BUREAU OF ENGINEERING SERVICES REMOVE LINE		BURNHAM STREET STA. 22-45 TO STA. 27-75 PLAN AND PROFILE		SHEET 11 Contract # E85-29 Job No. - 845304 OF 6	
---	--	--	--	---	--	--	--	---	--	--	--	--	--	---	--