


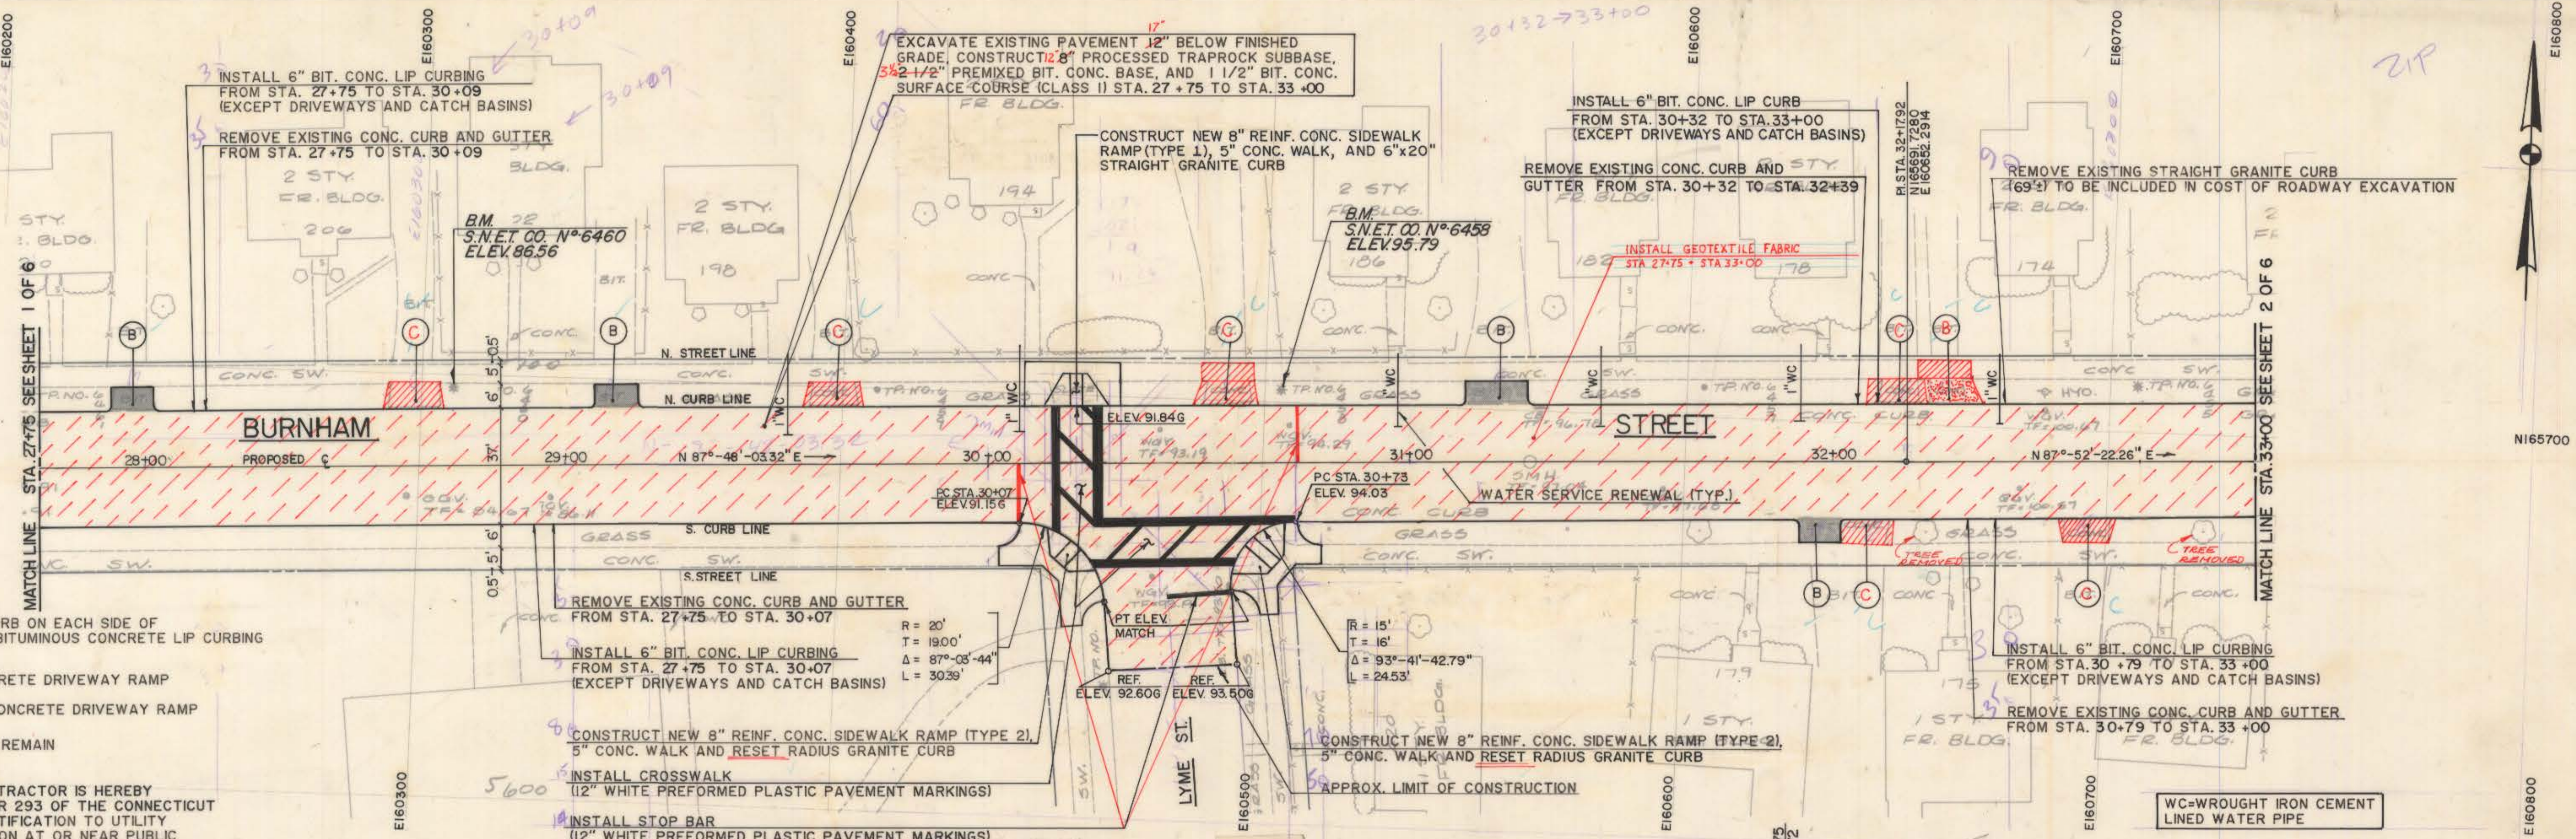

NOTES:


INSTALL 6' OF 6"x20" GRANITE CURB ON EACH SIDE OF CATCH BASIN WHERE INSTALLING BITUMINOUS CONCRETE LIP CURBING

(B) CONSTRUCT BITUMINOUS CONCRETE DRIVEWAY RAMP

(C) CONSTRUCT 8" REINFORCED CONCRETE DRIVEWAY RAMP

(E) EXISTING DRIVEWAY RAMP TO REMAIN

CALL BEFORE YOU DIG - THE CONTRACTOR IS HEREBY REMINDED THAT TITLE 16 CHAPTER 293 OF THE CONNECTICUT GENERAL STATUTES REQUIRES NOTIFICATION TO UTILITY COMPANIES OF PENDING EXCAVATION AT OR NEAR PUBLIC UTILITIES. THE CONTRACTOR SHALL CALL 1-800-922-4455 AT LEAST 48 HOURS PRIOR TO EXCAVATION.

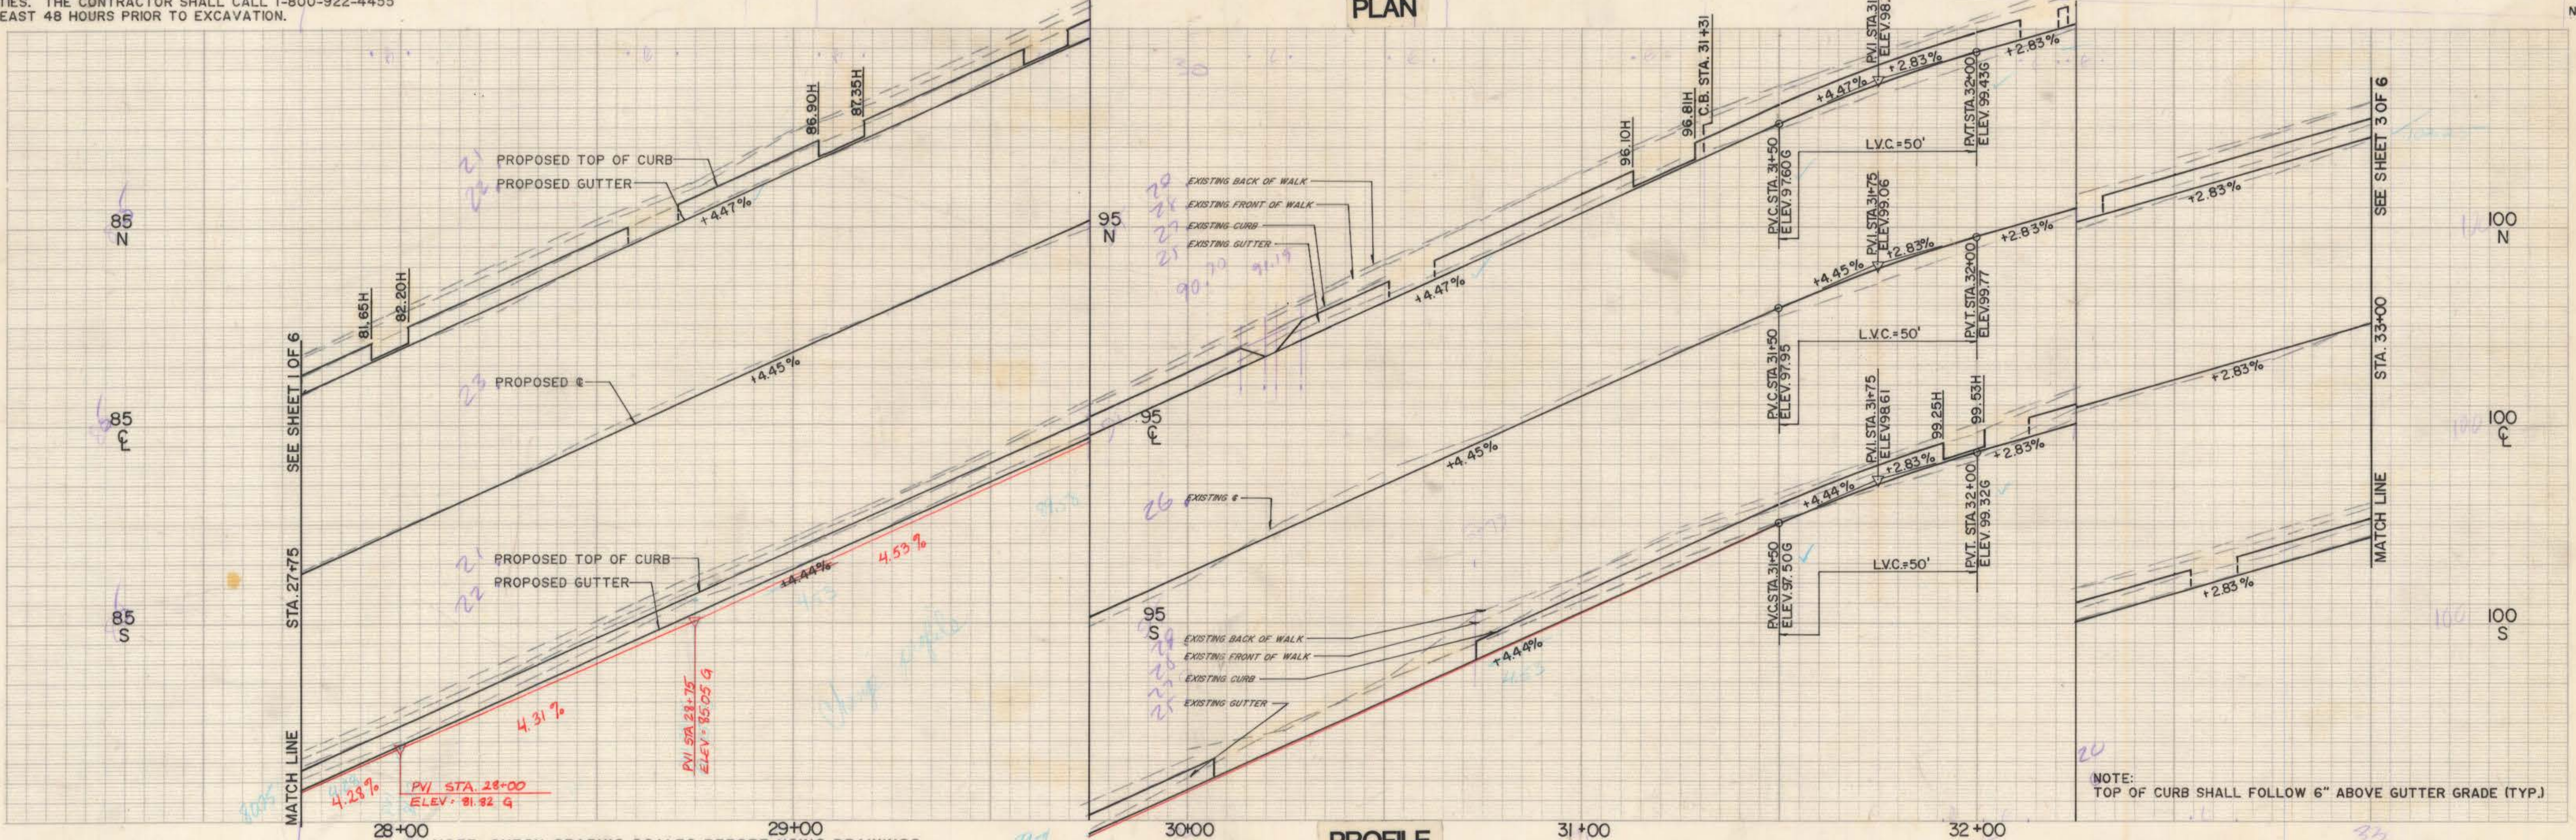

REVISIONS		GRAPHIC SCALES		ROADWAY RECONSTRUCTION		Hayden Wegman		CITY OF HARTFORD, CONNECTICUT		BURNHAM STREET	
NO. DATE DESCRIPTION		HORIZ. 1"=20' VERT. 1"=2'		HARTFORD, CONNECTICUT		Consulting Engineers		DEPARTMENT OF PUBLIC WORKS BUREAU OF ENGINEERING SERVICES		STA. 27-75 TO STA. 33-00	
1. 11/1/10 CHECKED BY MDH 2. 11/1/10 AD-BUILT DONE BY JAC						WEST HARTFORD NEW YORK • BOSTON • BUFFALO ATLANTA • MEMPHIS		DRAWN _____ CHECKED _____		SHEET 2	
DATE 6/17/85								SCALE _____ DATE _____		Contract # E85-29 Job No.- 845304 OF 6	