
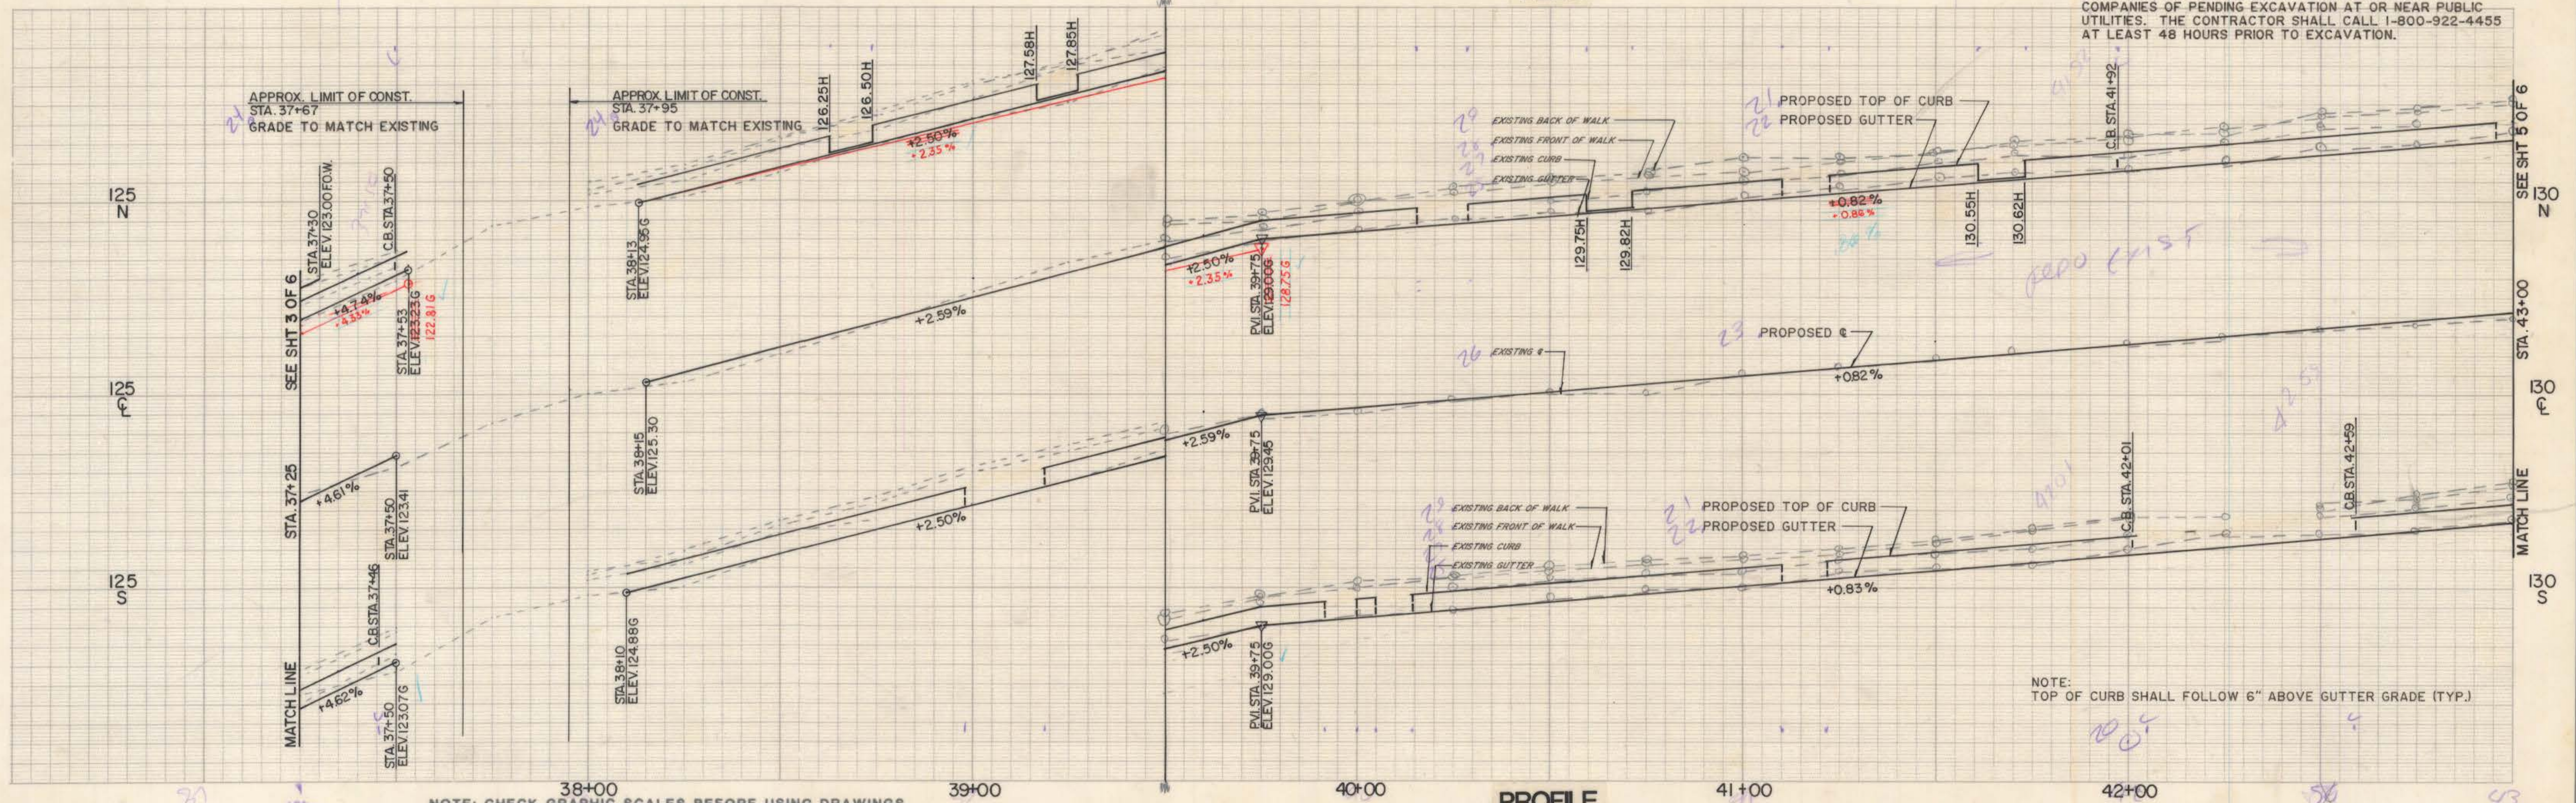


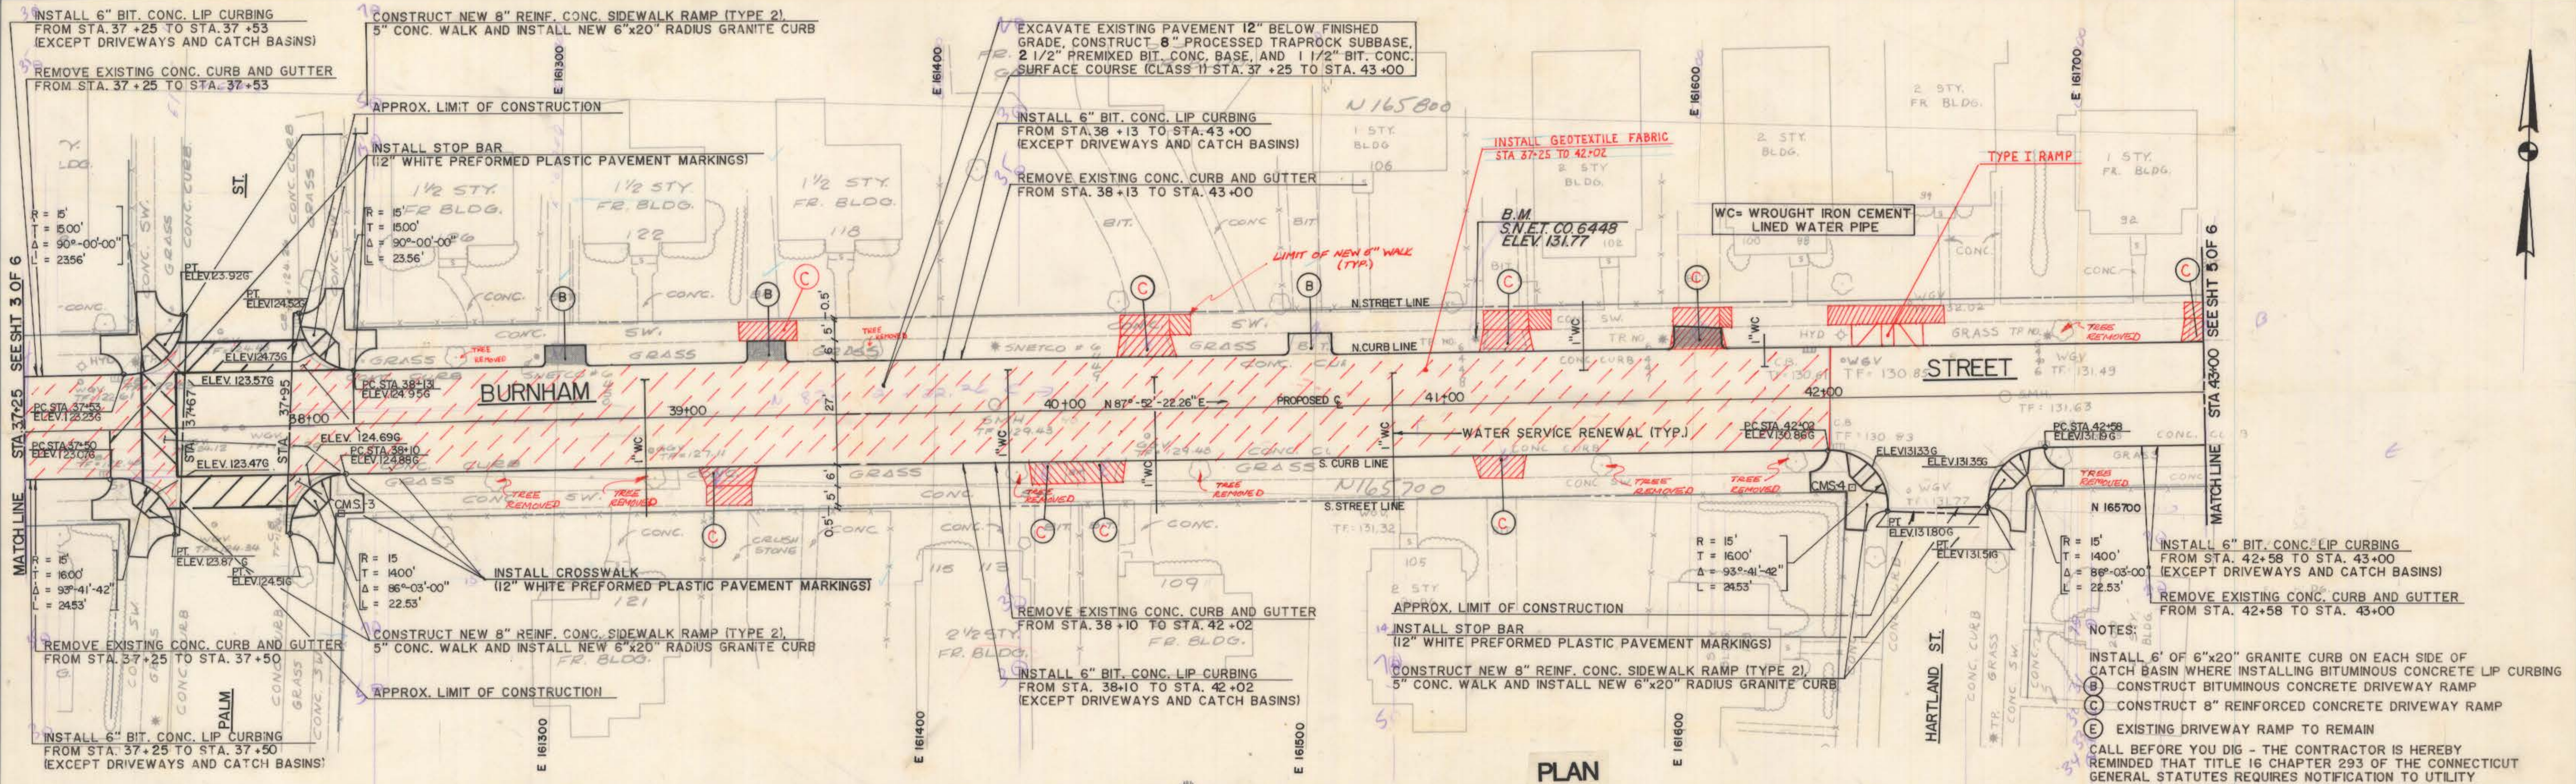

SUPV. ARW DESIGN MDH/AEC DRAWN MDH CHECKED JAC DATE 6/17/85		GRAPHIC SCALES HORIZ. 1"=20' VERT. 1"=2'		ROADWAY RECONSTRUCTION HARTFORD, CONNECTICUT		CITY OF HARTFORD, CONNECTICUT DEPARTMENT OF PUBLIC WORKS BUREAU OF ENGINEERING SERVICES		BURNHAM STREET STA. 37-25 TO STA. 43-00 PLAN AND PROFILE Contract # E85-29 Job No.- 845304		SHEET 4 OF 6	
REVISIONS NO. DATE DESCRIPTION						DRAWN CHECKED		SCALE DATE		DAYBOOK NO. 010948	