

NOTES:

- INSTALL 6" OF 6"x20" GRANITE CURB ON EACH SIDE OF CATCH BASIN WHERE INSTALLING BITUMINOUS CONCRETE LIP CURBING
- (B) CONSTRUCT BITUMINOUS CONCRETE DRIVEWAY RAMP
- (C) CONSTRUCT 8" REINFORCED CONCRETE DRIVEWAY RAMP
- (E) EXISTING DRIVEWAY RAMP TO REMAIN
- CALL BEFORE YOU DIG - THE CONTRACTOR IS HEREBY REMINDED THAT TITLE 16 CHAPTER 293 OF THE CONNECTICUT GENERAL STATUTES REQUIRES NOTIFICATION TO UTILITY COMPANIES OF PENDING EXCAVATION AT OR NEAR PUBLIC UTILITIES. THE CONTRACTOR SHALL CALL 1-800-922-4455 AT LEAST 48 HOURS PRIOR TO EXCAVATION.

EXCAVATE EXISTING PAVEMENT 12" BELOW FINISHED GRADE, CONSTRUCT 8" PROCESSED TRAPROCK SUBBASE, 2 1/2" PREMIXED BIT. CONC. BASE, AND 1 1/2" BIT. CONC. SURFACE COURSE (CLASS II) STA. 17+00 TO STA. 22+11.54

APPROX. LIMIT OF CONSTRUCTION
STA. 22+11.54 CHATHAM STREET CL

REMOVE EXISTING BIT. CONC. (TO BE INCLUDED IN COST OF ROADWAY EXCAVATION) TOPSOIL AND SEED

INSTALL 6" BIT. CONC. LIP CURBING FROM STA. 17+00 TO STA. 21+98 (EXCEPT DRIVEWAYS AND CATCH BASINS)


REMOVE EXISTING CONC. CURB AND GUTTER FROM STA. 17+00 TO STA. 21+98

CONSTRUCT NEW 8" REINF. CONC. SIDEWALK RAMP (TYPE 2), 5" CONC. WALK AND INSTALL NEW 6"x20" RADIUS GRANITE CURB EXISTING


INSTALL STOP BAR (12" WHITE PREFORMED PLASTIC PAVEMENT MARKINGS)

CONSTRUCT NEW 8" REINF. CONC. SIDEWALK RAMP (TYPE 1), 5" CONC. WALK AND INSTALL NEW 6"x20" STRAIGHT GRANITE CURB

INSTALL CROSSWALK (12" WHITE PREFORMED PLASTIC PAVEMENT MARKINGS)

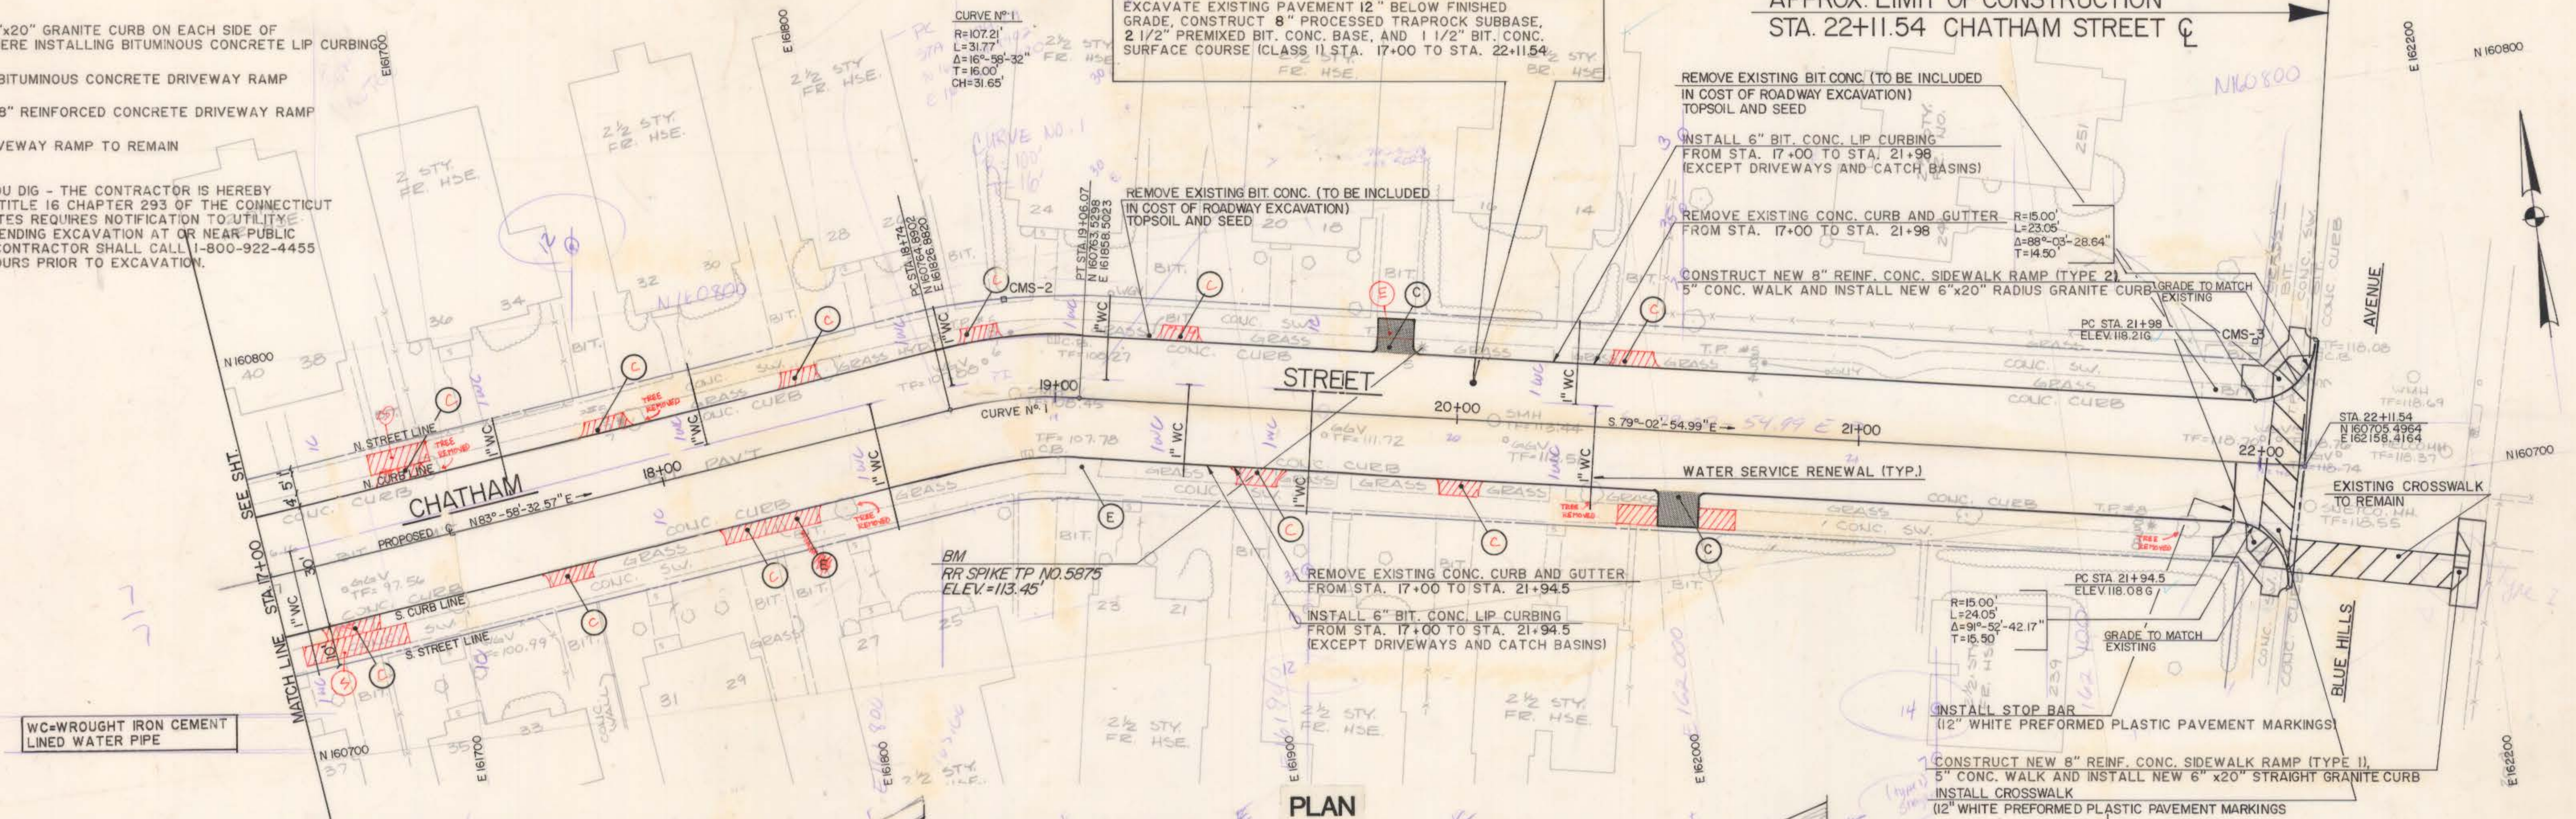

PLAN

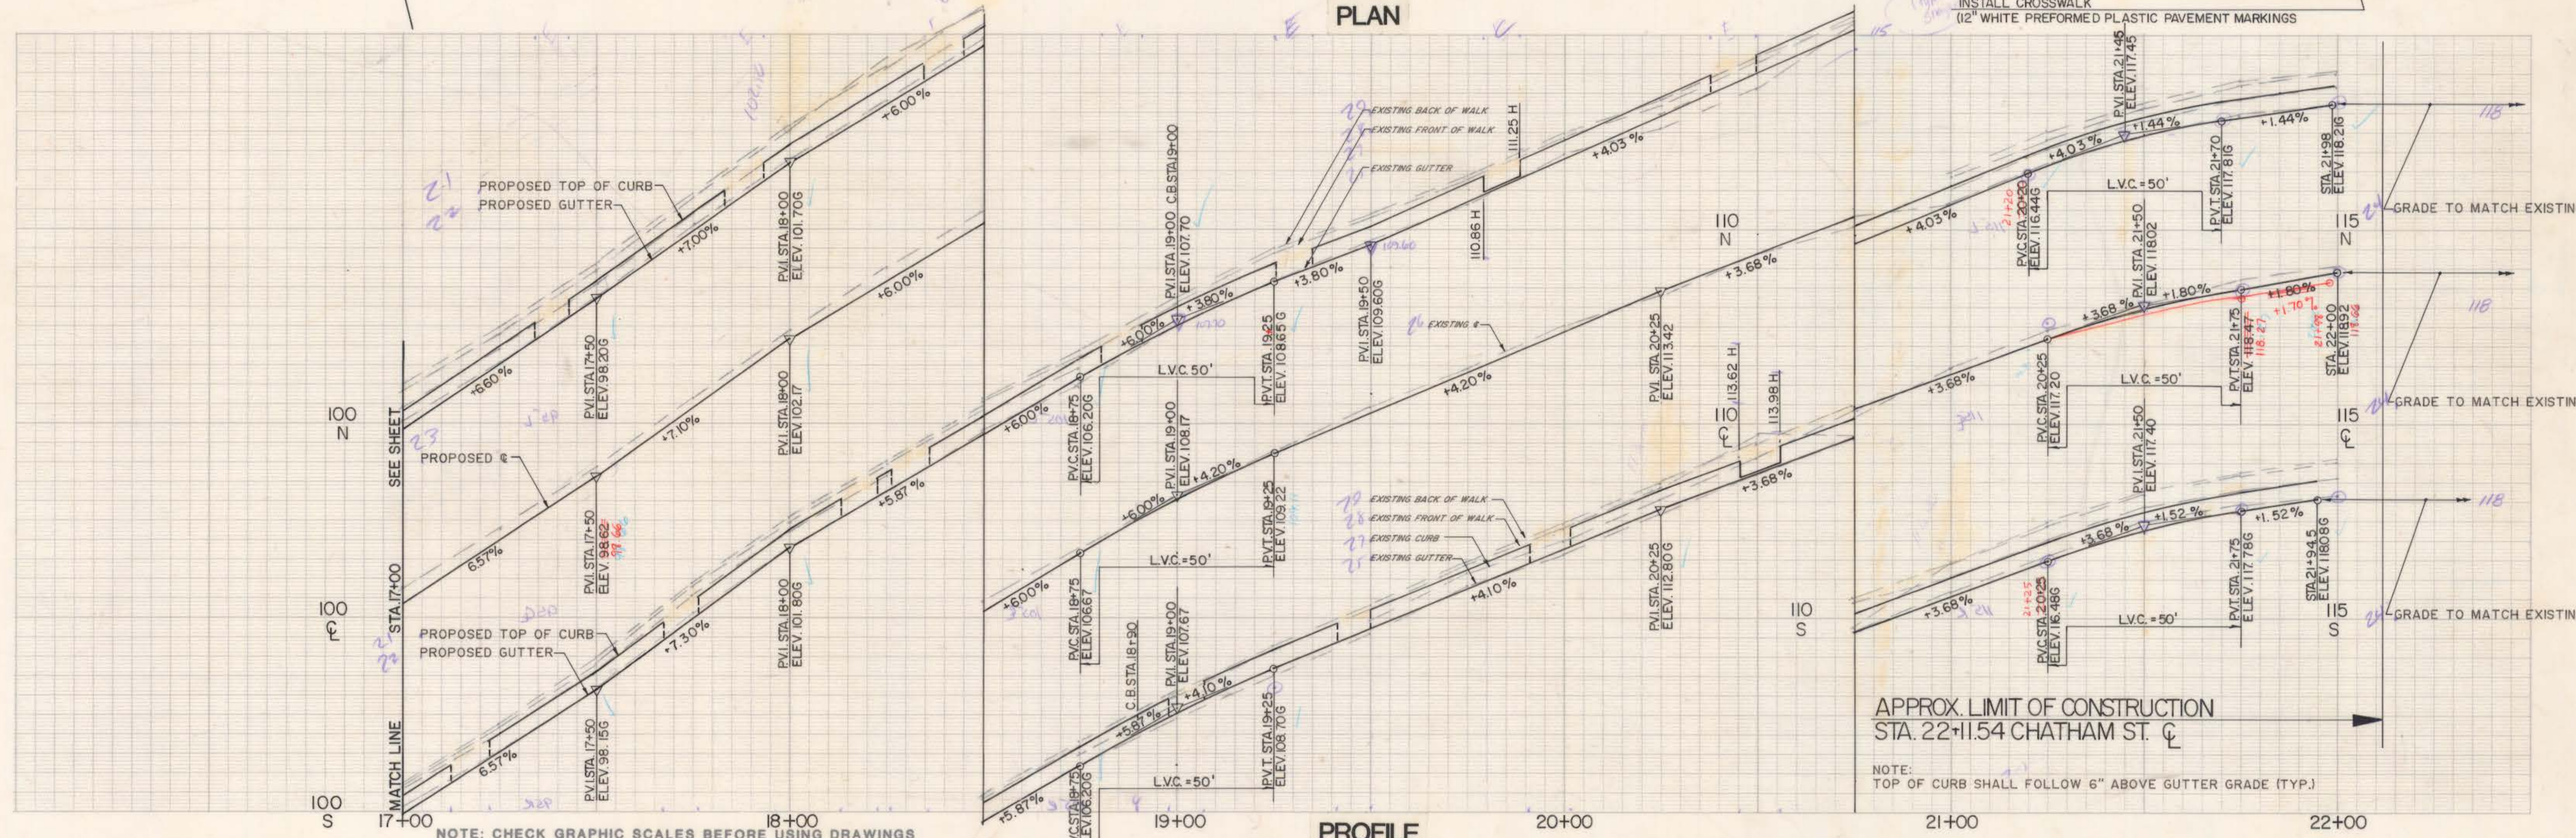

PROFILE

APPROX. LIMIT OF CONSTRUCTION
STA. 22+11.54 CHATHAM ST. CL

NOTE:
TOP OF CURB SHALL FOLLOW 6" ABOVE GUTTER GRADE (TYP.)

NO.	DATE	DESCRIPTION
1	6/17/85	REVISIONS

SUPV.	ARW
DESIGN	MDH/AEC
DRAWN	KHT, B
CHECKED	JAC
DATE	6/17/85

GRAPHIC SCALES	HORIZ. 1" = 20'
	VERT. 1" = 2'

ROADWAY RECONSTRUCTION
HARTFORD, CONNECTICUT



Hayden | Wegman
Consulting Engineers

WEST HARTFORD
NEW YORK • BOSTON • BUFFALO
ATLANTA • MEMPHIS

CITY OF HARTFORD, CONNECTICUT
DEPARTMENT OF PUBLIC WORKS
BUREAU OF ENGINEERING SERVICES

DRAWN: _____
CHECKED: _____

SCALE: _____
DATE: _____

DAYBOOK NO. 010948

CHATHAM STREET
STA. 17+00 TO STA. 22+11.54

PLAN AND PROFILE

SHEET 2
Contract # E85-29. Job No. - 845304 OF 2

575/1C