



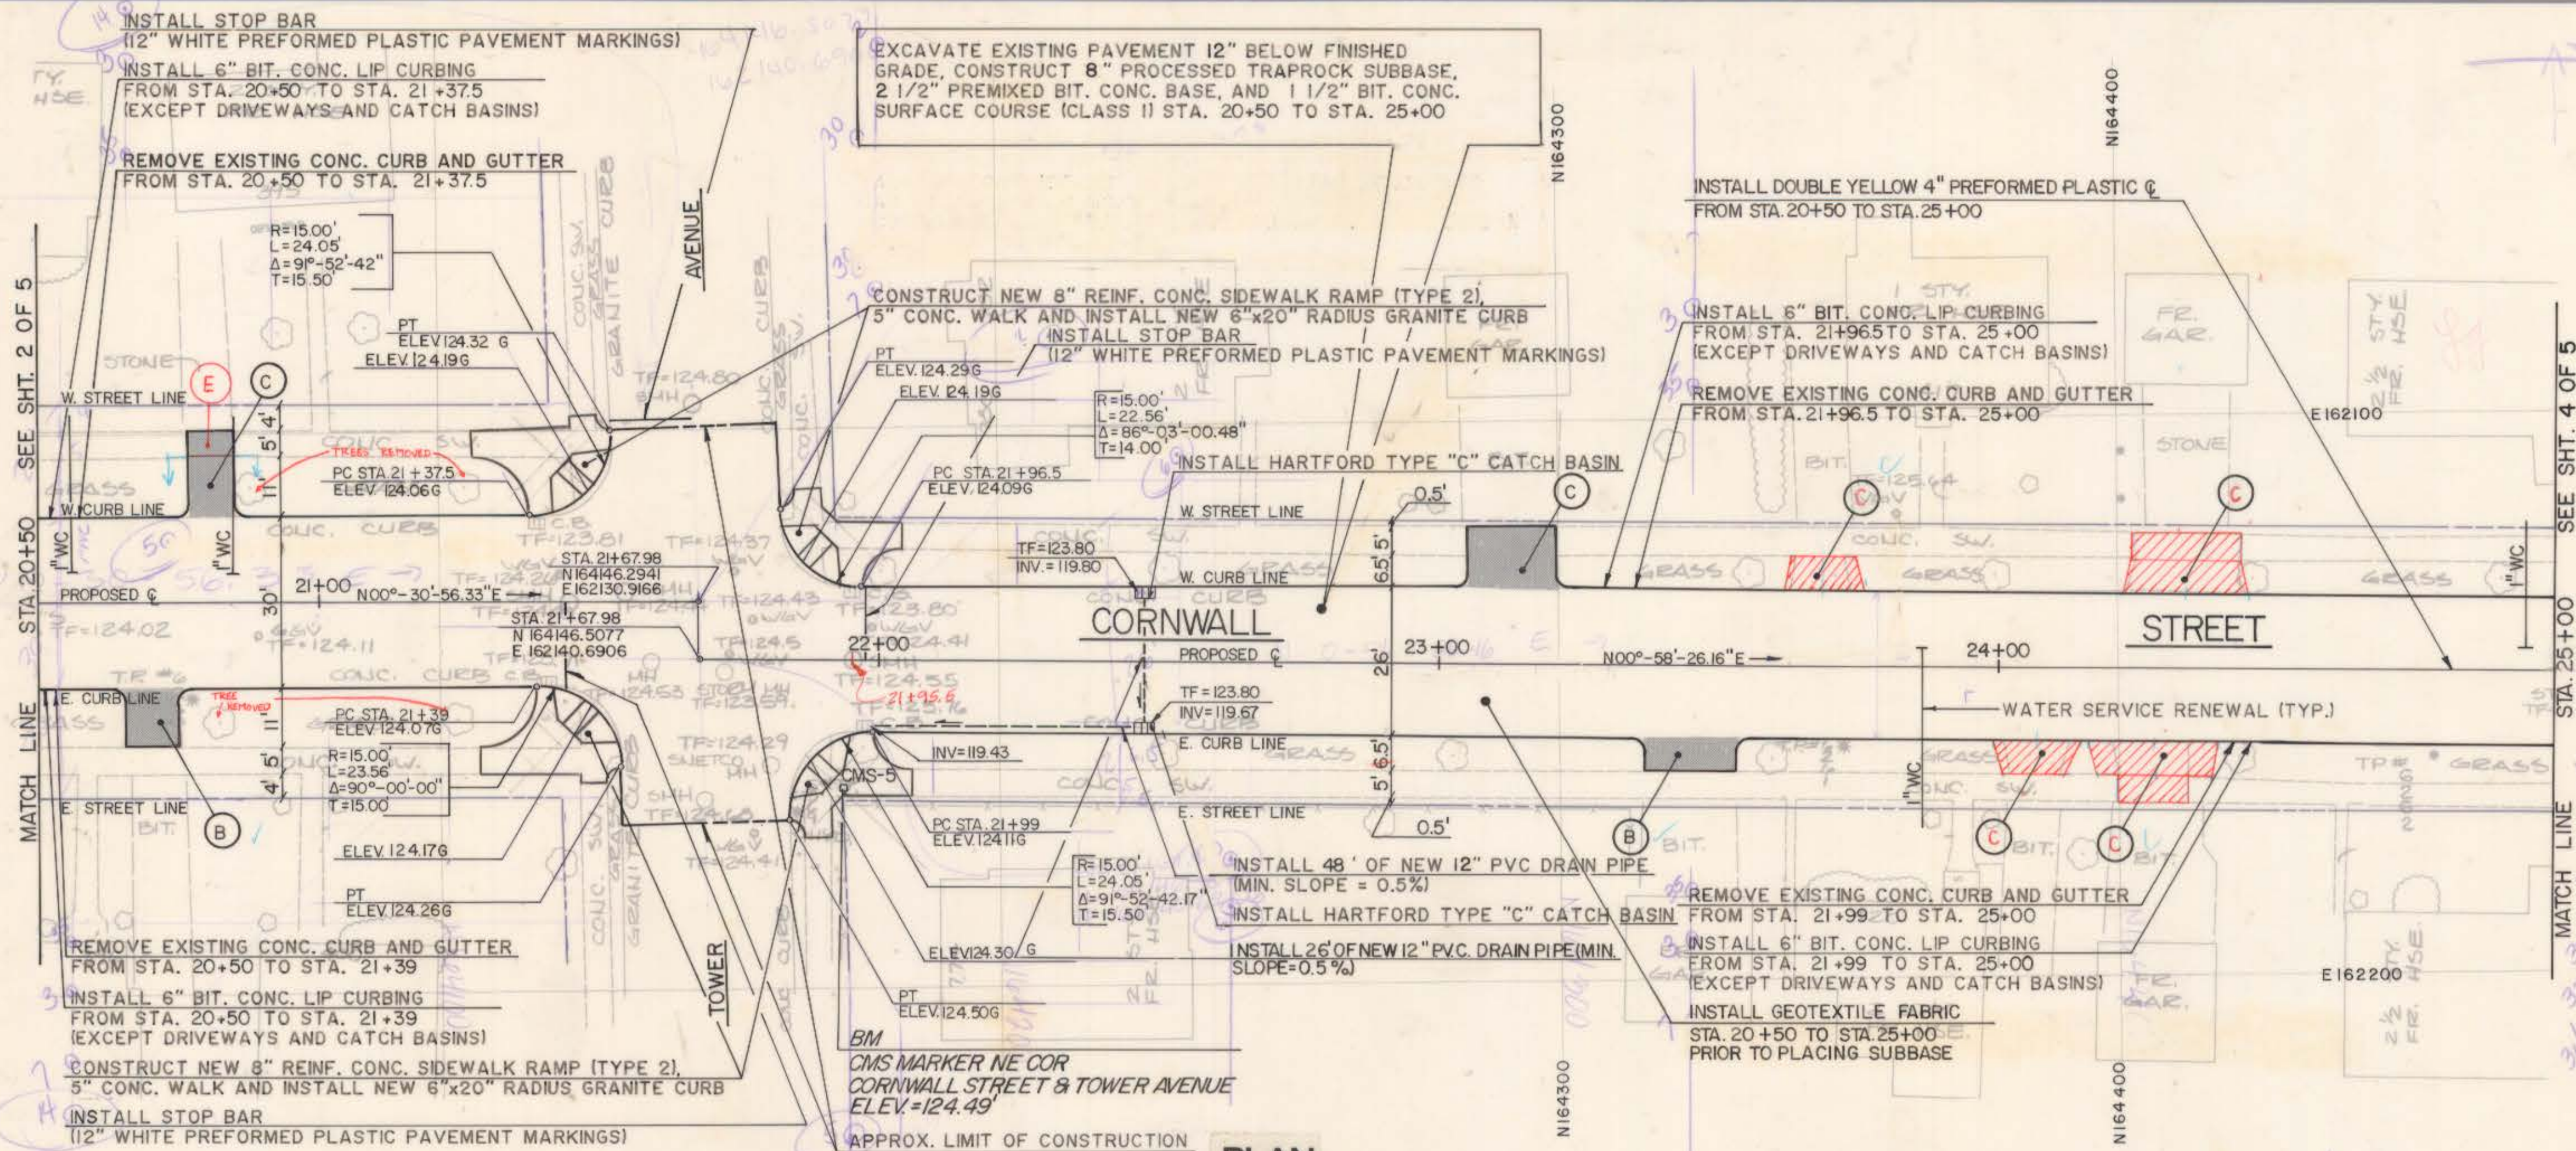

PLAN

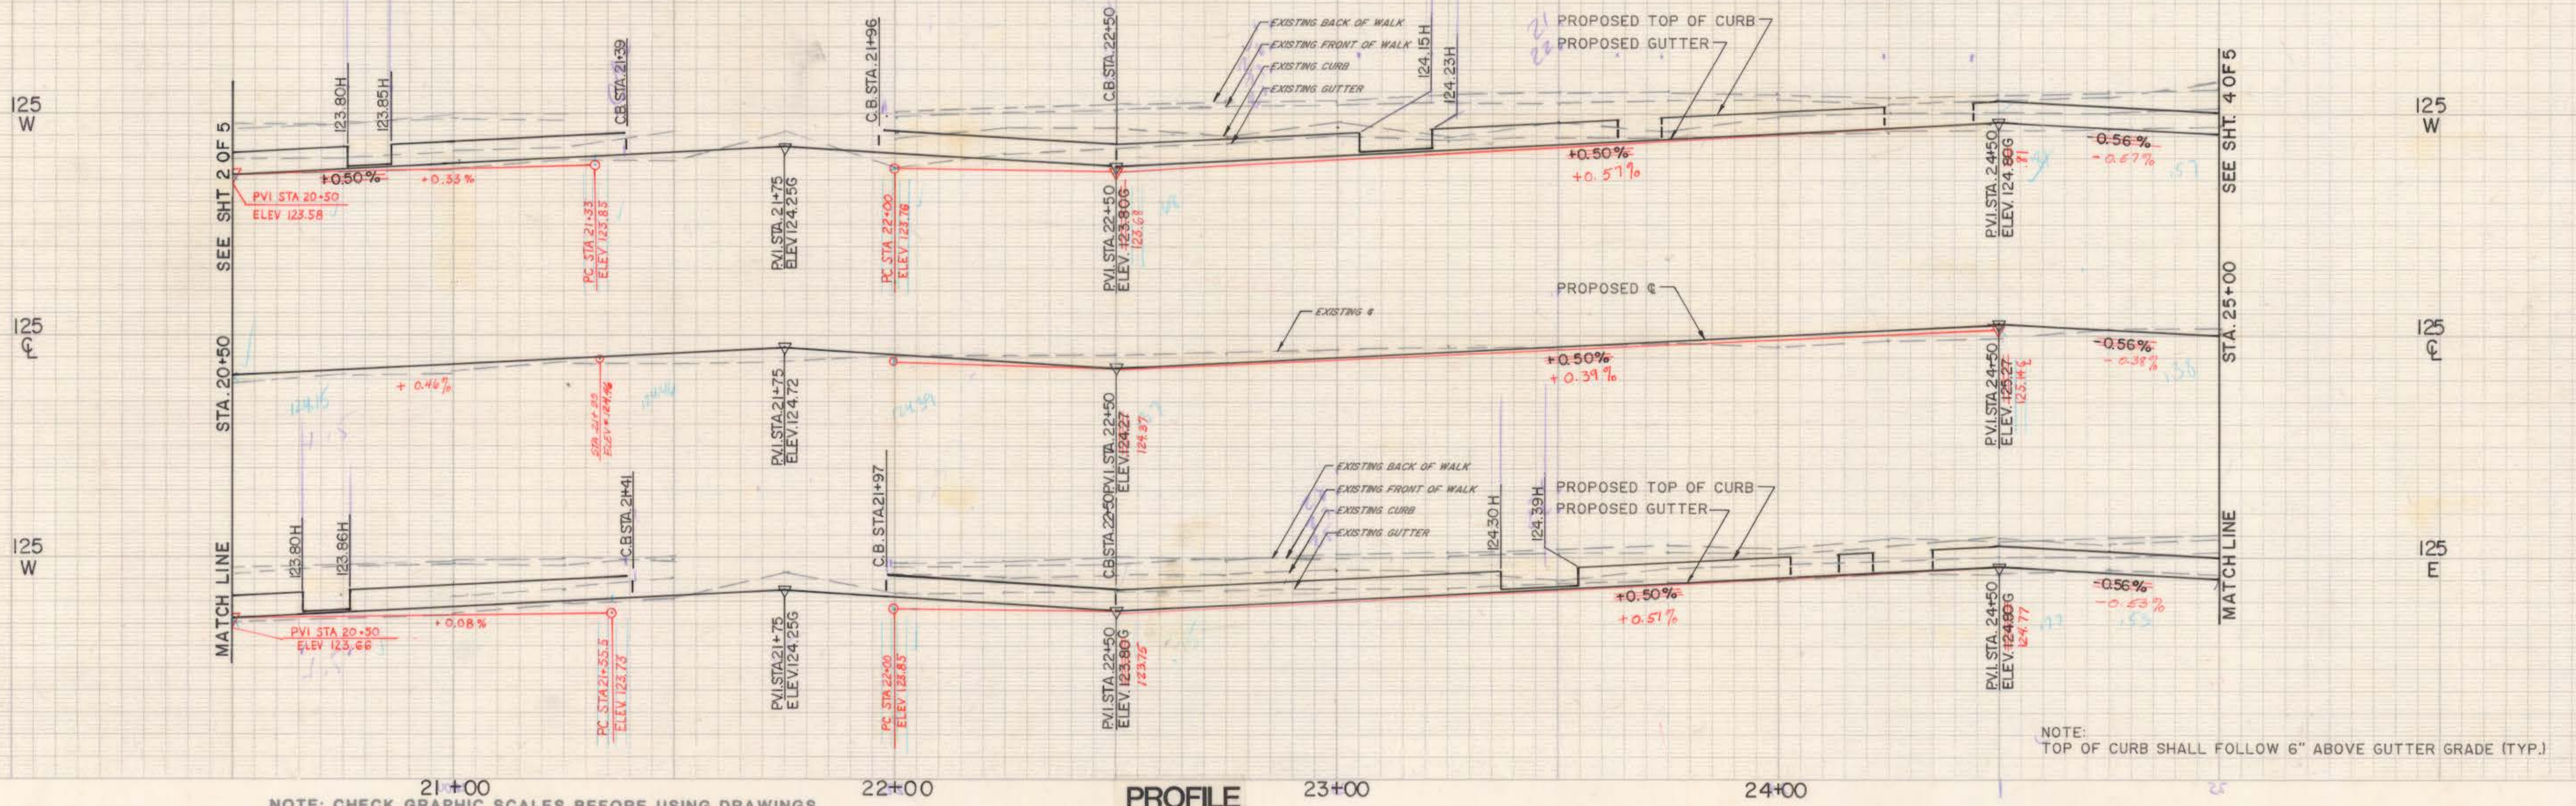

PROFILE

REVISIONS		SUPV. ARW		GRAPHIC SCALES		ROADWAY RECONSTRUCTION HARTFORD, CONNECTICUT		Hayden Wegman Consulting Engineers		CITY OF HARTFORD, CONNECTICUT DEPARTMENT OF PUBLIC WORKS BUREAU OF ENGINEERING SERVICES		CORNWALL STREET STA. 20-50 TO STA. 25-00		PLAN AND PROFILE		SHEET 3	
NO. DATE DESCRIPTION		CHECKED JAC		HORIZ. 1"=20' VERT. 1"=2'		DATE 6/17/85		NEW YORK • BOSTON • BUFFALO ATLANTA • MEMPHIS		DRAWN CHECKED		SCALE DAYBOOK NO. 010948		Contract # E85-29		Job No. - 845304 OF 5	