NOTES:

INSTALL 6' OF 6"x20" GRANITE CURB ON EACH SIDE OF CATCH BASIN WHERE INSTALLING BITUMINOUS CONCRETE LIP CURBING

(B) CONSTRUCT BITUMINOUS CONCRETE DRIVEWAY RAMP

(C) CONSTRUCT 8" REINFORCED CONCRETE DRIVEWAY RAMP

(E) EXISTING DRIVEWAY RAMP TO REMAIN

CALL BEFORE YOU DIG - THE CONTRACTOR IS HEREBY REMINDED THAT TITLE 16 CHAPTER 293 OF THE CONNECTICUT GENERAL STATUTES REQUIRES NOTIFICATION TO UTILITY COMPANIES OF PENDING EXCAVATION AT OR NEAR PUBLIC UTILITIES. THE CONTRACTOR SHALL CALL 1-800-922-4455 AT LEAST 48 HOURS PRIOR TO EXCAVATION.

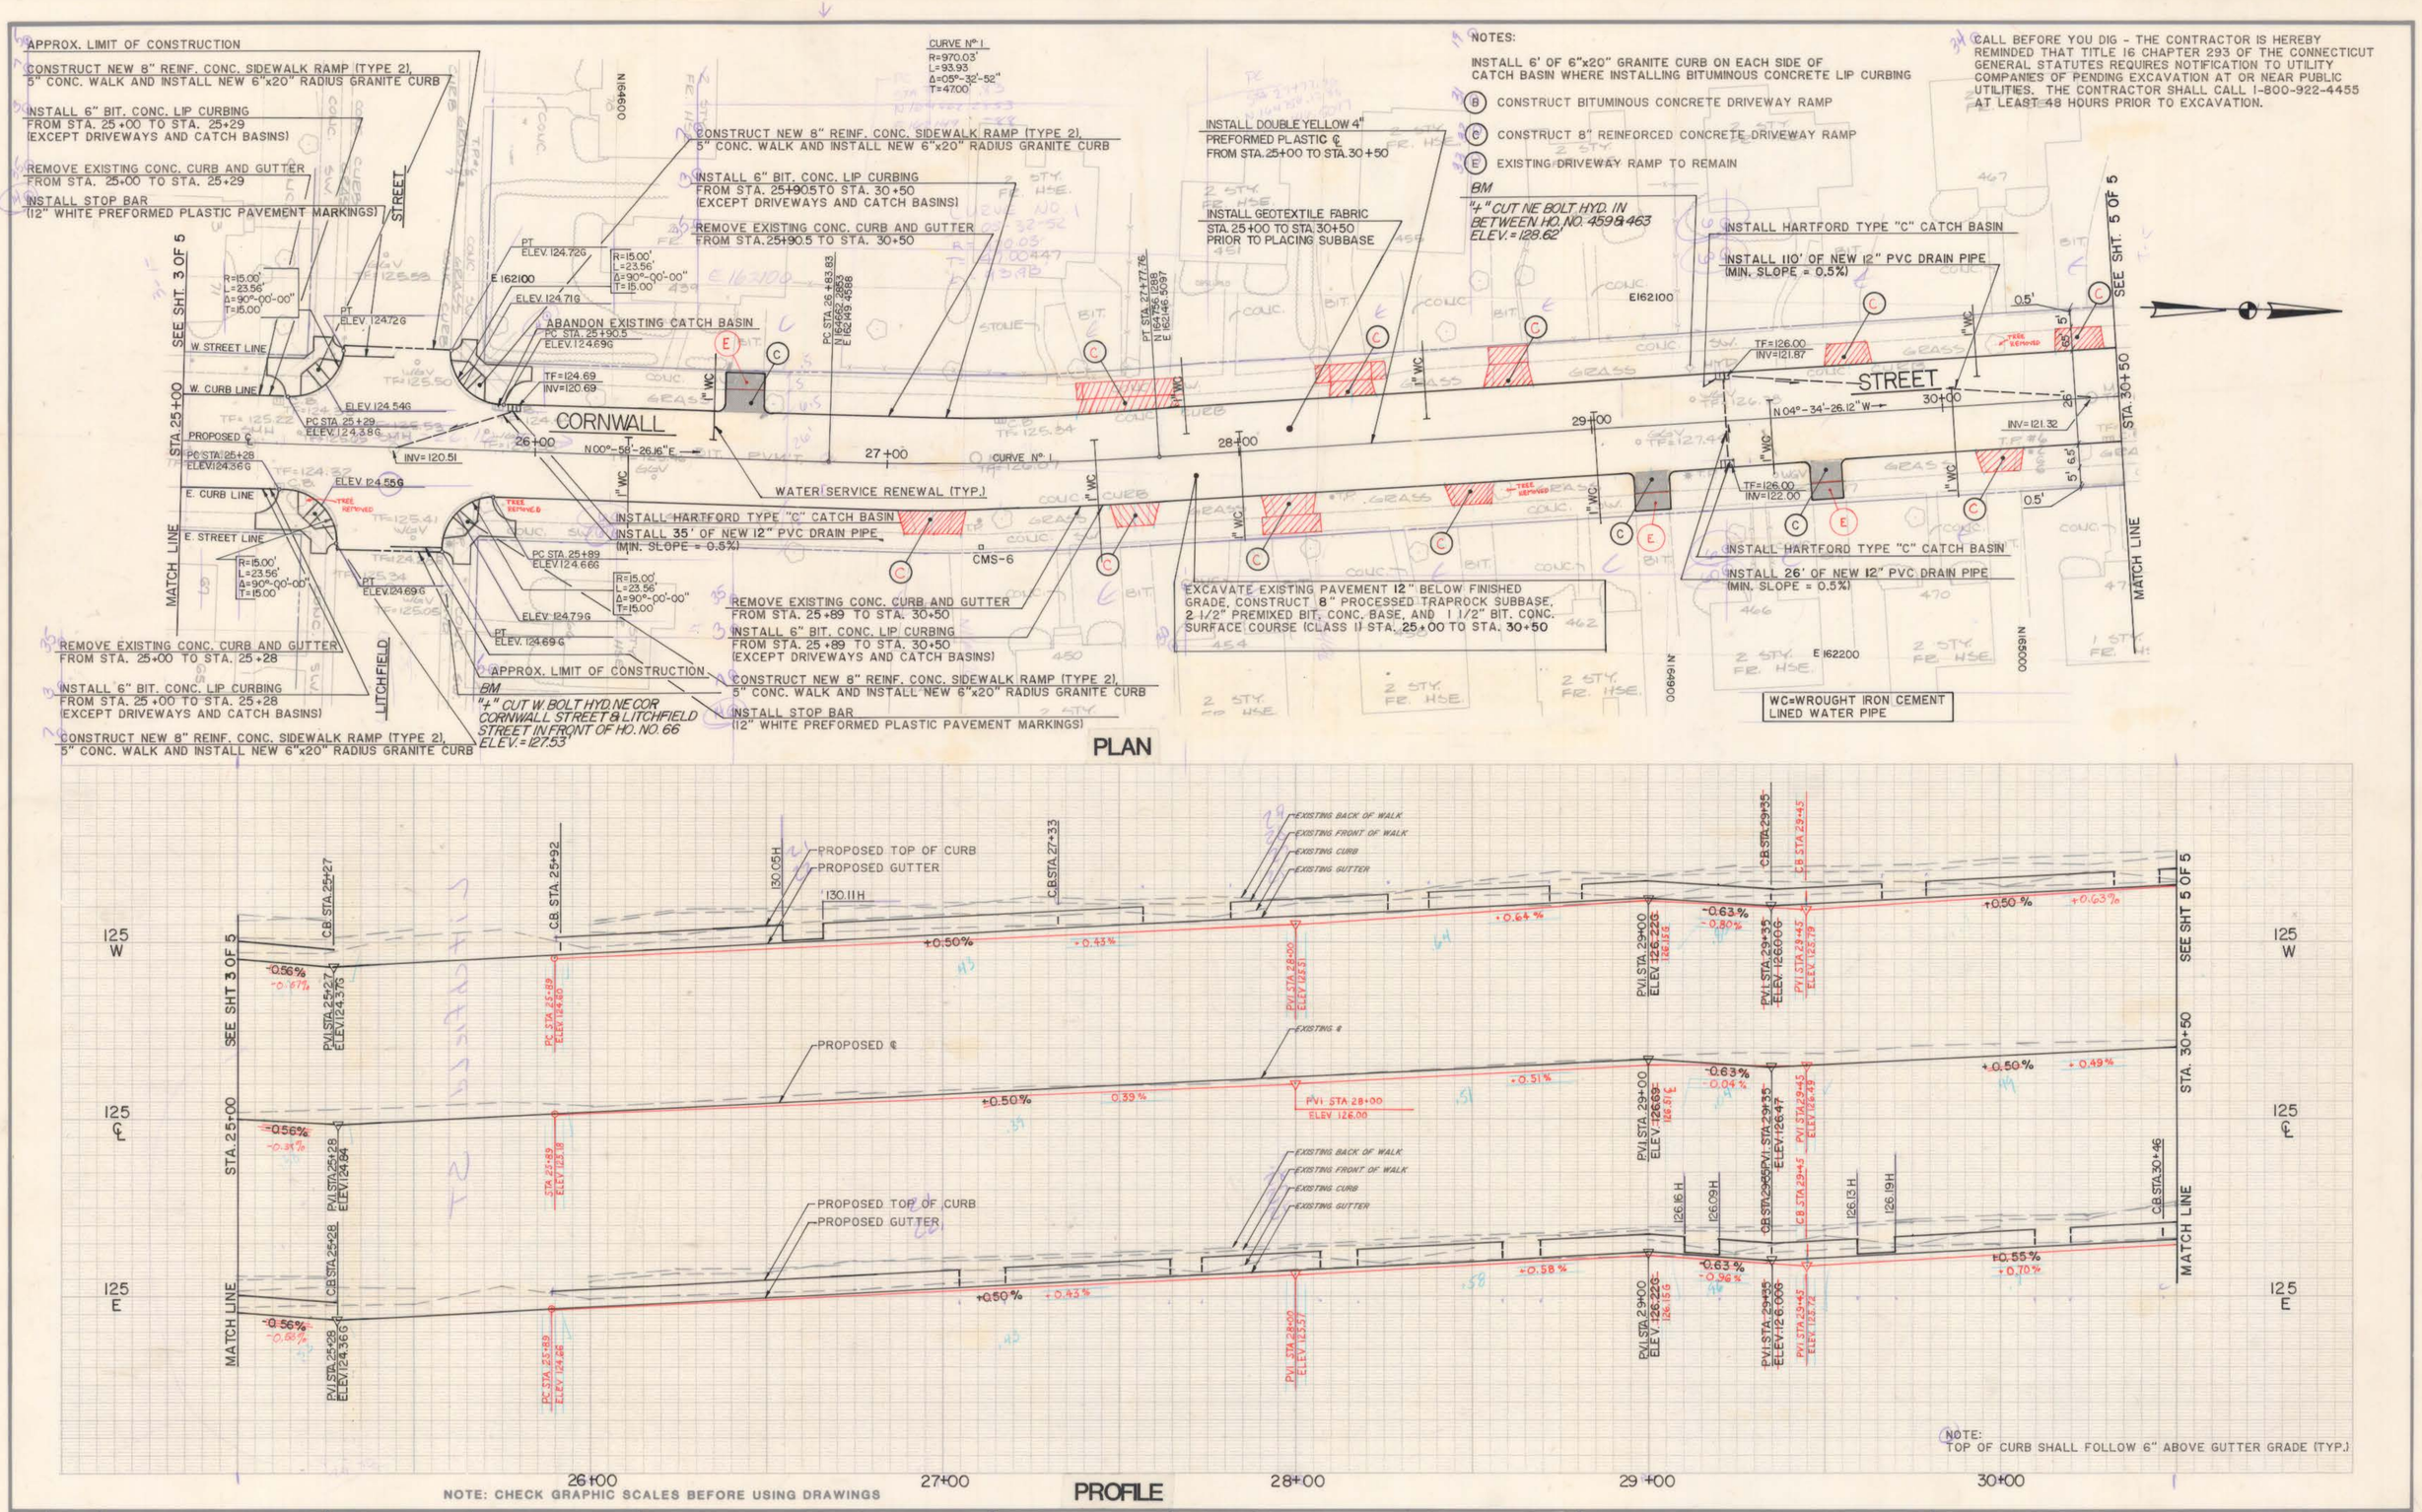

NOTE: CHECK GRAPHIC SCALES BEFORE USING DRAWINGS

NO.	DATE	DESCRIPTION
	JAN 87	CHECKED BY MDH
		AS-BUILT BY RHP

REVISIONS

SUPV. ARW
DESIGN MDH/AEC
DRAWN KHT
CHECKED JAC
DATE 6/17/85

GRAPHIC SCALES
HORIZ. 1" = 20'
VERT. 1" = 2'

ROADWAY RECONSTRUCTION
HARTFORD, CONNECTICUT

STATE OF CONNECTICUT REGISTERED PROFESSIONAL ENGINEER NO. 10806

Hayden | Wegman
Consulting Engineers
WEST HARTFORD
NEW YORK • BOSTON • BUFFALO
ATLANTA • MEMPHIS

CITY OF HARTFORD, CONNECTICUT
DEPARTMENT OF PUBLIC WORKS
BUREAU OF ENGINEERING SERVICES

DRAWN
CHECKED
SCALE
DAYBOOK NO. 010948
DATE

CORNWALL STREET
STA. 25-00 TO STA. 30-50
PLAN AND PROFILE
Contract # E85-29 Job No.- 845304
SHEET 4 OF 5

575/1 D