
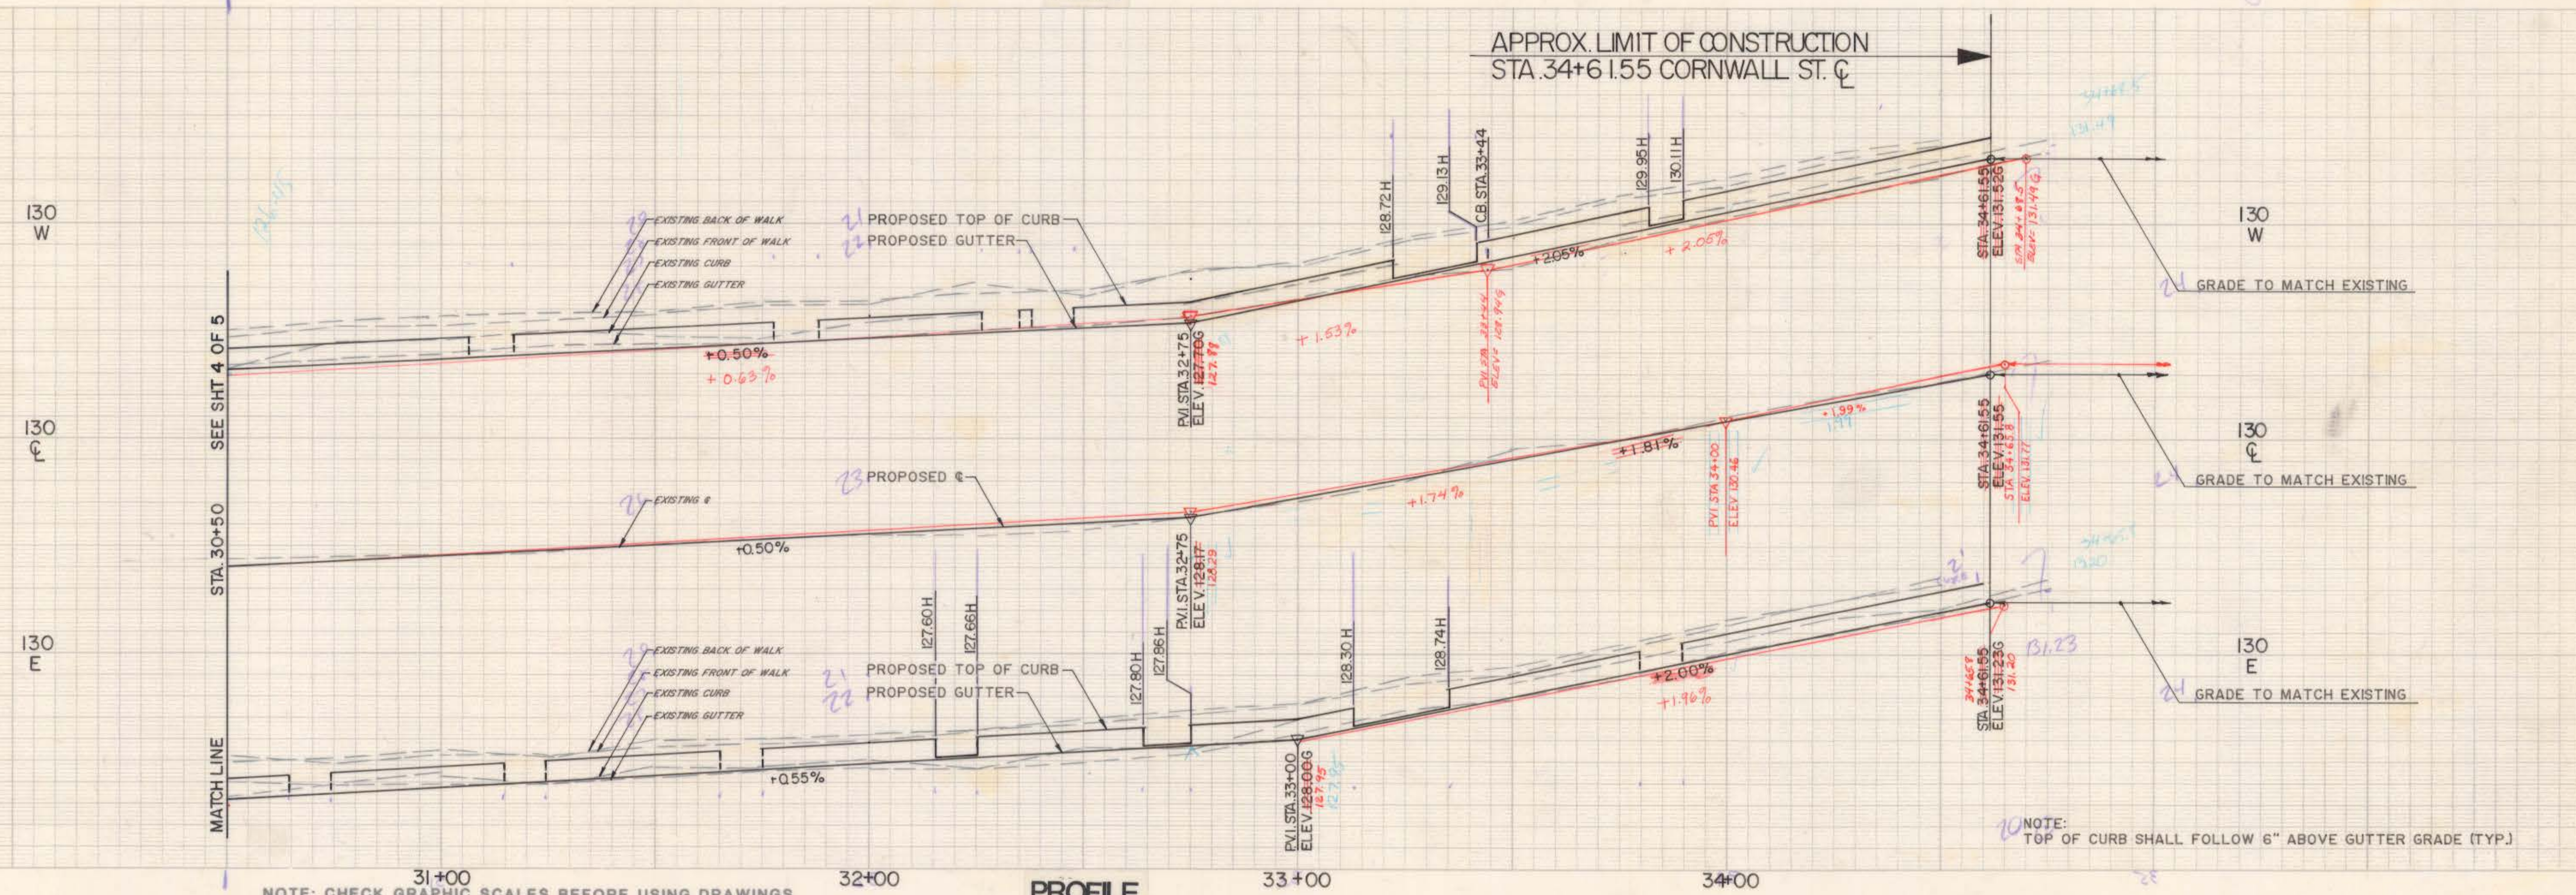


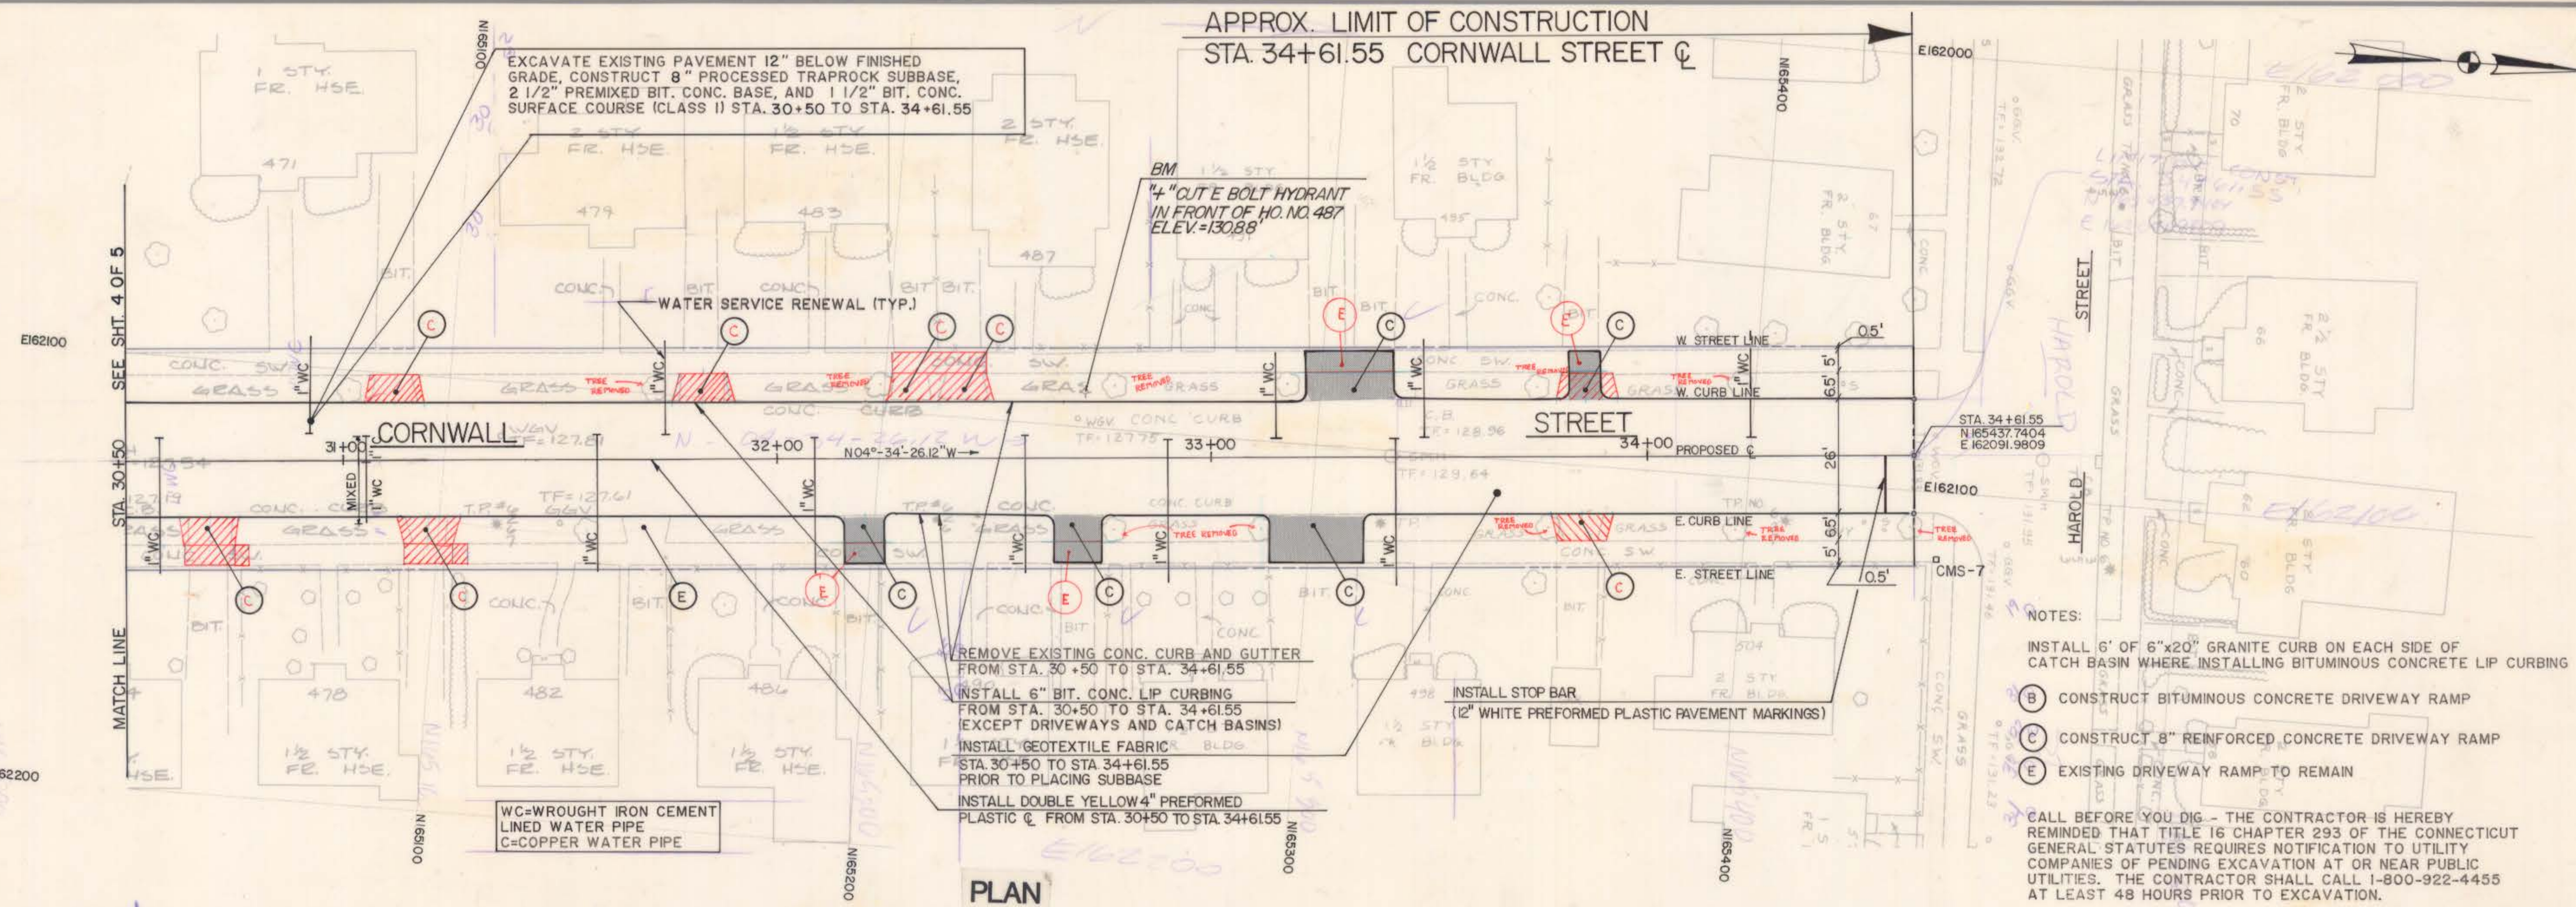

SUPV. ARW DESIGN MDH/AEC DRAWN JEM, KHT, JCB CHECKED JAC DATE 6/17/85		GRAPHIC SCALES HORIZ. 1" = 20' VERT. 1" = 2'		ROADWAY RECONSTRUCTION HARTFORD, CONNECTICUT				Hayden Wegman Consulting Engineers WEST HARTFORD NEW YORK • BOSTON • BUFFALO ATLANTA • MEMPHIS		CITY OF HARTFORD, CONNECTICUT DEPARTMENT OF PUBLIC WORKS BUREAU OF ENGINEERING SERVICES		CORNWALL STREET STA. 30-50 TO STA. 34-61.55		PLAN AND PROFILE SHEET 5	
REVISIONS NO. DATE DESCRIPTION								DRAWN _____ CHECKED _____		SCALE _____ DATE _____		DAYBOOK NO 010948 Contract # E85-29 Job No. - 845304		OF 5	