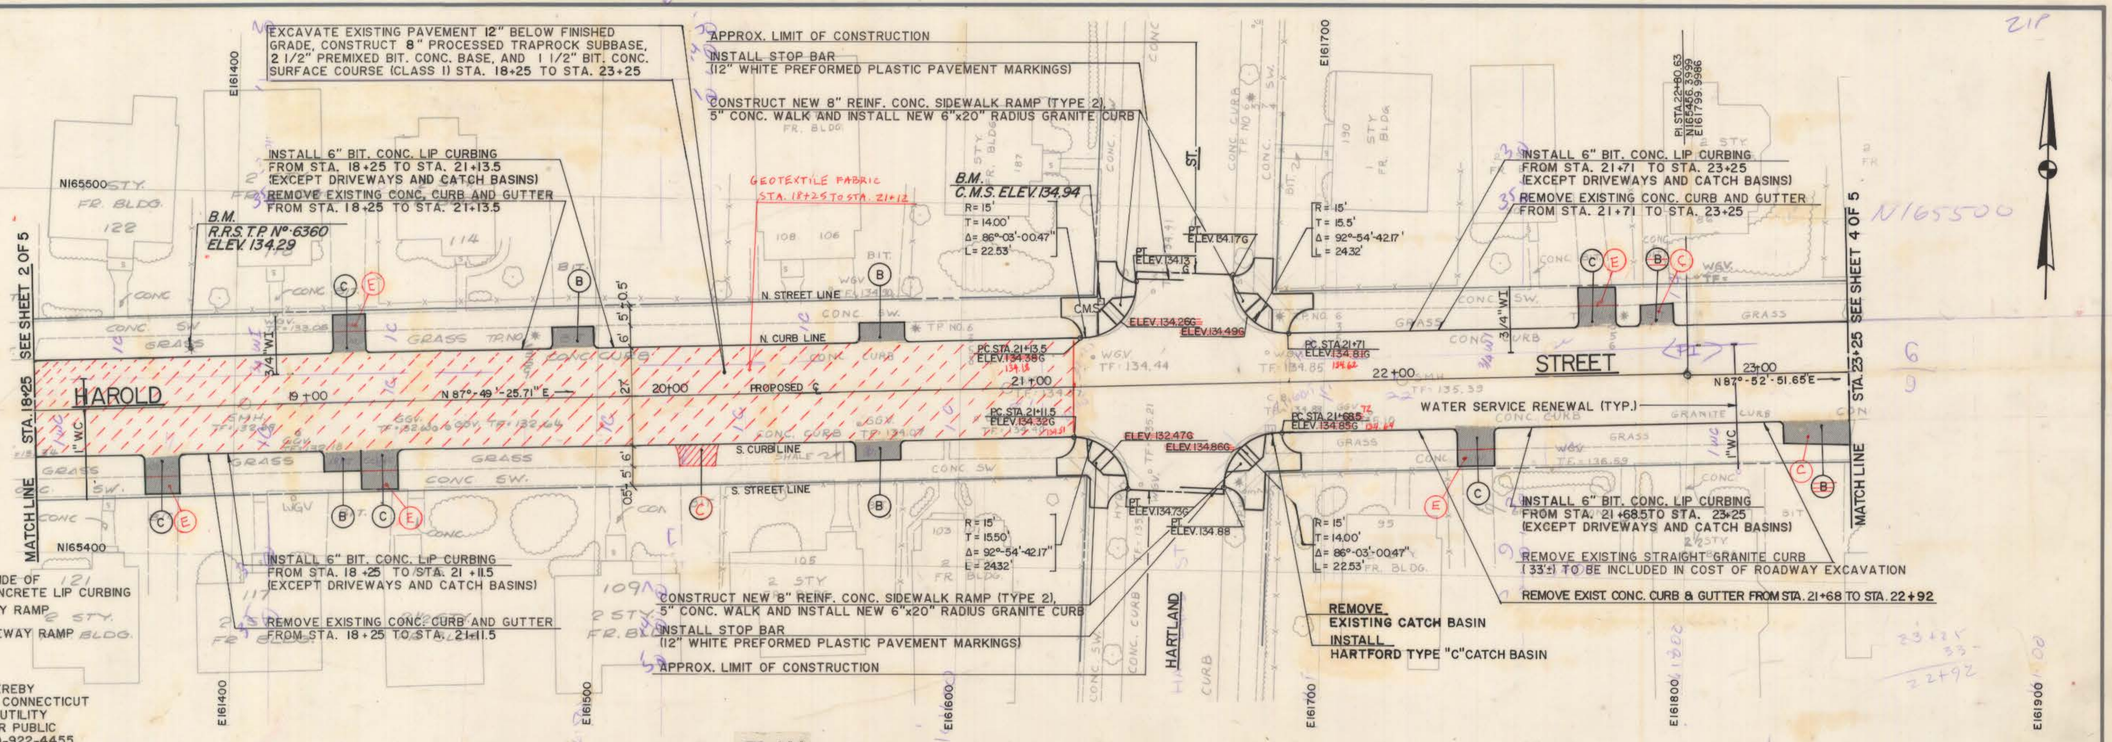

NOTES:

INSTALL 6' OF 6"x20" GRANITE CURB ON EACH SIDE OF CATCH BASIN WHERE INSTALLING BITUMINOUS CONCRETE LIP CURBING

(B) CONSTRUCT BITUMINOUS CONCRETE DRIVEWAY RAMP

(C) CONSTRUCT 8" REINFORCED CONCRETE DRIVEWAY RAMP

(E) EXISTING DRIVEWAY RAMP TO REMAIN

(S) CONSTRUCT 8" REINF. CONC. SIDEWALK

CALL BEFORE YOU DIG - THE CONTRACTOR IS HEREBY REMINDED THAT TITLE 16 CHAPTER 293 OF THE CONNECTICUT GENERAL STATUTES REQUIRES NOTIFICATION TO UTILITY COMPANIES OF PENDING EXCAVATION AT OR NEAR PUBLIC UTILITIES. THE CONTRACTOR SHALL CALL 1-800-922-4455 AT LEAST 48 HOURS PRIOR TO EXCAVATION.

PLAN

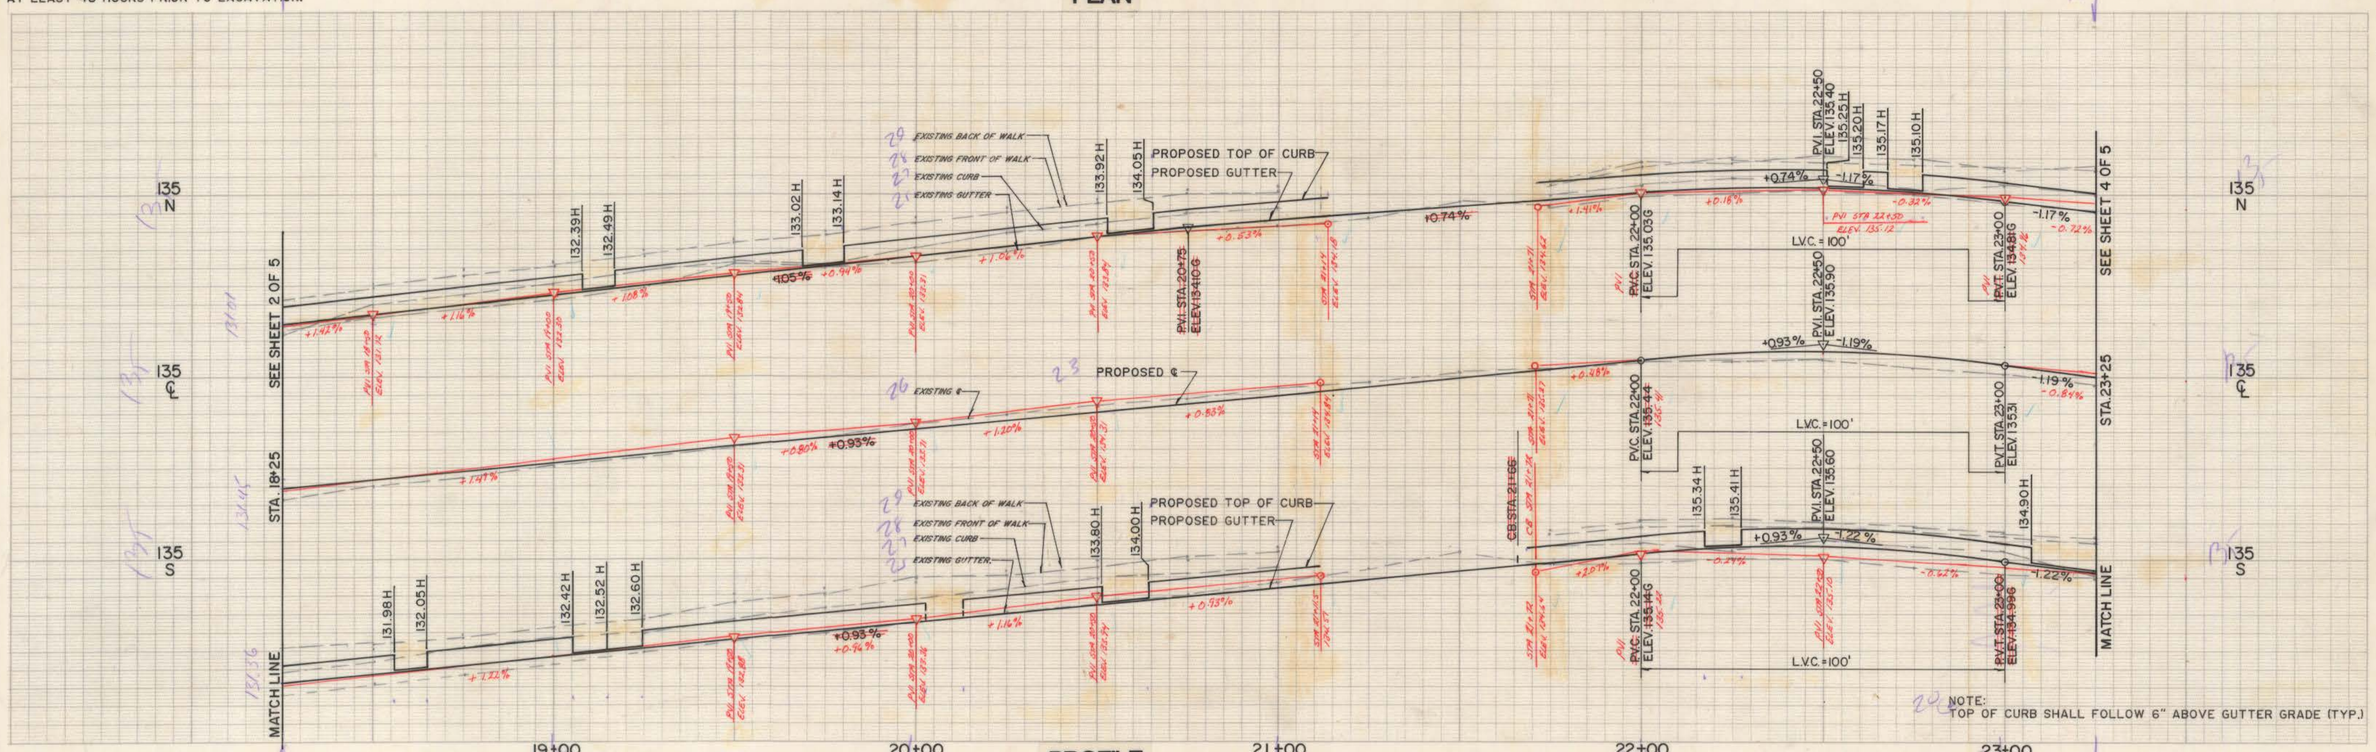

NOTE: TOP OF CURB SHALL FOLLOW 6" ABOVE GUTTER GRADE (TYP.)

NOTE: CHECK GRAPHIC SCALES BEFORE USING DRAWINGS

PROFILE

NO.	DATE	DESCRIPTION
3	1/27/87	ADD GEO-TEX · AS BUILTS · DRAFTED BY: MJK
2	7/30/86	CHECKED BY: MDH
1	7/17/86	AS BUILT BY: MDH

REVISIONS

SUPV. ARW
DESIGN MDH/AEC
DRAWN OSI
CHECKED JAC
DATE 6/17/85

GRAPHIC SCALES
HORIZ. 1" = 20'
VERT. 1" = 2'

ROADWAY RECONSTRUCTION
HARTFORD, CONNECTICUT

STATE OF CONNECTICUT · ALAN R. WEGMAN · No. 10606 · REGISTERED PROFESSIONAL ENGINEER

Hayden | Wegman
Consulting Engineers
WEST HARTFORD
NEW YORK • BOSTON • BUFFALO
ATLANTA • MEMPHIS

CITY OF HARTFORD, CONNECTICUT
DEPARTMENT OF PUBLIC WORKS
BUREAU OF ENGINEERING SERVICES

DRAWN ____ CHECKED ____ SCALE ____ DAYBOOK NO. 010948 DATE ____

HAROLD STREET
STA. 18-25 TO STA. 23-25

PLAN AND PROFILE
Contract E85-29 Job No.- 845304

SHEET 3 OF 5