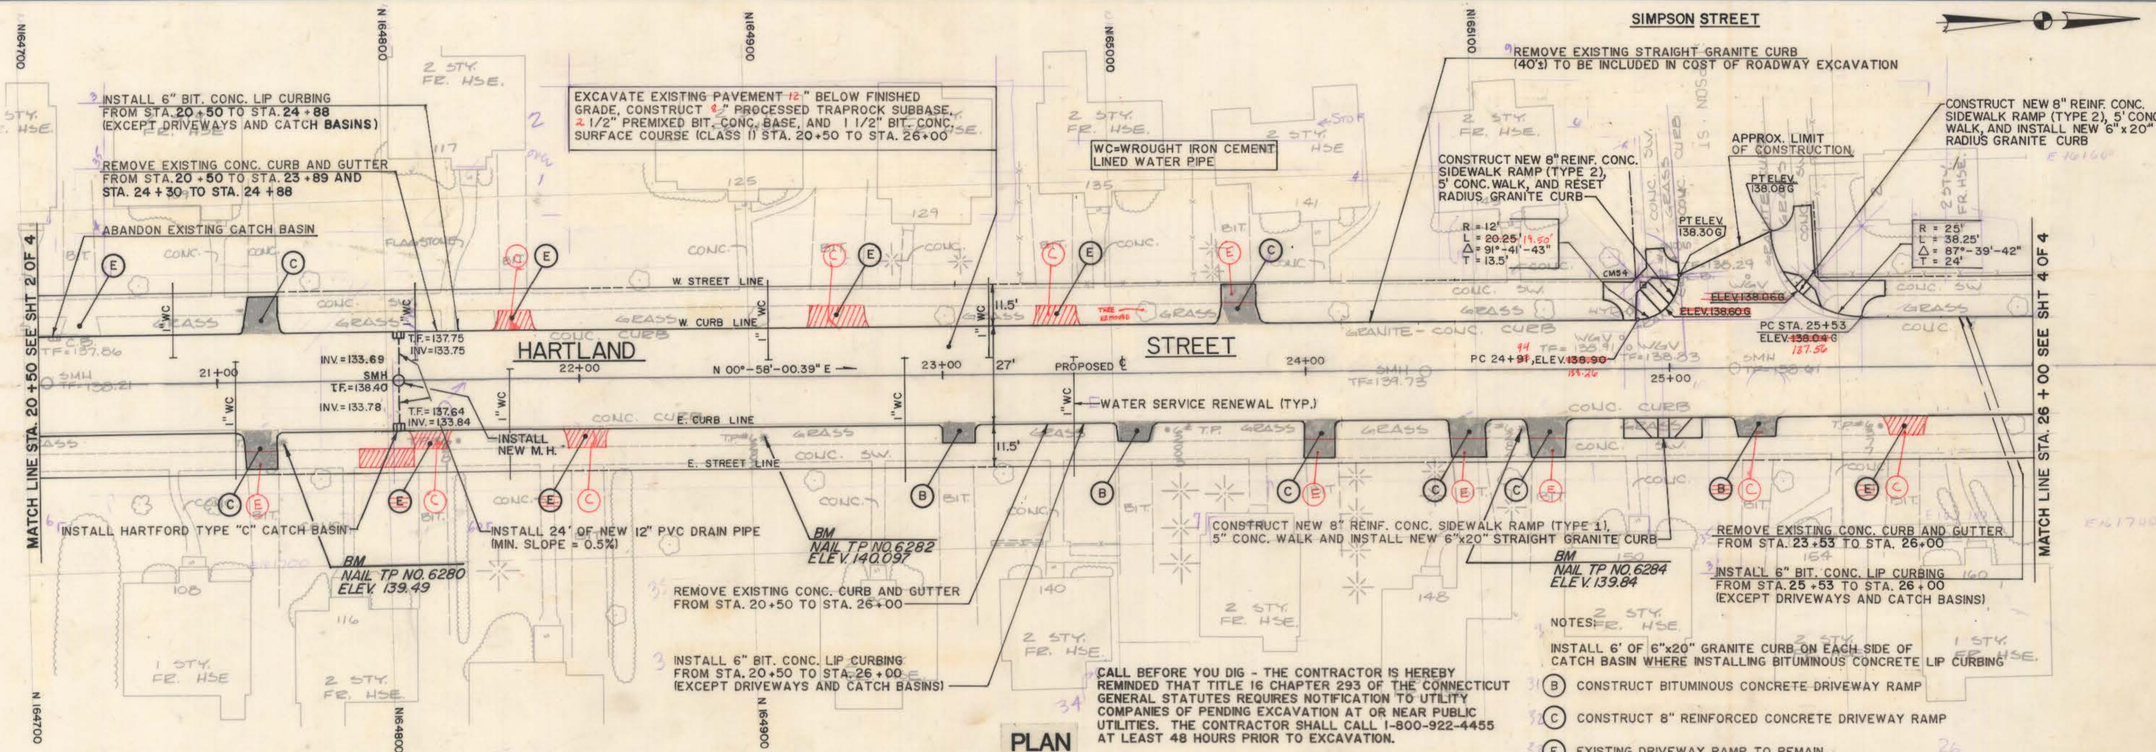

NO.	DATE	DESCRIPTION
	JAN 87	CHECKED BY MDH
	JAN 87	AS-BUILT BY RSL

REVISIONS

SUPV. ARW
DESIGN MDH / AEC
DRAWN
CHECKED JAC
DATE 6/17/85

GRAPHIC SCALES
HORIZ. 1" = 20'
VERT. 1" = 2'

ROADWAY RECONSTRUCTION
HARTFORD, CONNECTICUT

Hayden | Wegman
Consulting Engineers
WEST HARTFORD
NEW YORK • BOSTON • BUFFALO
ATLANTA • MEMPHIS

CITY OF HARTFORD, CONNECTICUT
DEPARTMENT OF PUBLIC WORKS
BUREAU OF ENGINEERING SERVICES

DRAWN
CHECKED
SCALE
DAYBOOK NO. 010948
DATE

HARTLAND STREET
STA. 20-50 TO STA. 26-00

PLAN AND PROFILE
Contract # E85-29 Job No.- 845304

SHEET 3 OF 4