
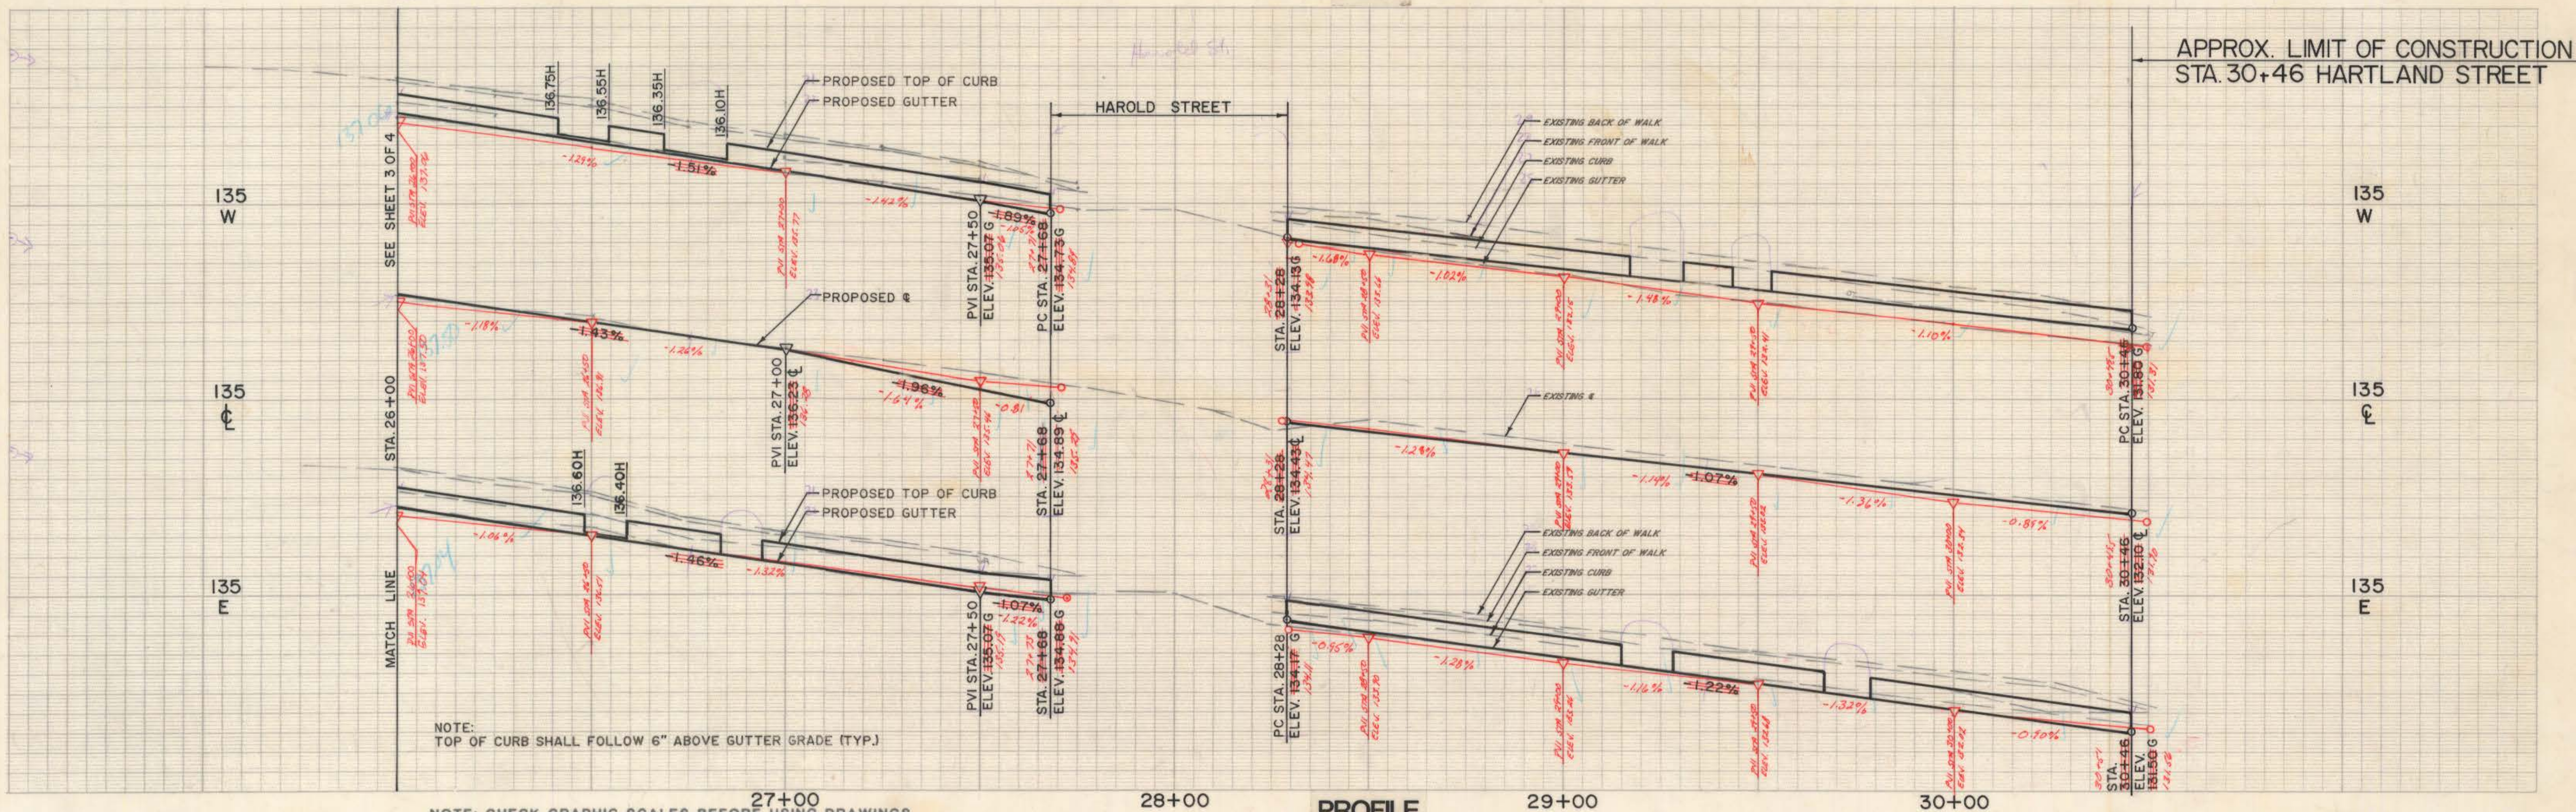


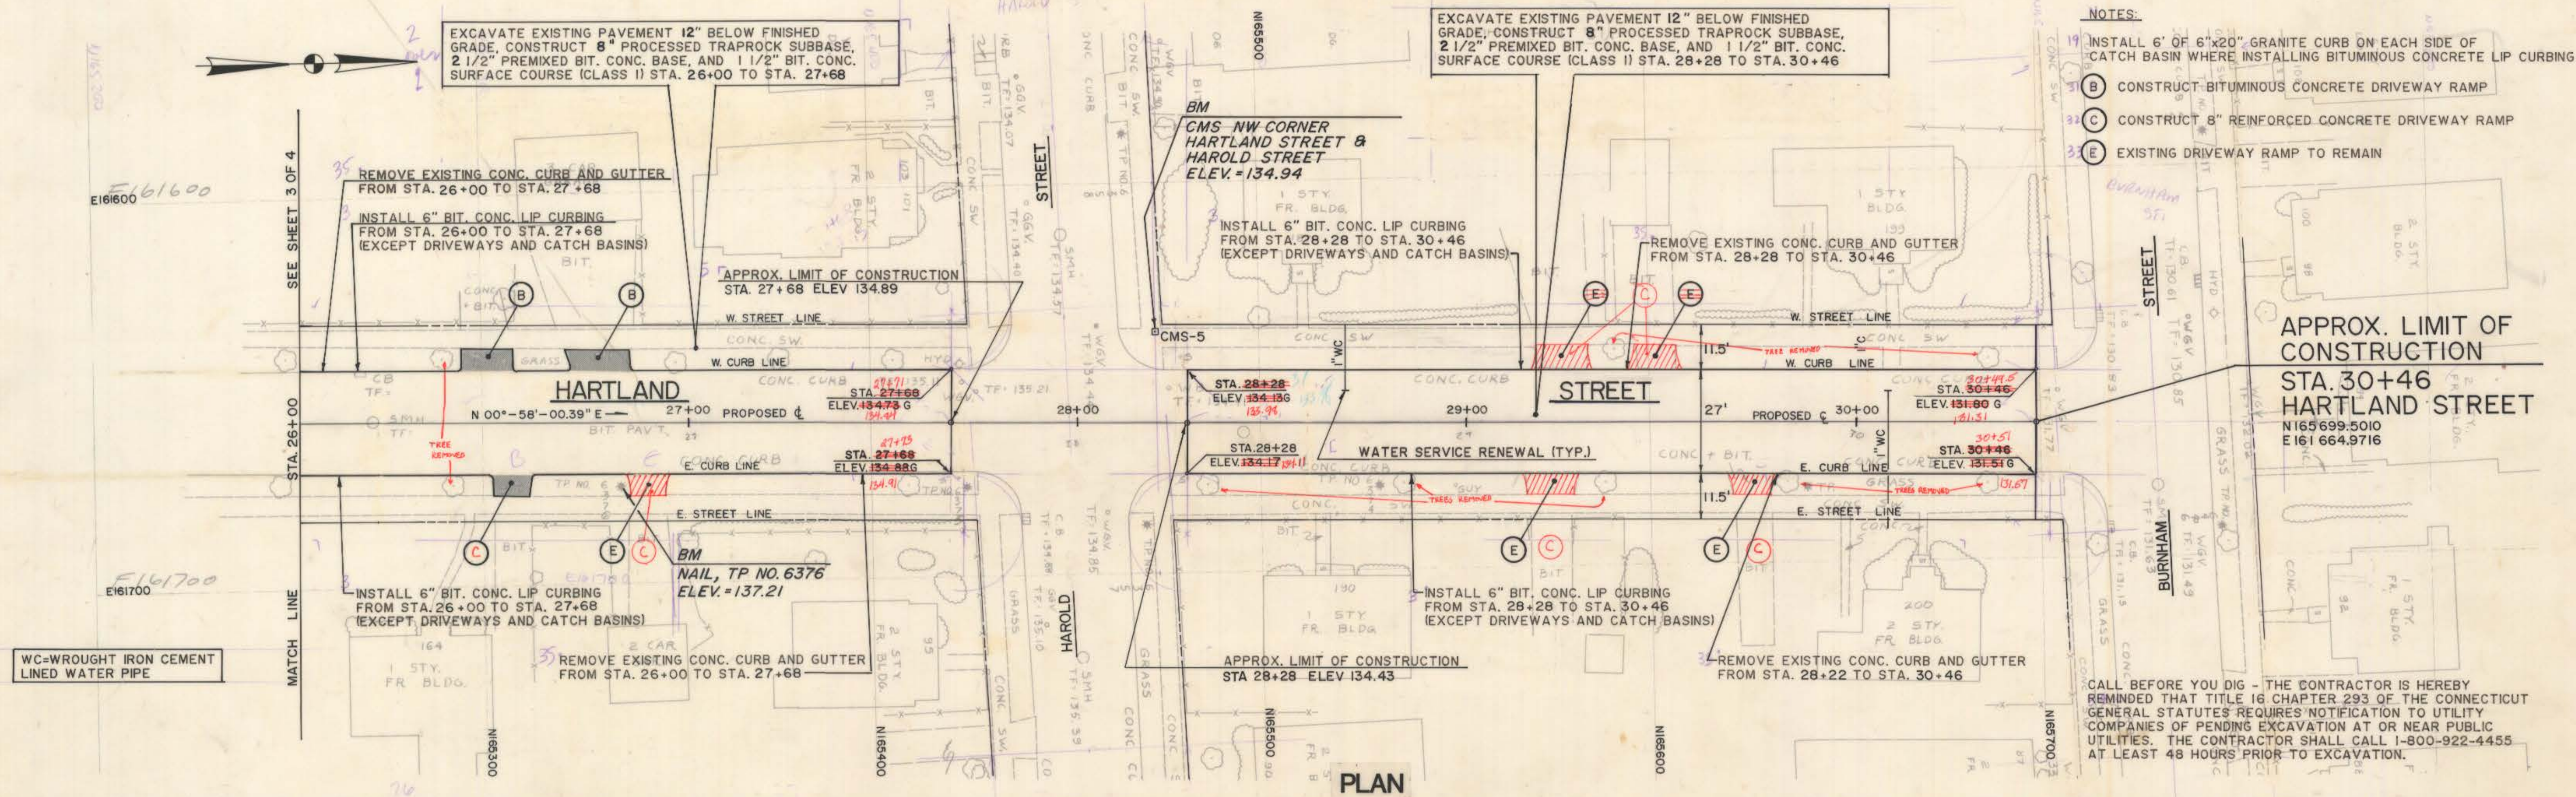

SUPV. ARW DESIGN MPH/AEC DRAWN CHECKED JAC DATE 6/17/85		GRAPHIC SCALES HORIZ. 1" = 20' VERT. 1" = 2'		ROADWAY RECONSTRUCTION HARTFORD, CONNECTICUT		CITY OF HARTFORD, CONNECTICUT DEPARTMENT OF PUBLIC WORKS BUREAU OF ENGINEERING SERVICES		HARTLAND STREET STA. 26+00 TO STA. 30+46		PLAN AND PROFILE Contract # E85-29 Job No. - 845304 OF 4	
NO. 1 DATE 6/17/85 DESCRIPTION CHECKED BY MPH AG-BDICT BY DATE				WEST HARTFORD NEW YORK • BOSTON • BUFFALO ATLANTA • MEMPHIS		SCALE DAYBOOK NO 010948 DATE				SHEET 4	