



EXCAVATE EXISTING PAVEMENT 12" BELOW FINISHED GRADE, CONSTRUCT 8" PROCESSED TRAPROCK SUBBASE, 2 1/2" PREMIXED BIT. CONC. BASE, AND 1 1/2" BIT. CONC. SURFACE COURSE (CLASS 1) STA. 9+99.5 TO STA. 15+50

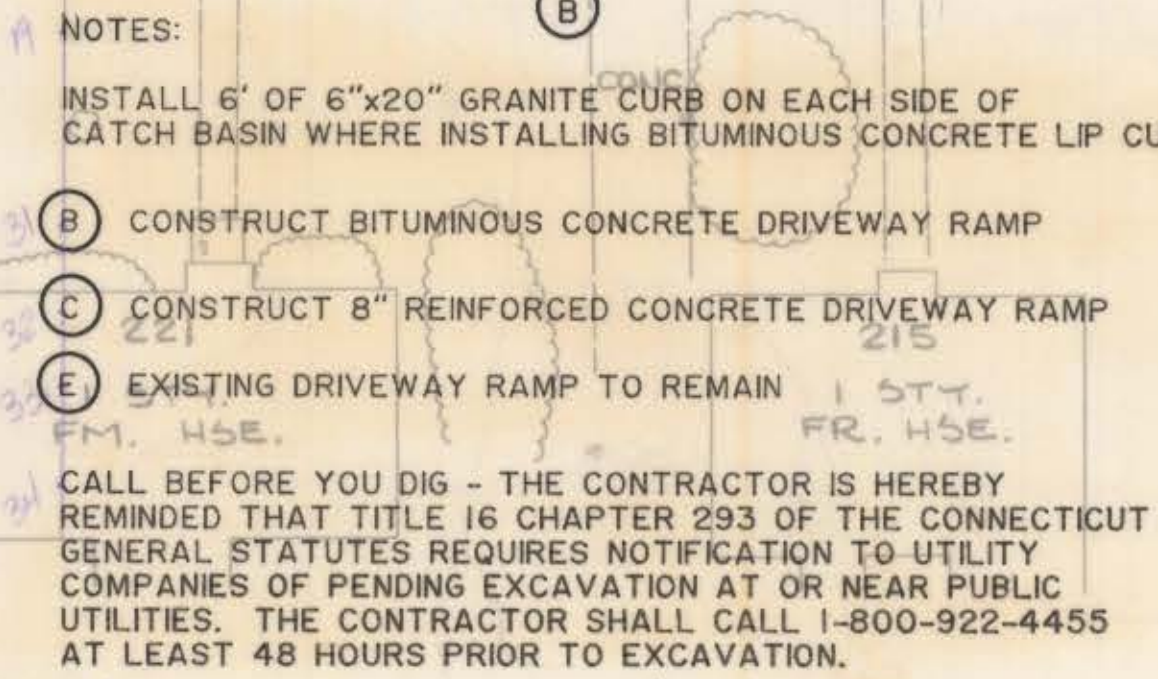

P OF CURB SHALL FOLLOW 6" ABOVE GUTTER GRADE (TYPE

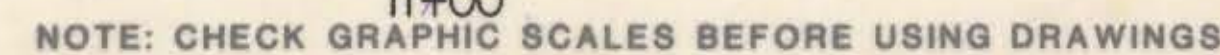

Professional Engineer Seal for Weng, State of Connecticut, No. 10608.

WEST HARTFORD
NEW YORK • BOSTON • BUFFALO
ATLANTA • MEMPHIS

DRAWN _____	SCALE _____	DAYBOOK NO. 010948
CHECKED _____		DATE _____

Contract # E85-29	Job No. - 845304
-------------------	------------------

SHEET 1

OF 44

3	10/21/87	ADD GEO-TEX DRAFTED BY MDH
2	(NAME)	CHECKED BY MDH
1	DON \$6	AG - BUILD
NO.	DATE	DESCRIPTION
REVISIONS		