


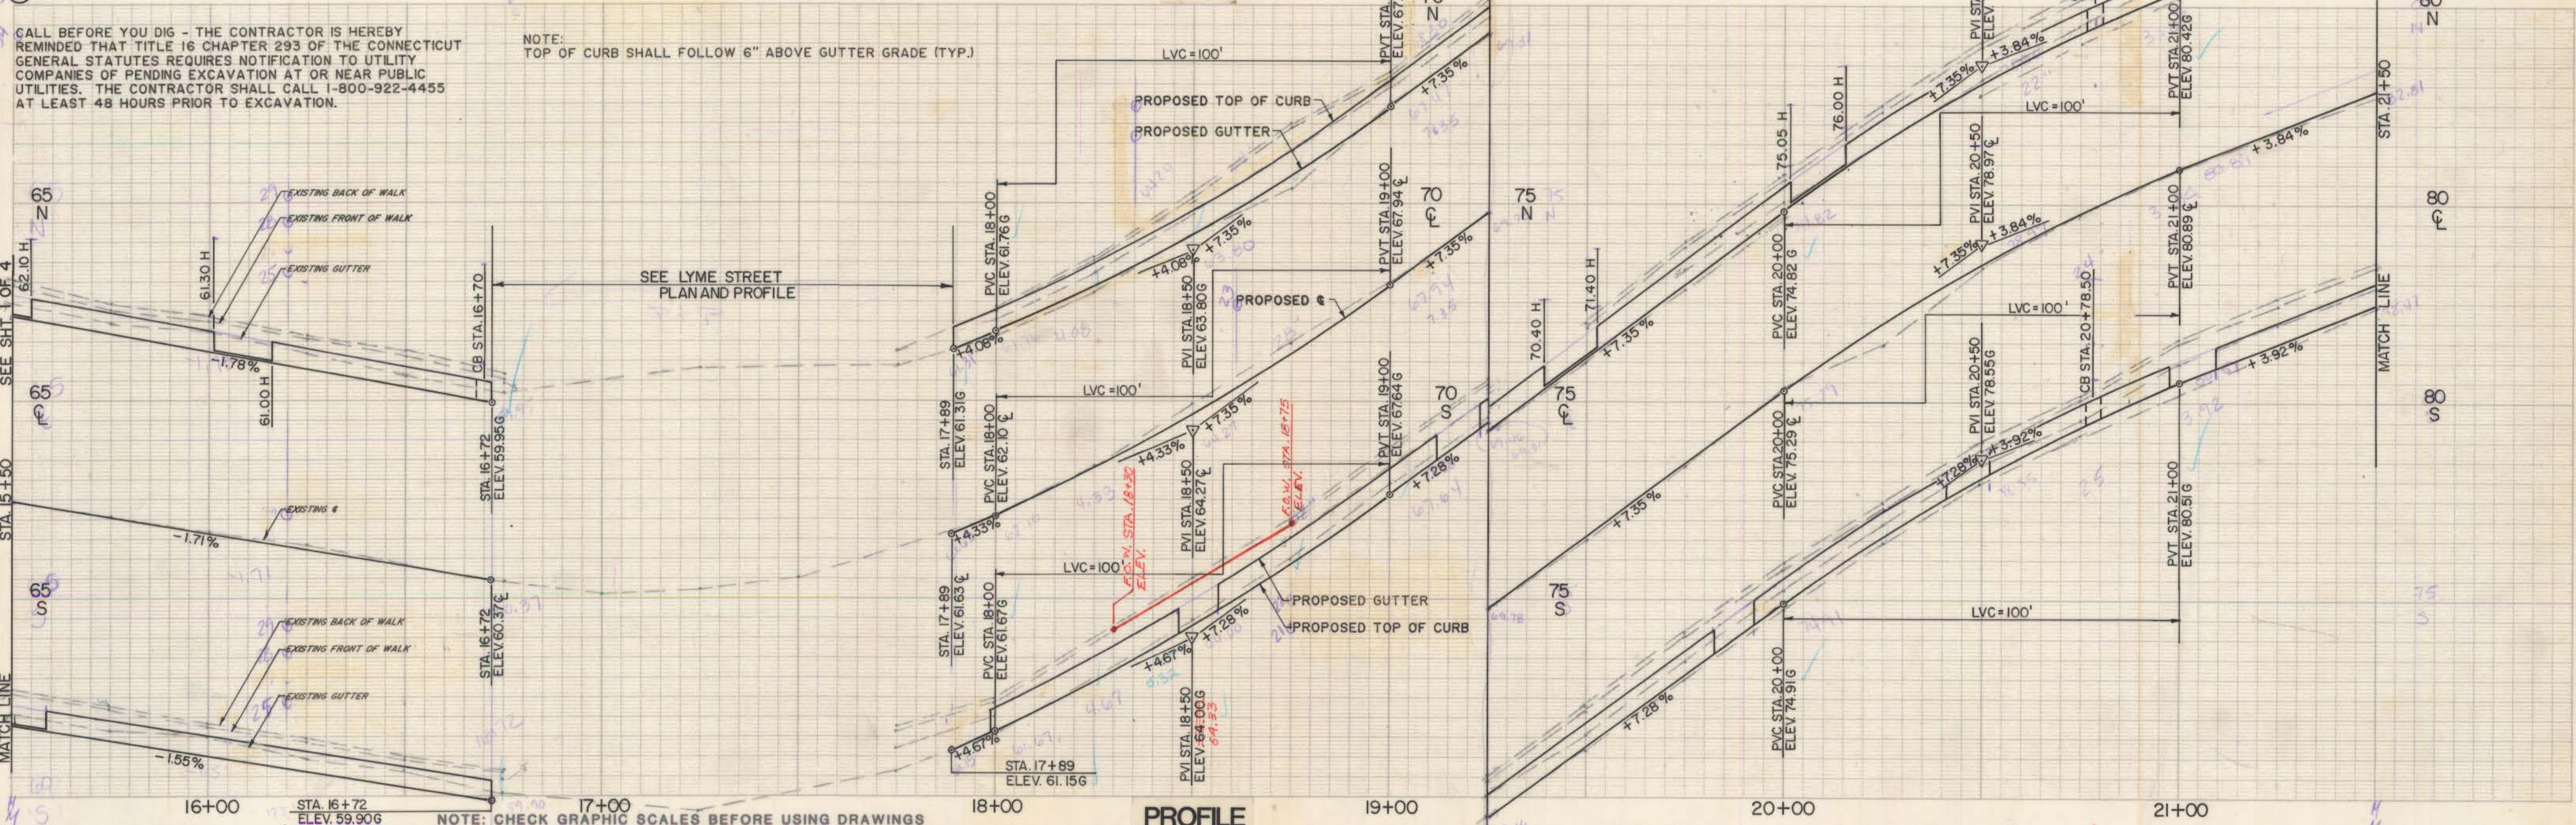

		SUPV.	ARW	GRAPHIC SCALES		CITY OF HARTFORD, CONNECTICUT DEPARTMENT OF PUBLIC WORKS BUREAU OF ENGINEERING SERVICES	PEMBROKE STREET <i>PEMBROKE ST.</i> STA. 15+50 TO STA. 21+50	
		DESIGN	M.D.H./A.E.	HORIZ. 1" = 20'	ROADWAY RECONSTRUCTION HARTFORD, CONNECTICUT	Hayden Wegman Consulting Engineers		
		DRAWN	KHT	VERT. 1" = 2'				
		CHECKED	JAC				PLAN AND PROFILE	
		DATE	6/17/85				SHEET 22	
		REVISIONS					Contract # E85-29 Job No.- 845304 OF 44	