

EXCAVATE EXISTING PAVEMENT 12" BELOW FINISHED GRADE, CONSTRUCT 8" PROCESSED TRAPROCK SUBBASE, 2 1/2" PREMIXED BIT. CONC. BASE, AND 1 1/2" BIT-CONC. SURFACE COURSE (CLASS I) STA. 27+50 TO STA. 33+25.05

INSTALL 6" BIT. CONC. LIP CURBING FROM STA. 27+50 TO STA. 32+99 (EXCEPT DRIVEWAYS AND CATCH BASINS)
REMOVE EXISTING CONC. CURB AND GUTTER FROM STA. 27+50 TO STA. 32+99

INSTALL 6" BIT. CONC. LIP CURBING FROM STA. 27+50 TO STA. 33+08 (EXCEPT DRIVEWAYS AND CATCH BASINS)
REMOVE EXISTING CONC. CURB AND GUTTER FROM STA. 27+50 TO STA. 33+08


WC=WROUGHT IRON CEMENT LINED WATER PIPE

INSTALL GEOTEXTILE FABRIC STA 27+50 TO STA 32+99

APPROX. LIMIT OF CONSTRUCTION STA. 33+25.05 PEMBROKE STREET

CONSTRUCT NEW 8" REINF. CONC. SIDEWALK RAMP (TYPE 2), 5" CONC. WALK AND RESET RADIUS GRANITE CURB

REPLACE CURB
CONSTRUCT NEW 8" REINF. CONC. SIDEWALK RAMP (TYPE 2), 5" CONC. WALK AND INSTALL NEW 6"x20" RADIUS GRANITE CURB

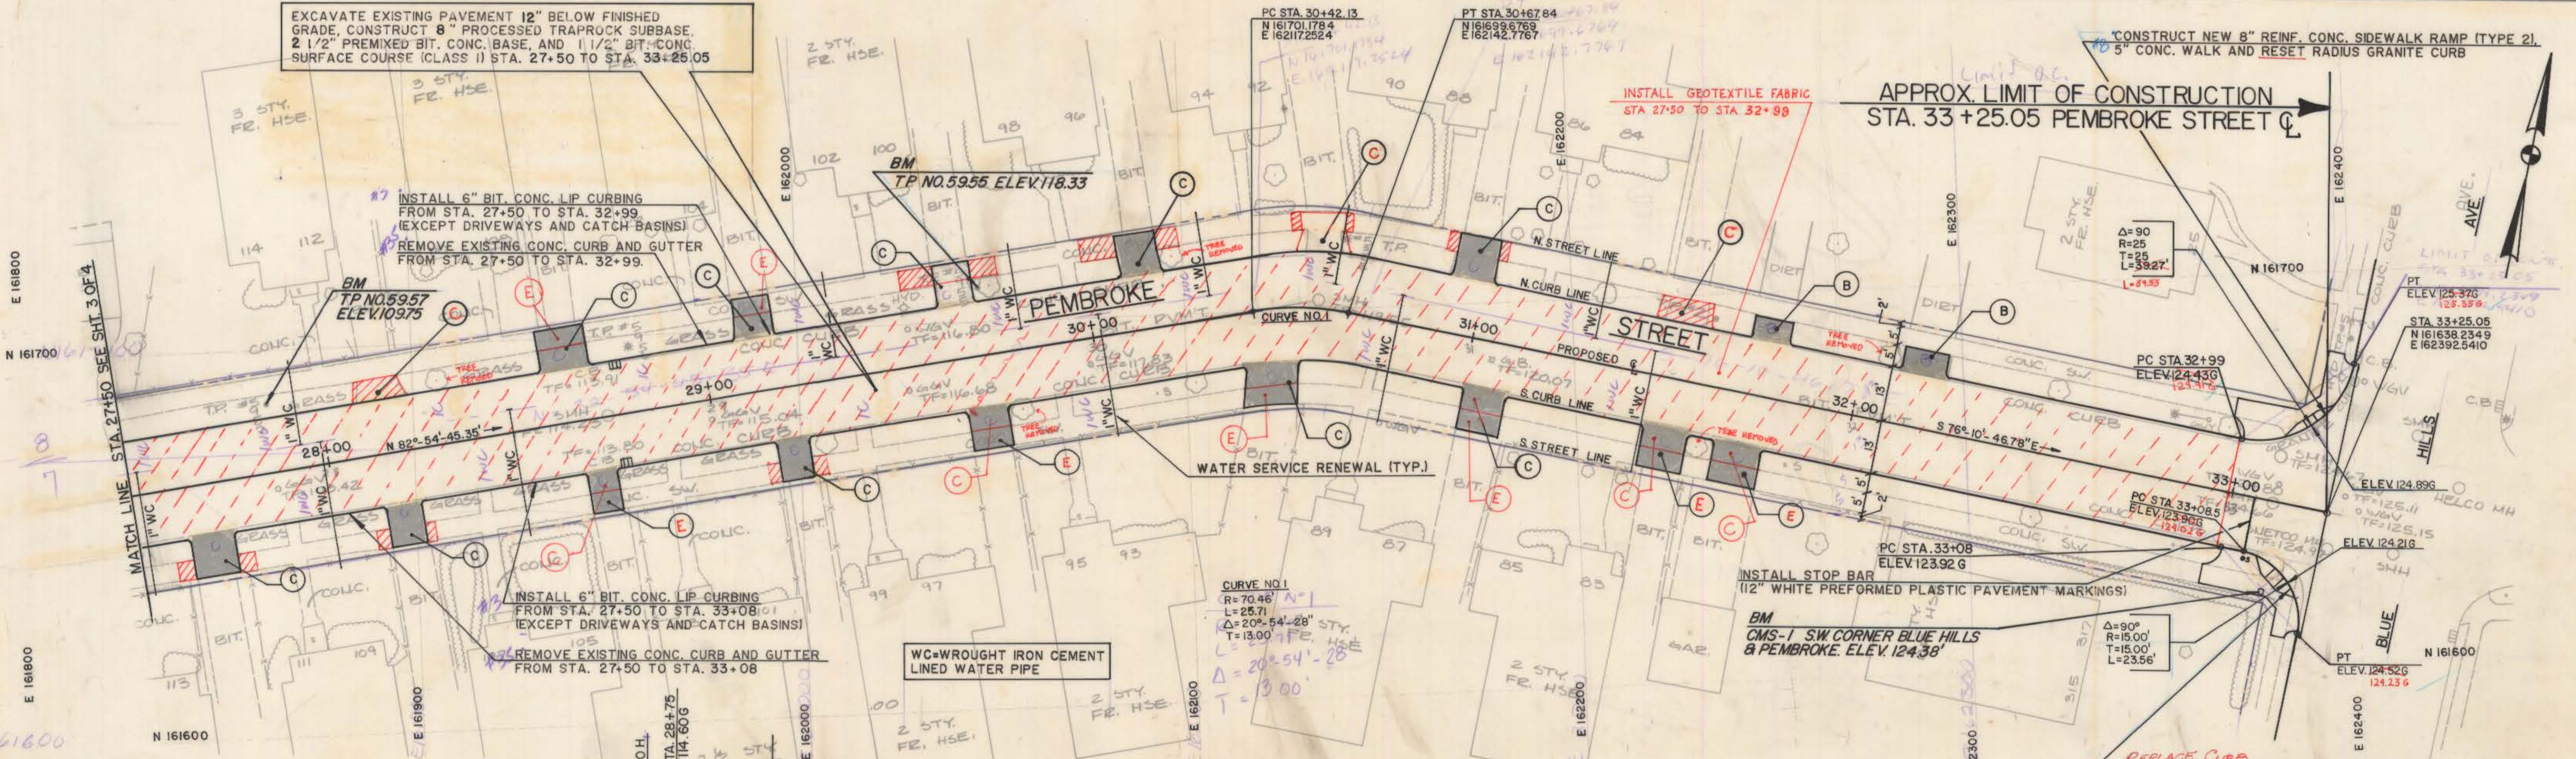


PLAN

NOTES:

- INSTALL 6" OF 6"x20" GRANITE CURB ON EACH SIDE OF CATCH BASIN WHERE INSTALLING BITUMINOUS CONCRETE LIP CURBING
- CONSTRUCT BITUMINOUS CONCRETE DRIVEWAY RAMP
- CONSTRUCT 8" REINFORCED CONCRETE DRIVEWAY RAMP
- EXISTING DRIVEWAY RAMP TO REMAIN

CALL BEFORE YOU DIG - THE CONTRACTOR IS HEREBY REMINDED THAT TITLE 16 CHAPTER 293 OF THE CONNECTICUT GENERAL STATUTES REQUIRES NOTIFICATION TO UTILITY COMPANIES OF PENDING EXCAVATION AT OR NEAR PUBLIC UTILITIES. THE CONTRACTOR SHALL CALL 1-800-922-4455 AT LEAST 48 HOURS PRIOR TO EXCAVATION.

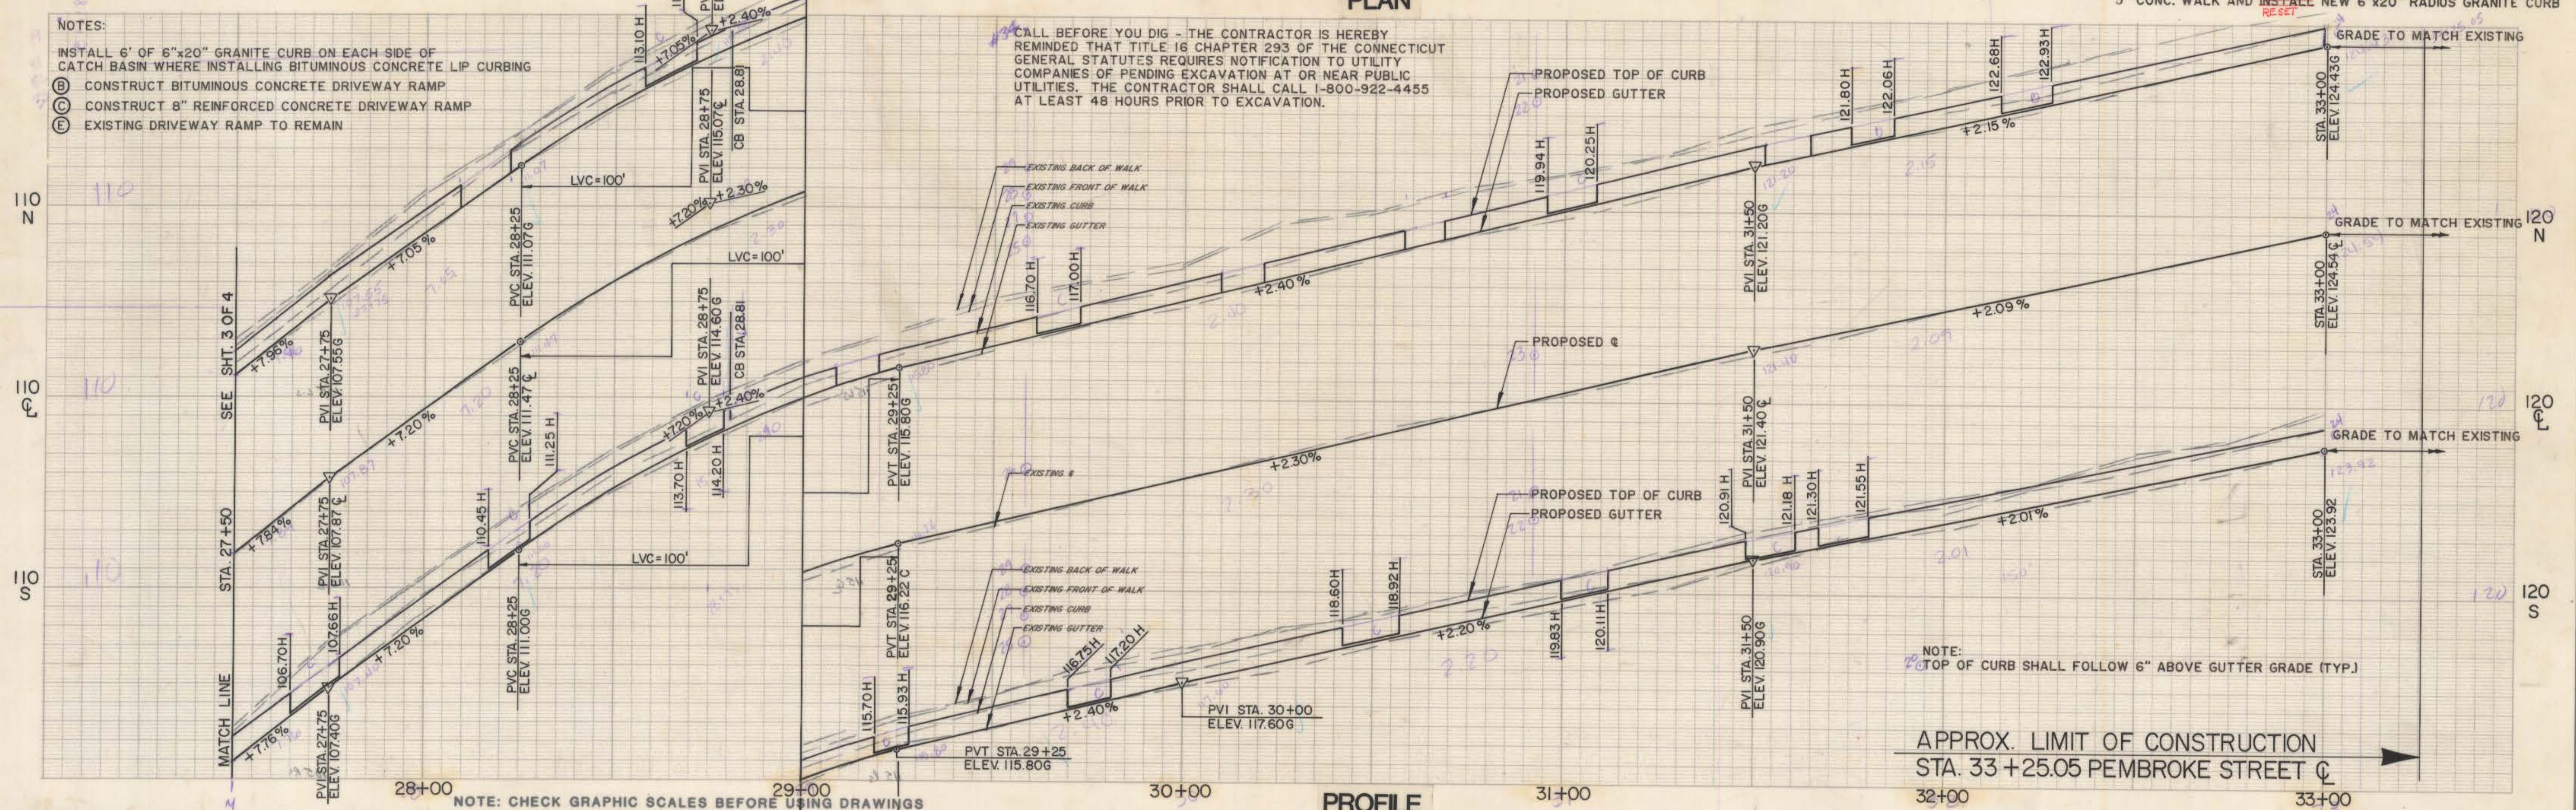

PROFILE

NOTE: CHECK GRAPHIC SCALES BEFORE USING DRAWINGS

NO. 1 DATE		REVISIONS		SUPV. ARW DESIGN MDH/AEC DRAWN M. J. / KMT CHECKED JAC DATE 6/17/85		GRAPHIC SCALES HORIZ. 1"=20' VERT. 1"=2'		ROADWAY RECONSTRUCTION HARTFORD, CONNECTICUT				Hayden Wegman Consulting Engineers WEST HARTFORD NEW YORK • BOSTON • BUFFALO ATLANTA • MEMPHIS		CITY OF HARTFORD, CONNECTICUT DEPARTMENT OF PUBLIC WORKS BUREAU OF ENGINEERING SERVICES		PEMBROKE STREET STA. 27-50 TO STA. 33-00 PLAN AND PROFILE		SHEET 4			
3 1/8/87 ADD GEO-TEX DRAFTED BY MDH		2 3/8/87 CHECKED BY MDH												DRAWN		SCALE		DAYBOOK NO. 010948		Contract # E85-29	
														CHECKED		DATE				Job No. - 845304	