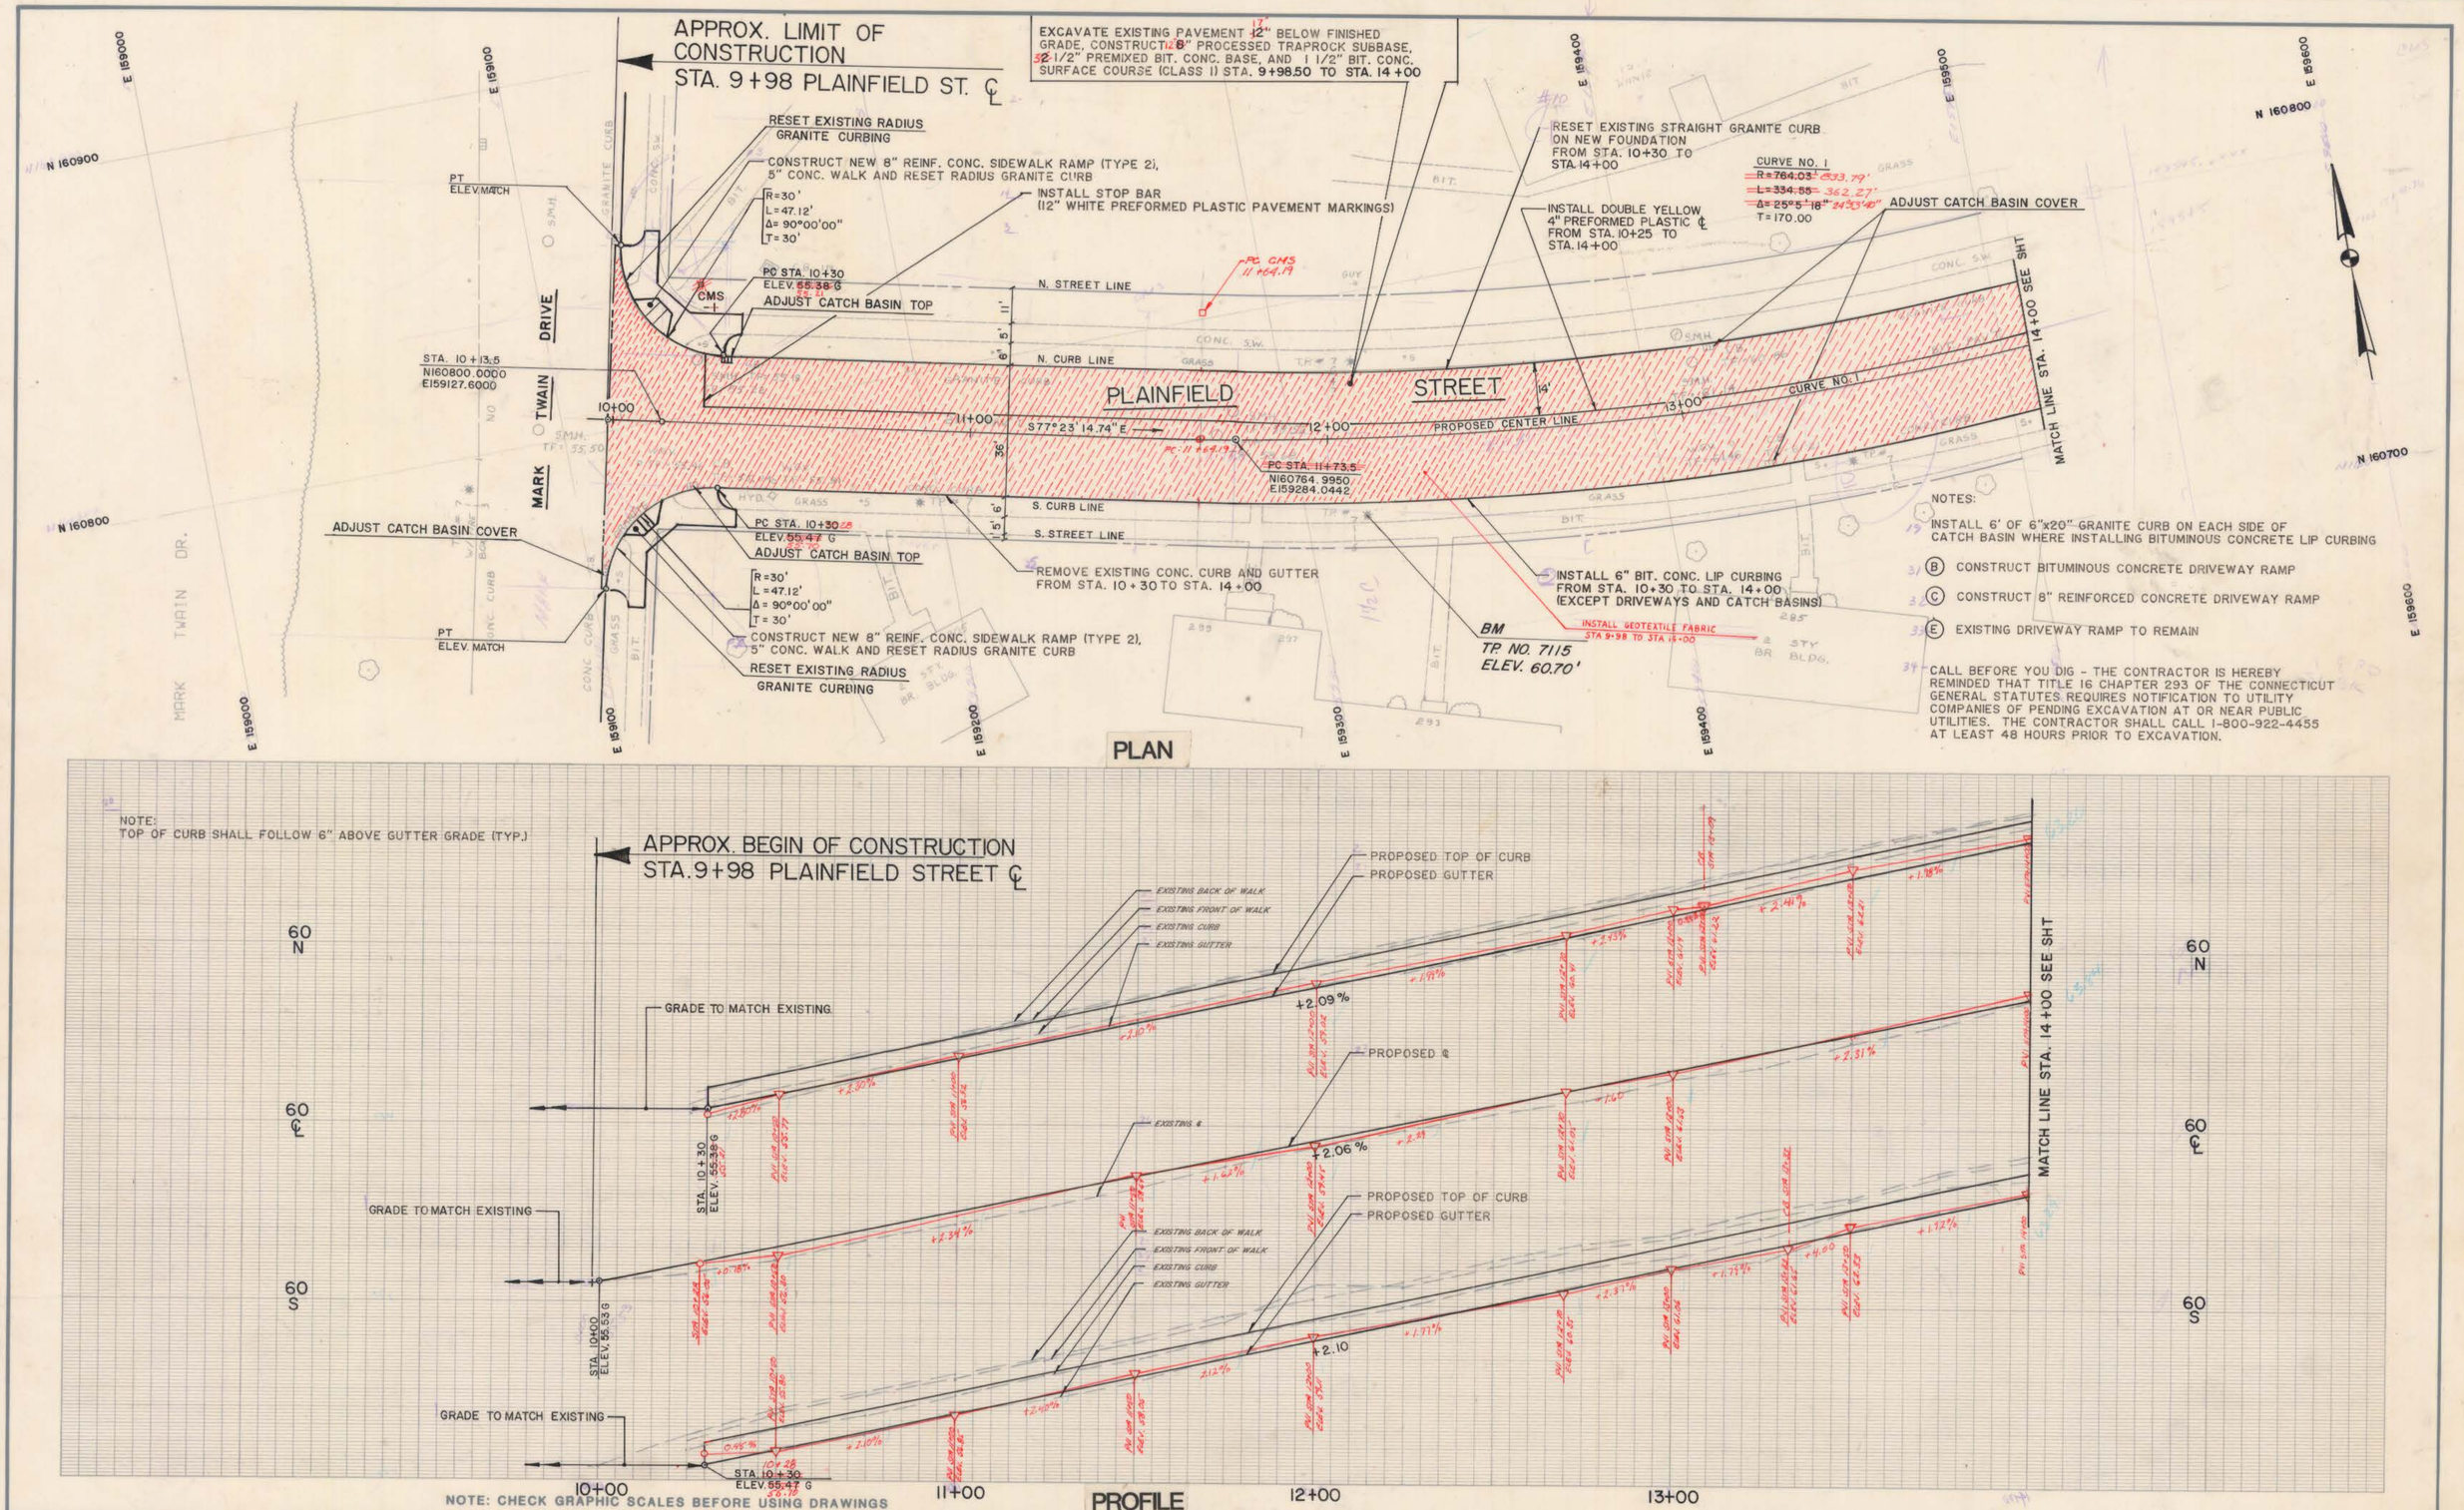

NOTE: CHECK GRAPHIC SCALES BEFORE USING DRAWINGS

NO.	DATE	DESCRIPTION
3	1/13/87	ADD GEO-TEX - AS BUILTED - DRAFTED BY: LG
2	JAN 87	CHECK LED BY MDH
1	JAN 87	AS-BUILT BY GAF

REVISIONS

SUPV. ARW
DESIGN MDH/AEC
DRAWN JR Moore
CHECKED JAC
DATE 6/17/85

GRAPHIC SCALES
HORIZ. 1"=20'
VERT. 1"=2'

ROADWAY RECONSTRUCTION
HARTFORD, CONNECTICUT

STATE OF CONNECTICUT ALAN E. WENGEL No. 10006 REGISTERED PROFESSIONAL ENGINEER

Hayden | Wegman
Consulting Engineers
WEST HARTFORD
NEW YORK • BOSTON • BUFFALO
ATLANTA • MEMPHIS

CITY OF HARTFORD, CONNECTICUT
DEPARTMENT OF PUBLIC WORKS
BUREAU OF ENGINEERING SERVICES

DRAWN
CHECKED
SCALE
DAYBOOK NO. 010948
DATE

PLAINFIELD STREET
STA. 9+98 TO STA. 14+00
PLAN AND PROFILE
Contract E85-29
Job No.- 845304
SHEET 1 OF 4

575/1 J