


34 CALL BEFORE YOU DIG - THE CONTRACTOR IS HEREBY REMINDED THAT TITLE 16 CHAPTER 293 OF THE CONNECTICUT GENERAL STATUTES REQUIRES NOTIFICATION TO UTILITY COMPANIES OF PENDING EXCAVATION AT OR NEAR PUBLIC UTILITIES. THE CONTRACTOR SHALL CALL 1-800-922-4455 AT LEAST 48 HOURS PRIOR TO EXCAVATION.


NOTES:

- 31 INSTALL 6" OF 6"x20" GRANITE CURB ON EACH SIDE OF
- 32 CATCH BASIN WHERE INSTALLING BITUMINOUS CONCRETE LIP CURBING
- (B) CONSTRUCT BITUMINOUS CONCRETE DRIVEWAY RAMP
- (C) CONSTRUCT 8" REINFORCED CONCRETE DRIVEWAY RAMP
- (E) EXISTING DRIVEWAY RAMP TO REMAIN

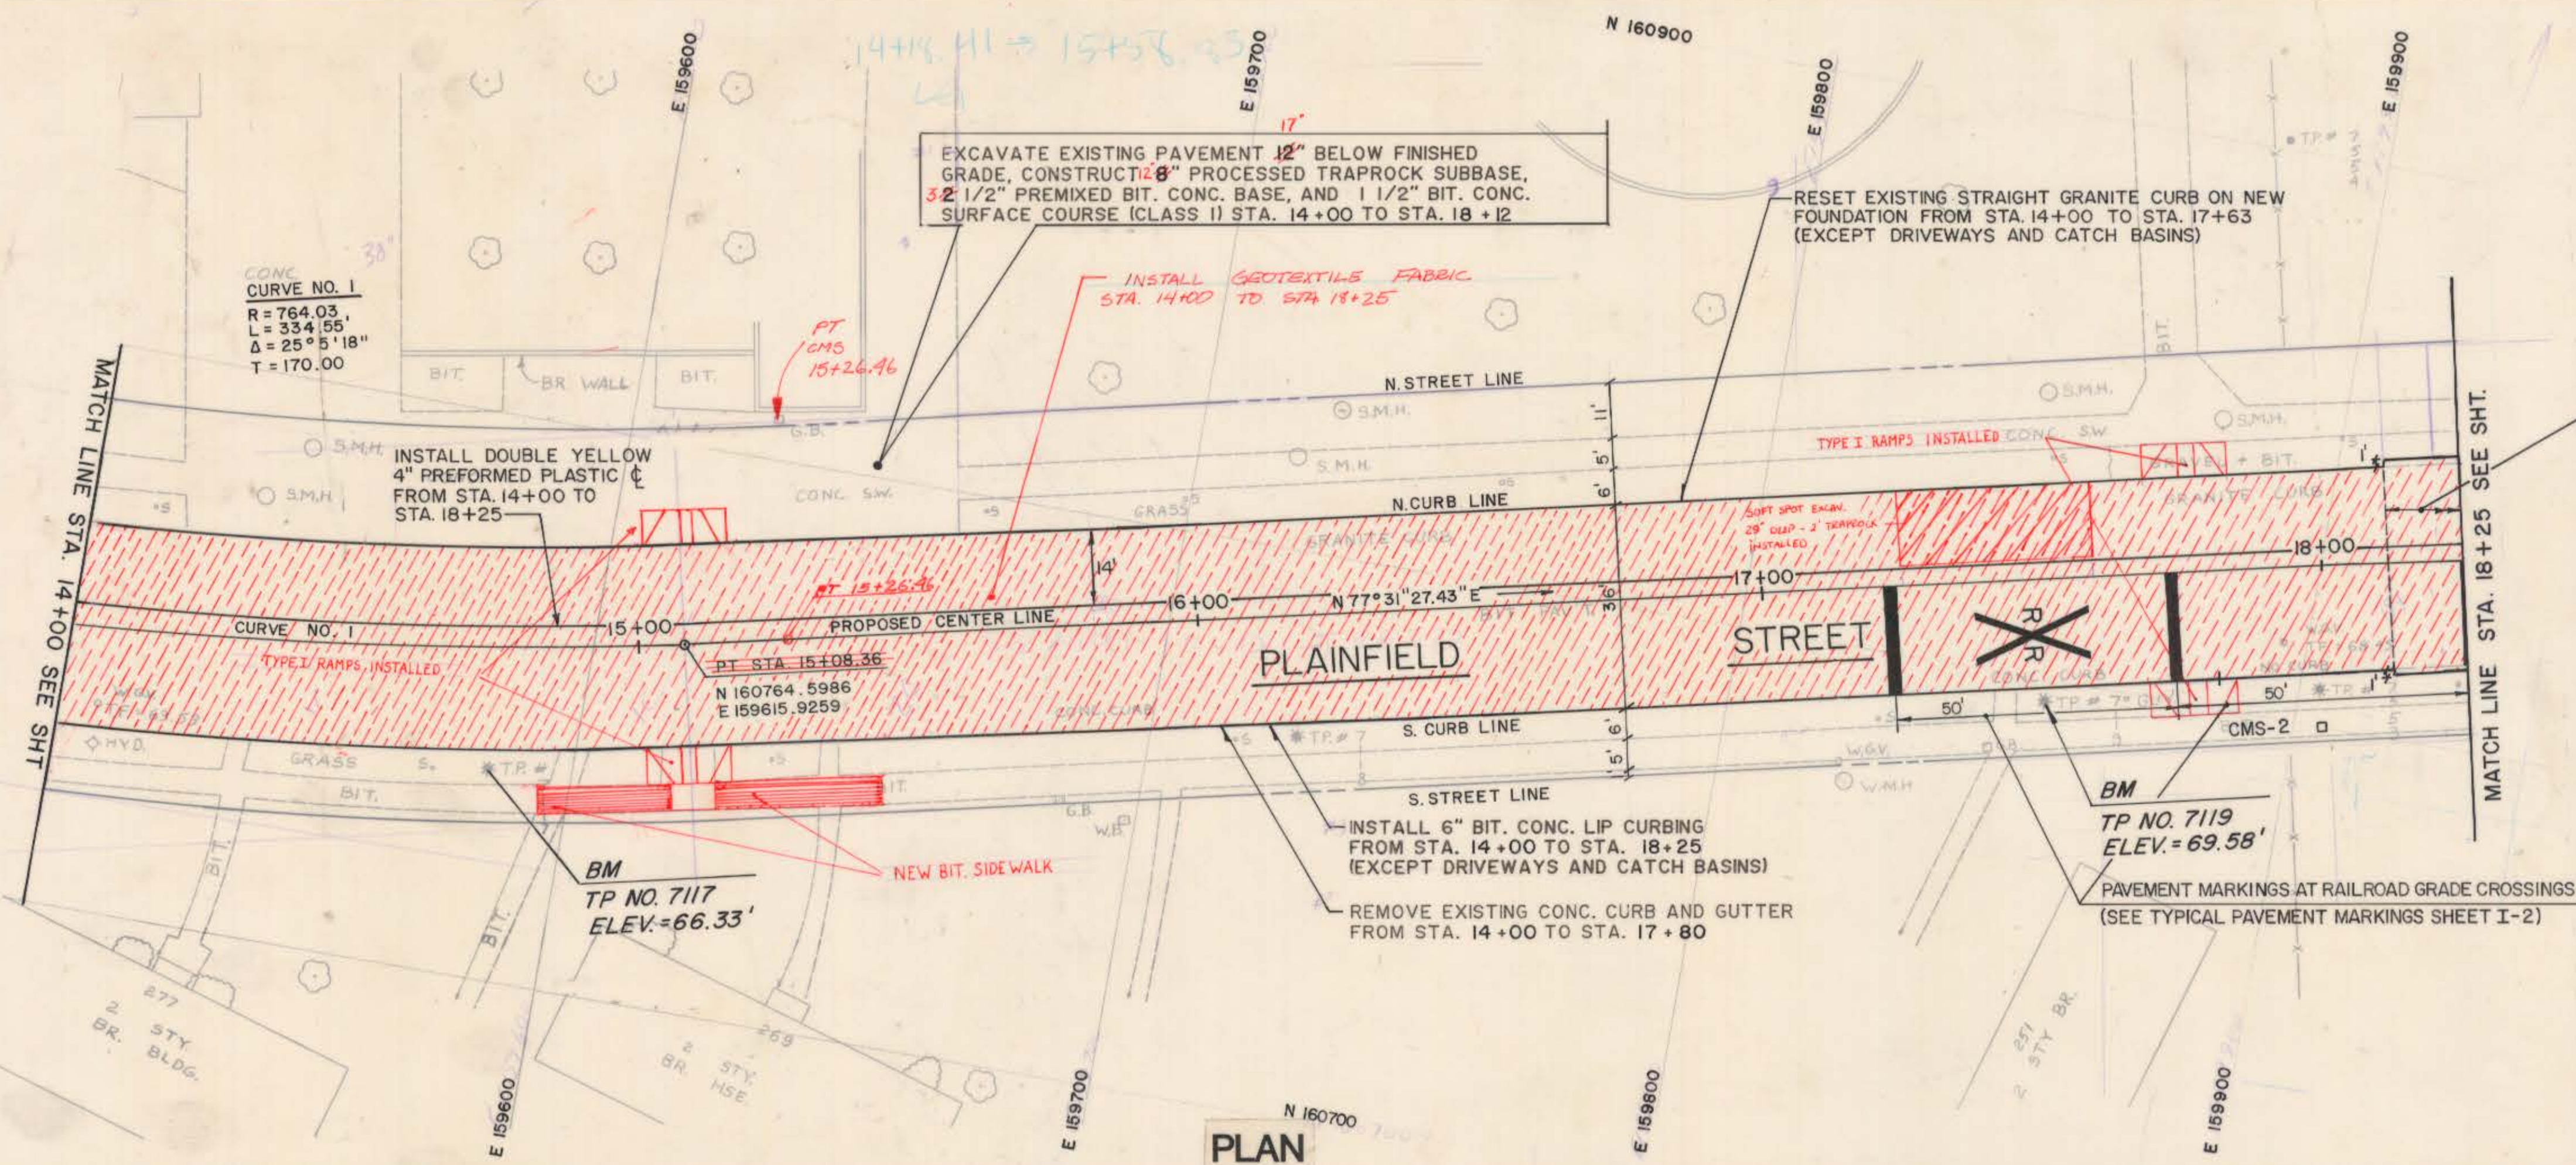

ROAD RECONSTRUCTION AT RAILROAD CROSSING
INSTALL RAILROAD GRADE CROSSING TRACK RAIL GUARDS, EXCAVATE EXISTING PAVEMENT 17" BELOW FINISHED GRADE, CONSTRUCT 12" OF PROCESSED TRAPROCK SUBBASE, 3 1/2" PREMIXED BIT. CONC. BASE, AND 1 1/2" BIT. CONC. SURFACE COURSE (CLASS 1) STA. 18+12 TO STA. 18+77 SEE TYPICAL DETAILS SHEET I-1A

PLAN

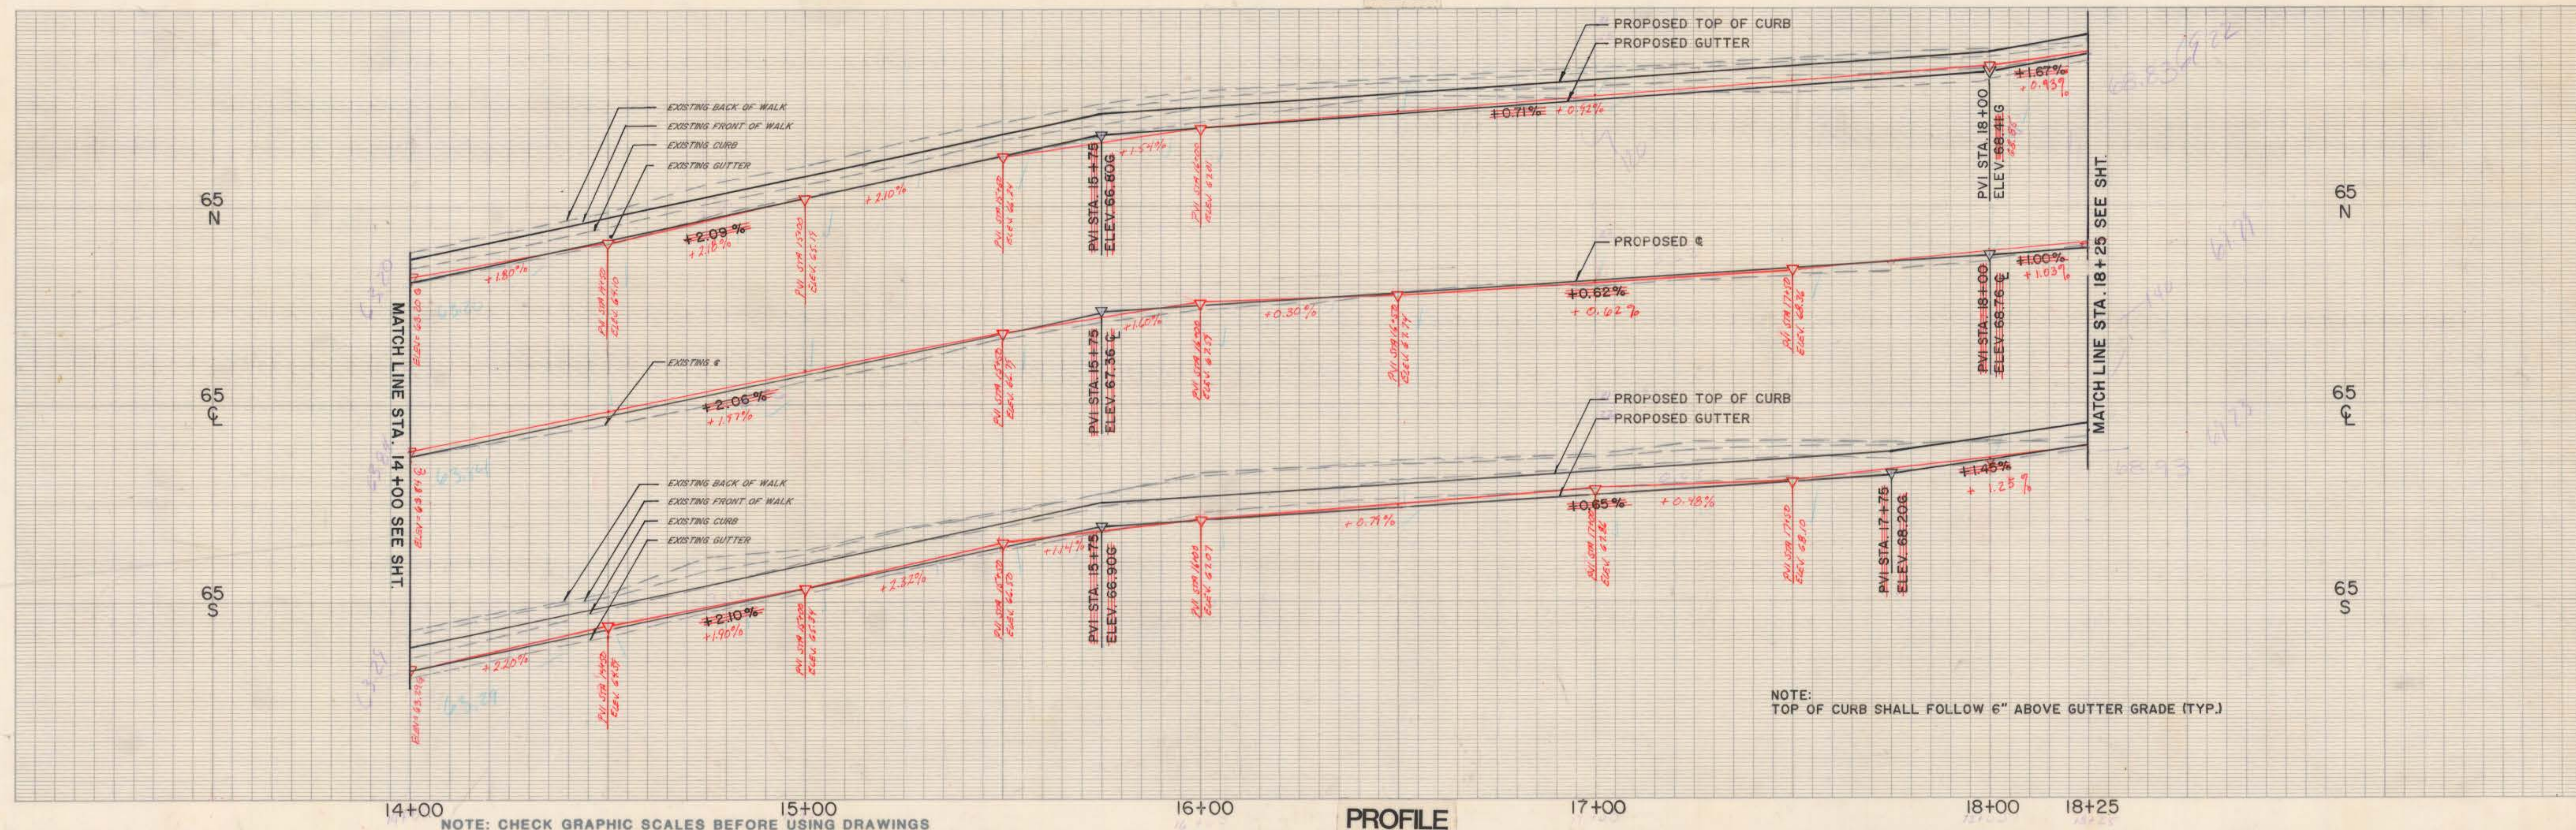

PROFILE

--	--	