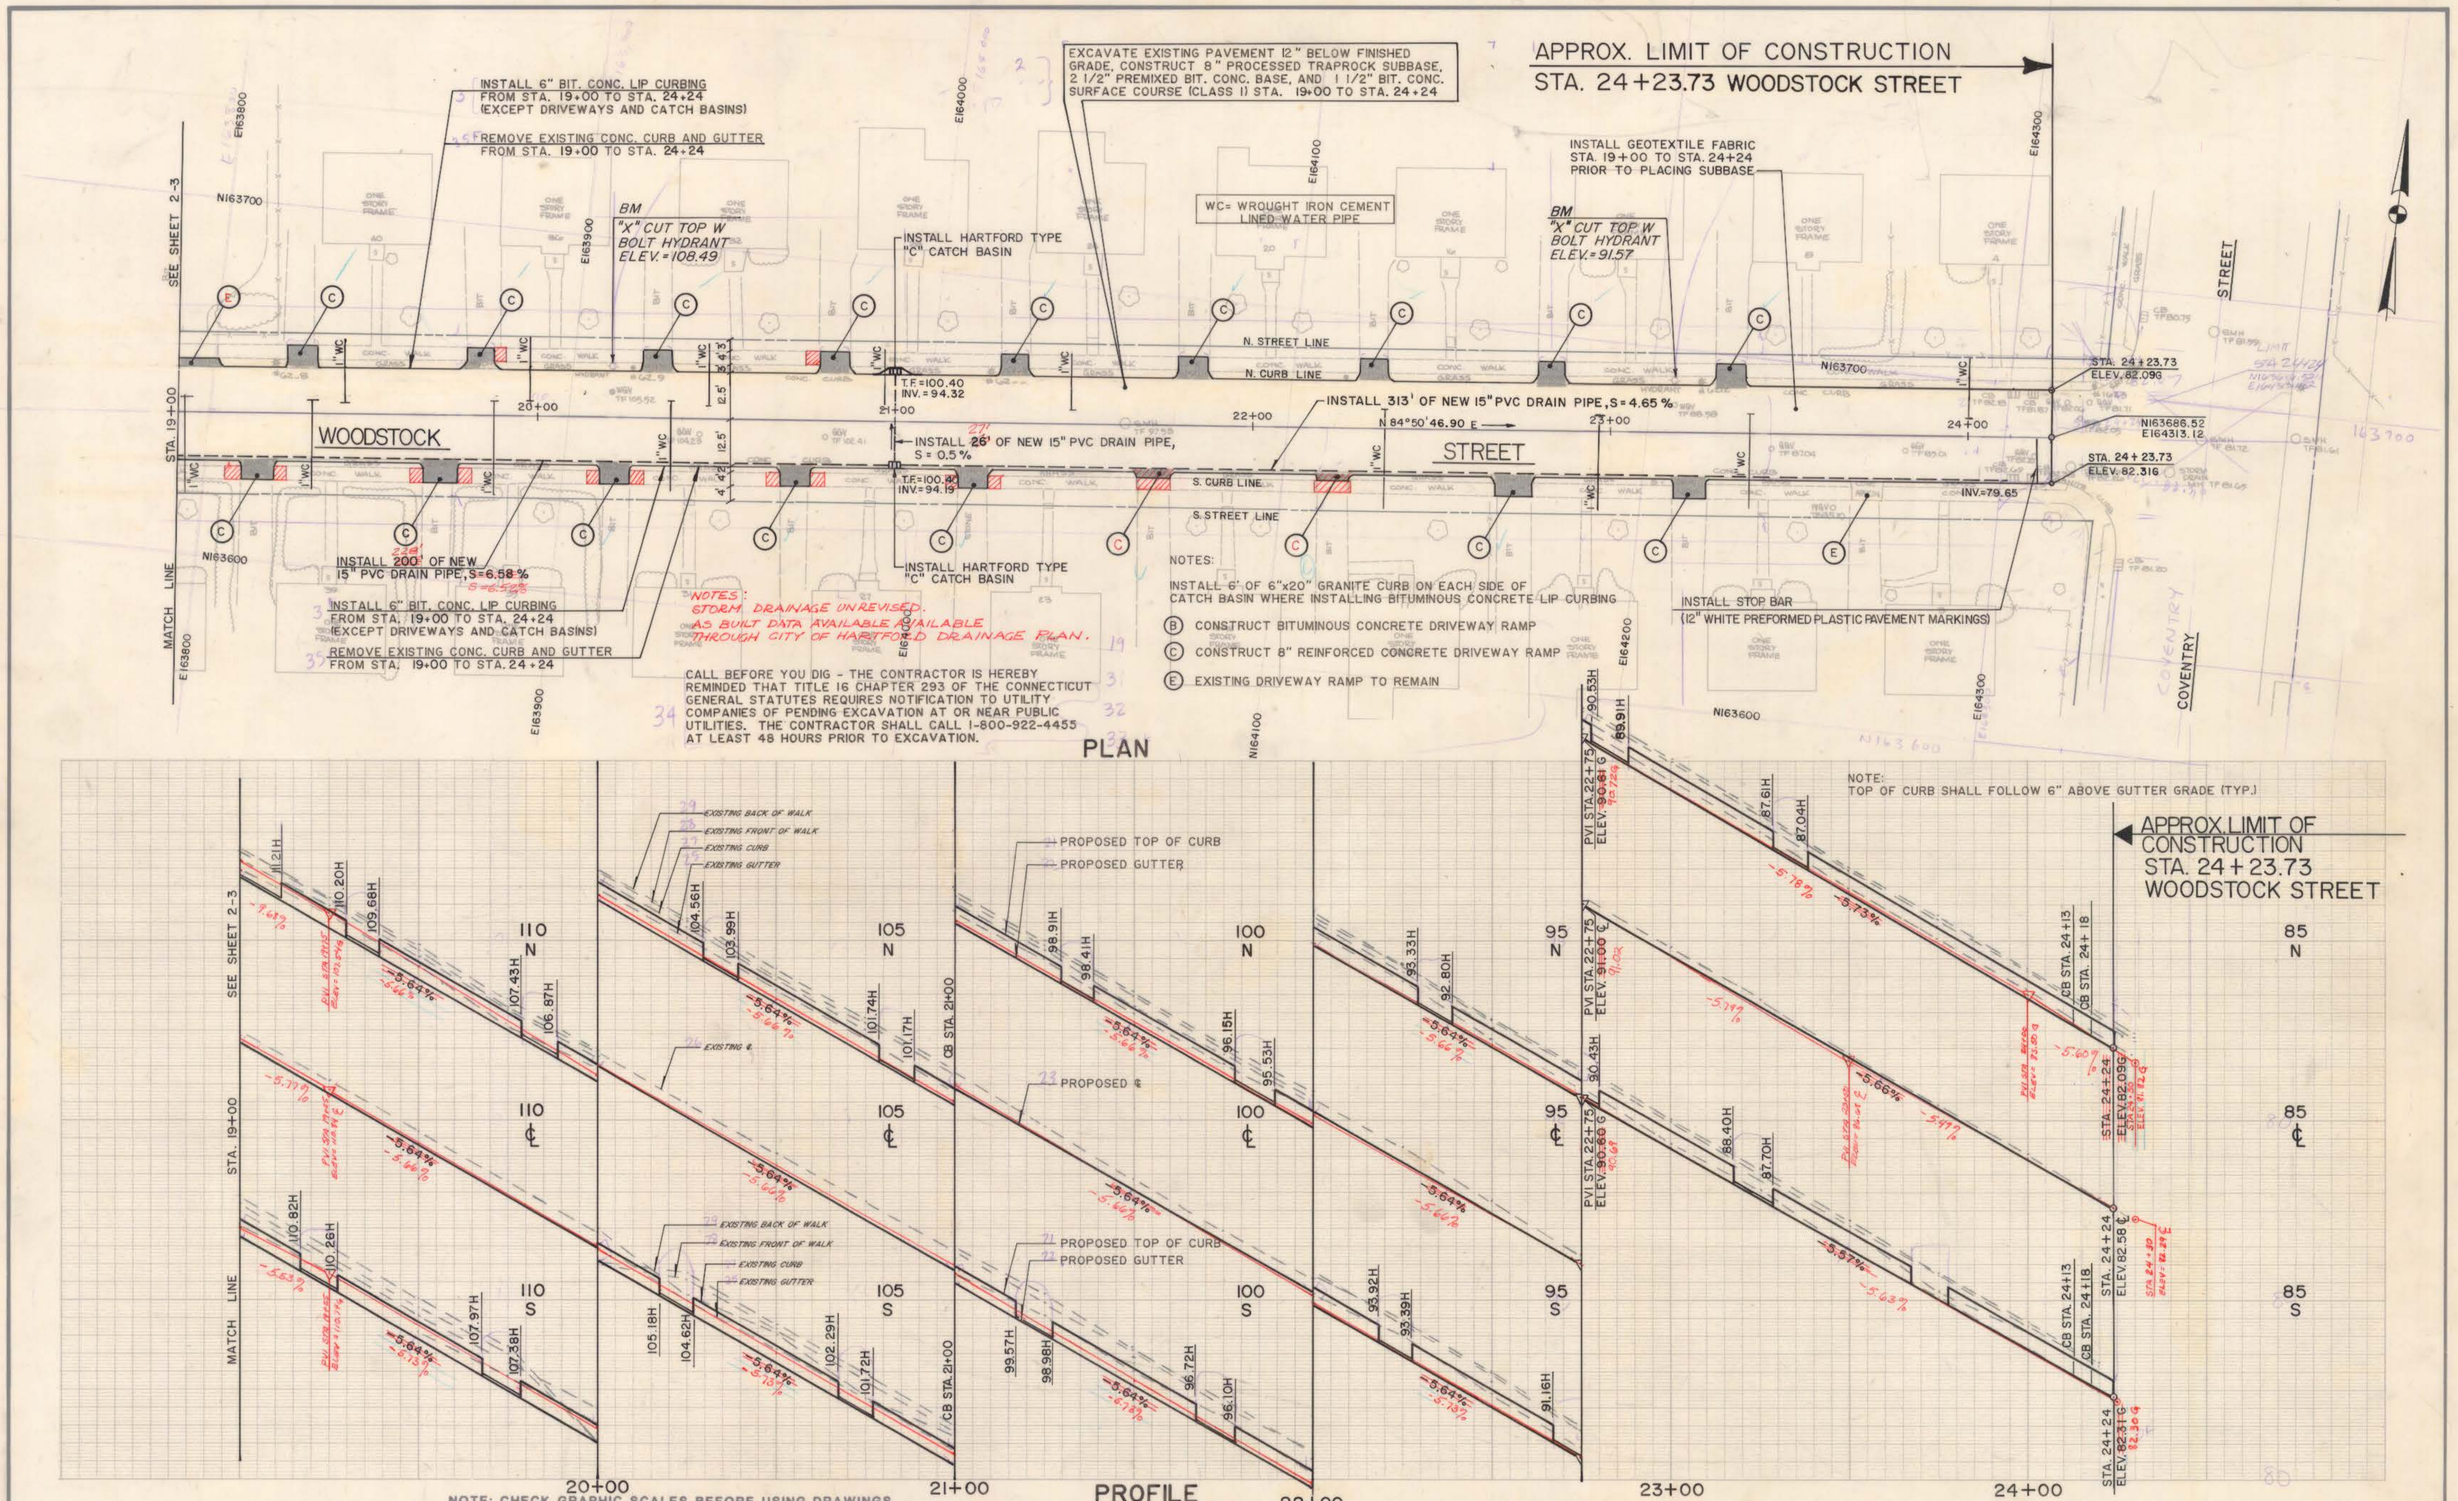

NO.	DATE	DESCRIPTION
4	1/26/87	ADD NOTE - AS BUILT - DRAFTED BY MDH
3	JAN 87	CHECKED BY MDH
2	DEC 86	AS BUILT BY MDH
1	9-6-85	ENGINEERING DATA CHANGE

REVISIONS

SUPV. ARW
DESIGN AC / DH
DRAWN EPF
CHECKED JAC
DATE 6-25-85

GRAPHIC SCALES
HORIZ. 1" = 20'
VERT. 1" = 2'

ROADWAY RECONSTRUCTION
HARTFORD, CONNECTICUT

STATE OF CONNECTICUT ALAN R. WEGMAN NO. 10606 REGISTERED PROFESSIONAL ENGINEER

Hayden | Wegman
Consulting Engineers
WEST HARTFORD
NEW YORK • BOSTON • BUFFALO
ATLANTA • MEMPHIS

CITY OF HARTFORD, CONNECTICUT
DEPARTMENT OF PUBLIC WORKS
BUREAU OF ENGINEERING SERVICES

DRAWN
CHECKED
SCALE
DAYBOOK NO. 010956
DATE

WOODSTOCK STREET
STA. 19+00 TO STA. 24+24

PLAN AND PROFILE

Contract #E85-34
Job No.- 845304

SHEET 3 OF 3

575/2A