


2/2

2/2

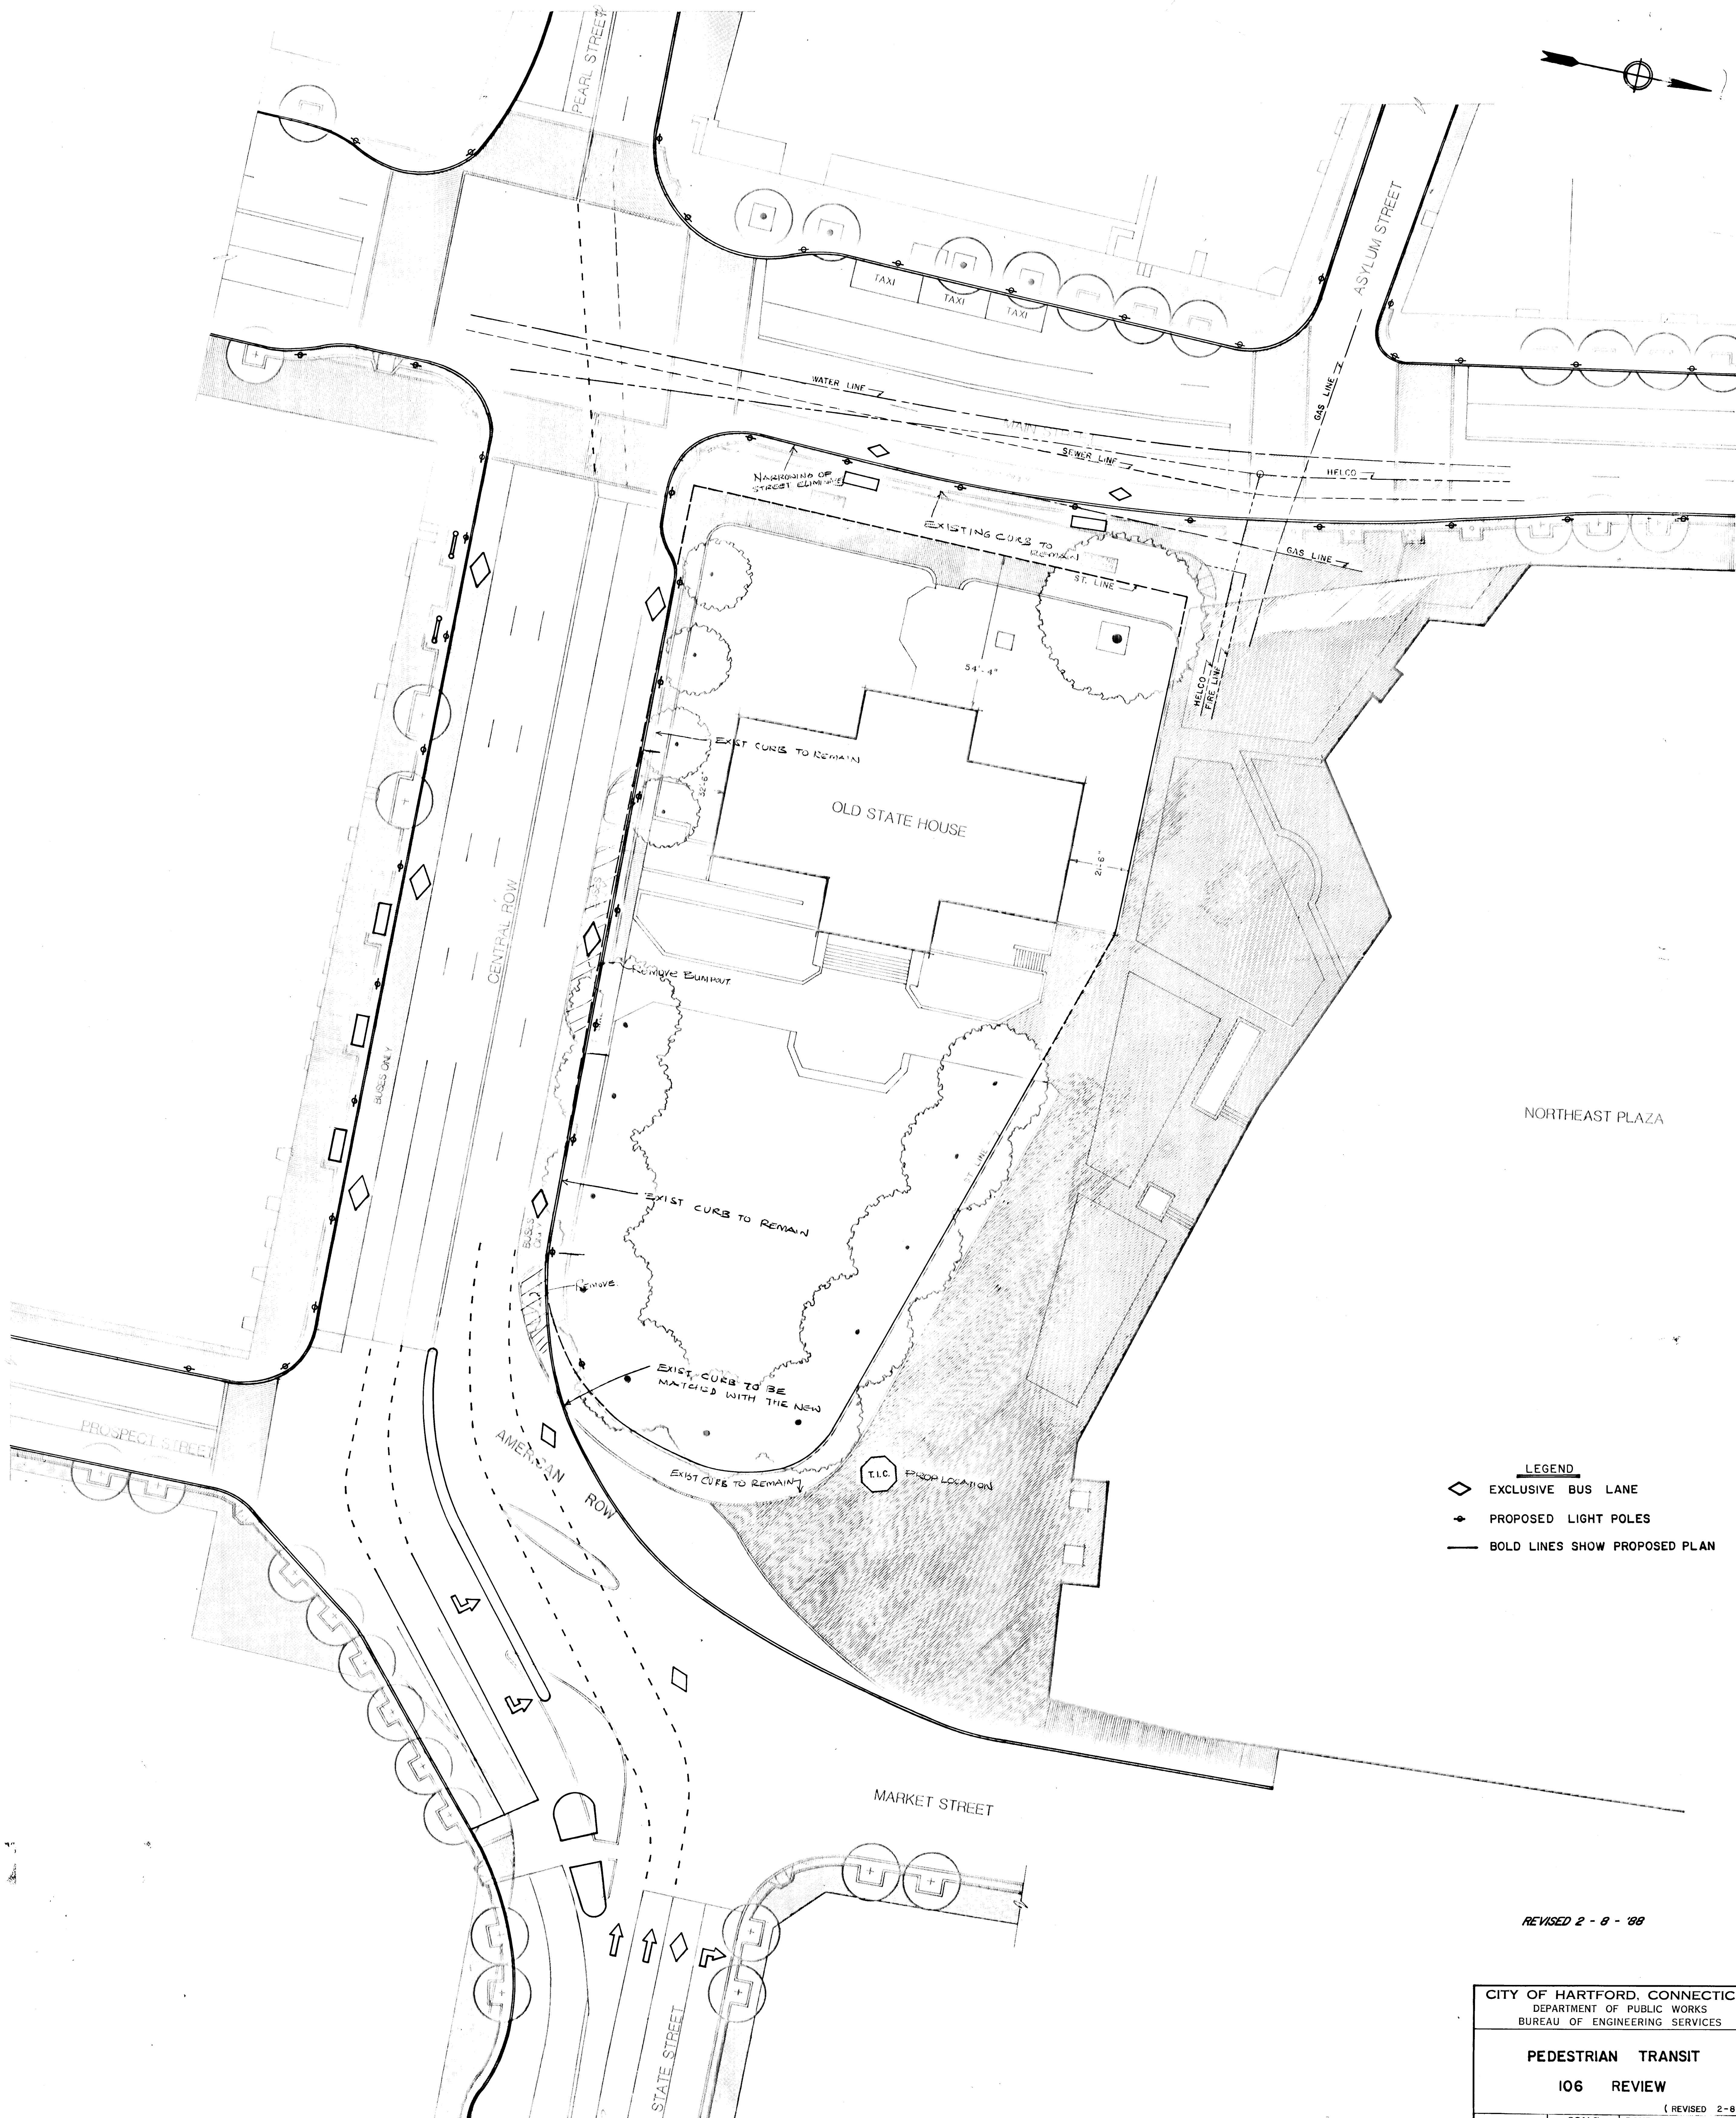

REVISED 2 - 8 - '88

CITY OF HARTFORD, CONNECTICUT DEPARTMENT OF PUBLIC WORKS BUREAU OF ENGINEERING SERVICES			
PEDESTRIAN TRANSIT			
106 REVIEW			
(REVISED 2-8-88)			
DRAWN	SCALE	DAYBOOK NO.	
CHECKED	HOR. 1" = 20'	DATE APRIL 7, 1987	

2/2

2/2