
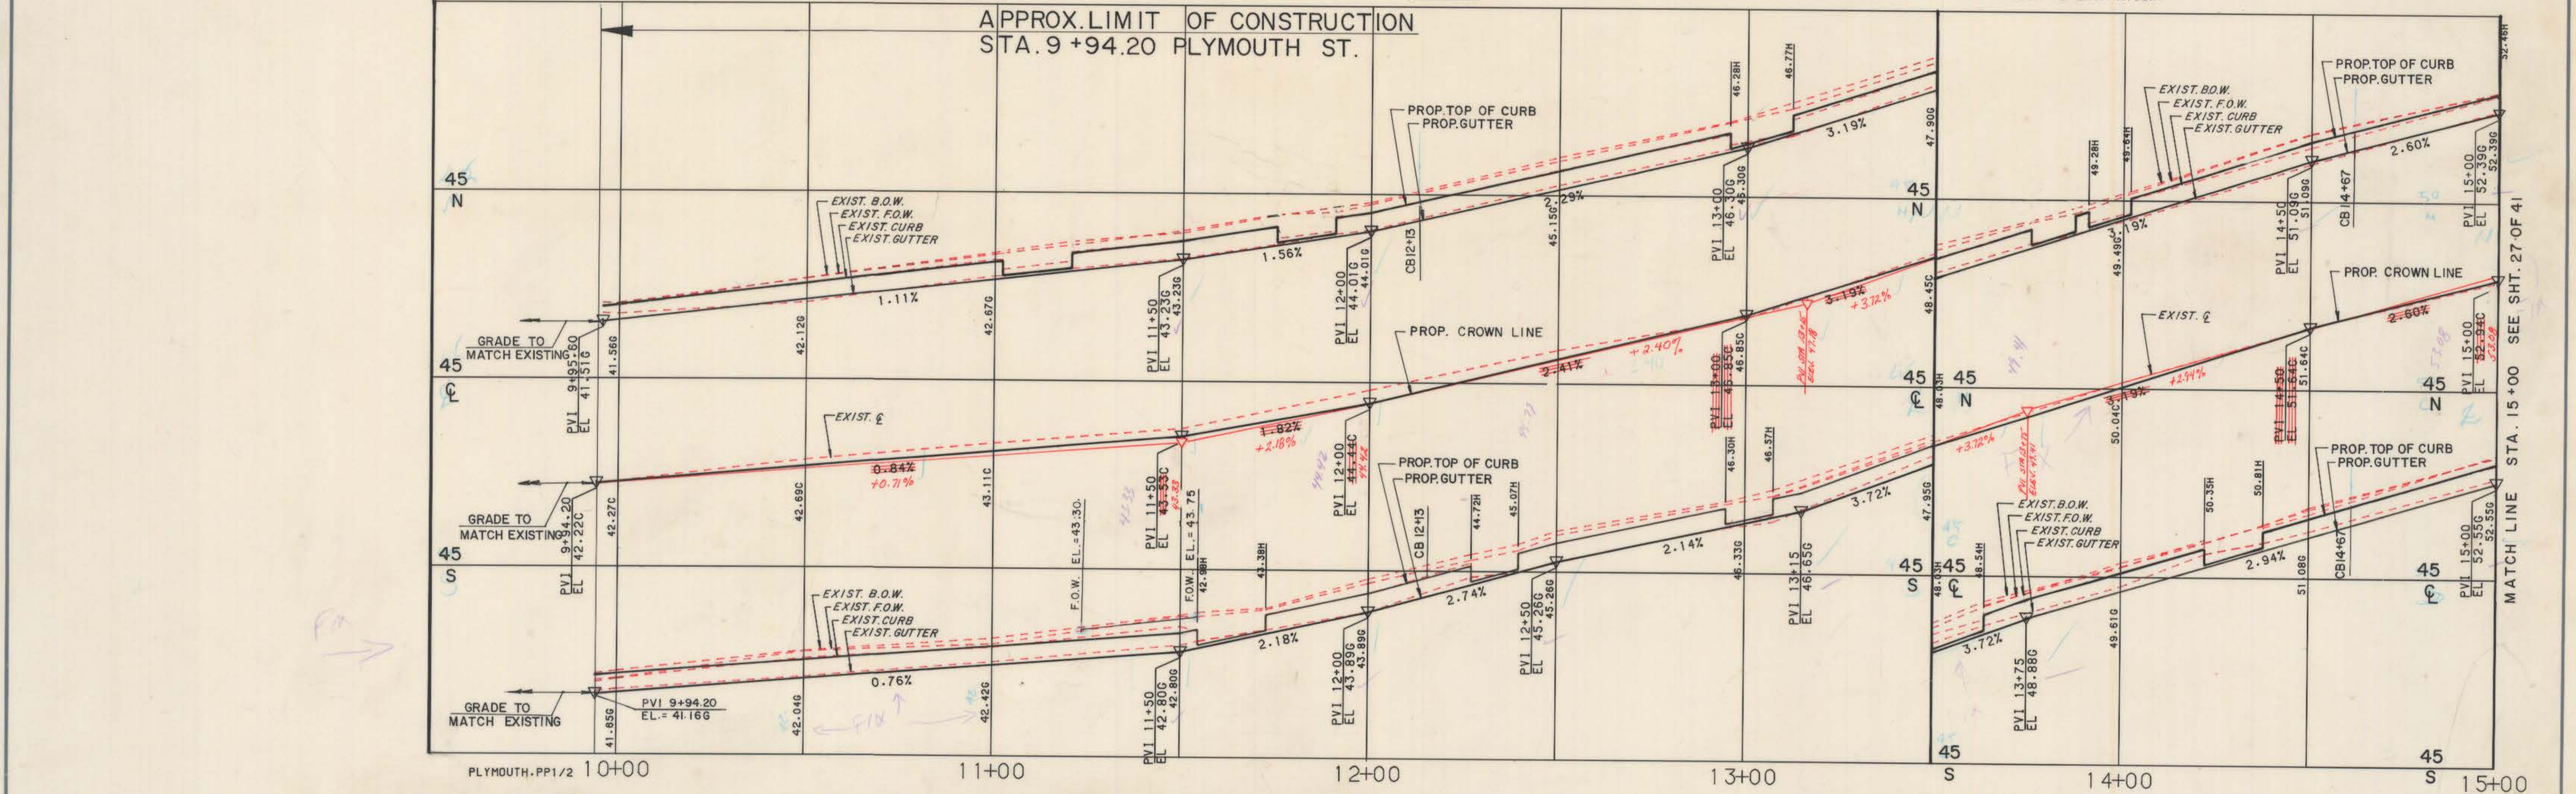


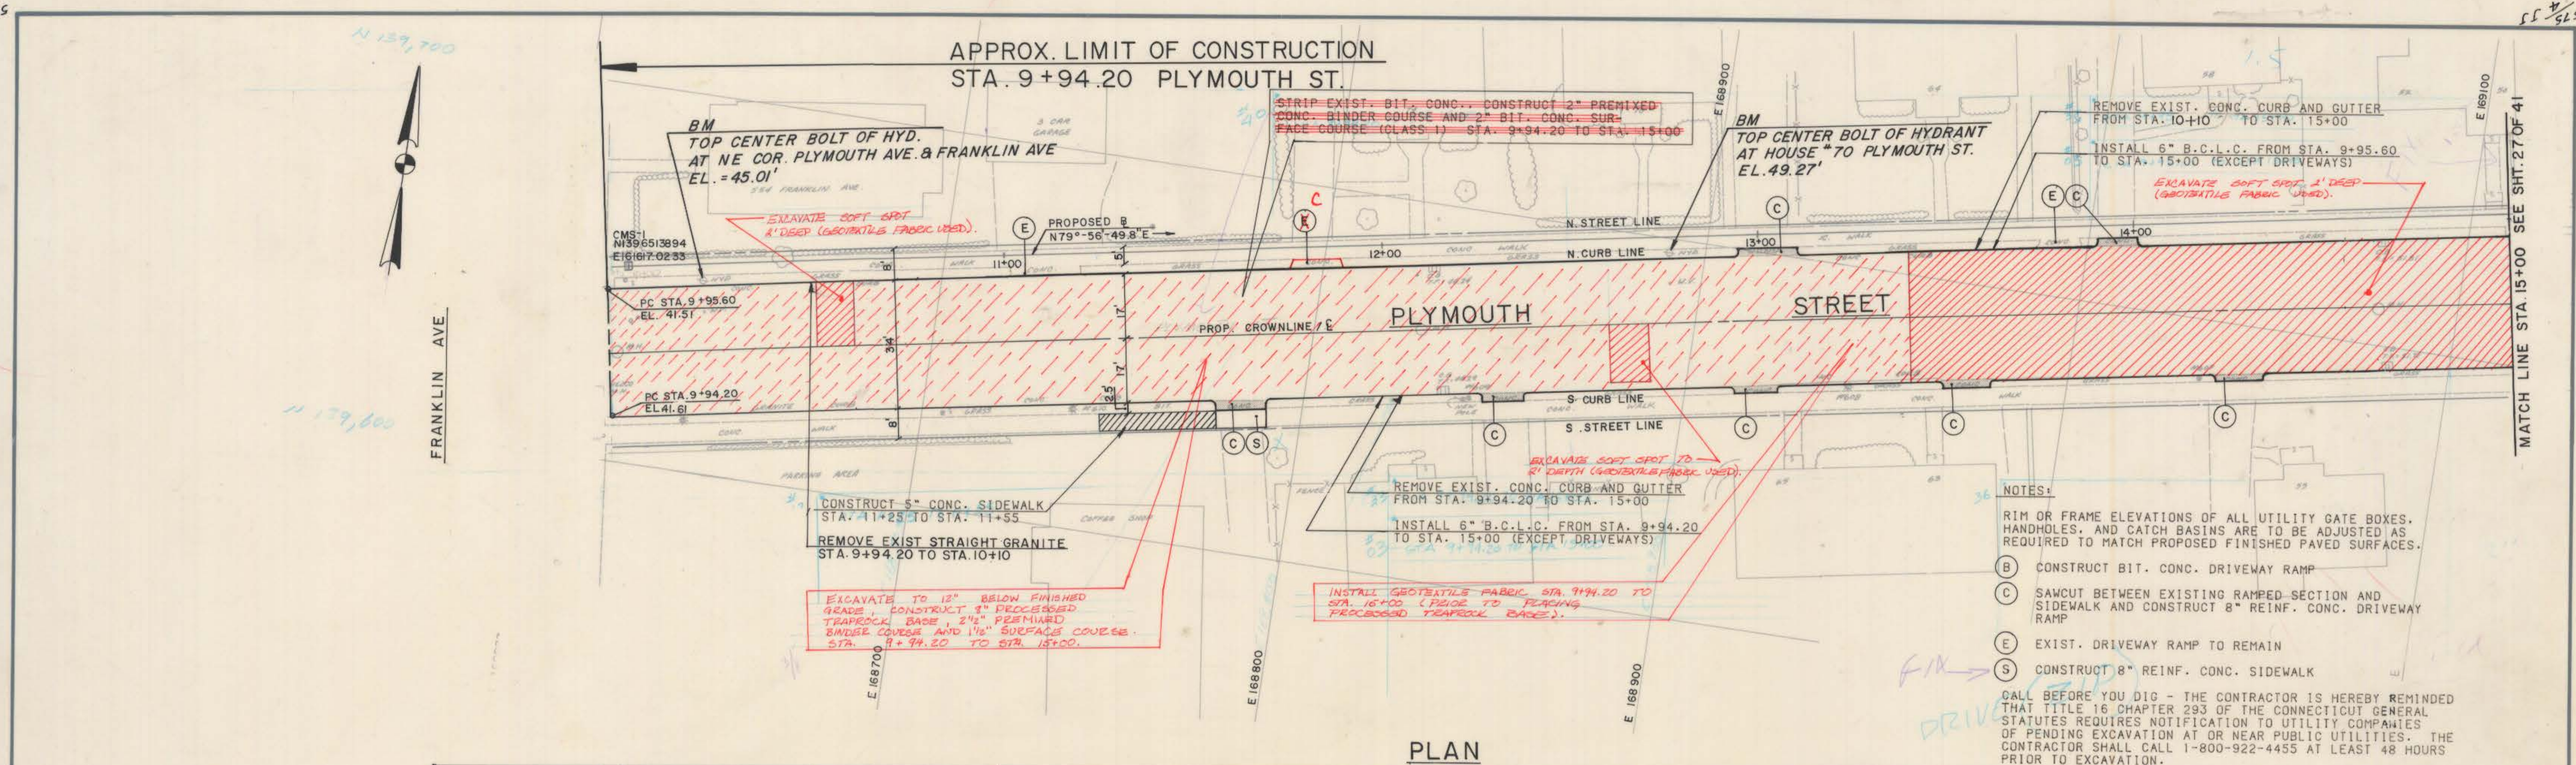

|     |          |             |
|-----|----------|-------------|
| NO. | DATE     | DESCRIPTION |
| 1   | 02/11/86 | REVISIONS   |

|         |          |
|---------|----------|
| SUPV.   | JAC      |
| DESIGN  | MDH/AEC  |
| DRAWN   | MJN      |
| CHECKED | AEC      |
| DATE    | 02/11/86 |

|                |
|----------------|
| GRAPHIC SCALES |
| HORIZ. 1"=20'  |
| VERT. 1"=2'    |

|                                                 |
|-------------------------------------------------|
| ROADWAY RECONSTRUCTION<br>HARTFORD, CONNECTICUT |
|-------------------------------------------------|



|                                                                   |
|-------------------------------------------------------------------|
| Hayden   Wegman<br>Consulting Engineers                           |
| WEST HARTFORD<br>NEW YORK • BOSTON • BUFFALO<br>ATLANTA • MEMPHIS |

|                                                                                               |
|-----------------------------------------------------------------------------------------------|
| CITY OF HARTFORD, CONNECTICUT<br>DEPARTMENT OF PUBLIC WORKS<br>BUREAU OF ENGINEERING SERVICES |
| DAYBOOK NO. 011005<br>DATE                                                                    |

|                                                     |
|-----------------------------------------------------|
| PLYMOUTH STREET<br>STA. 9+94.20 TO 15+00            |
| PLAN AND PROFILE                                    |
| SHEET 26<br>Contract No. E86-2 Job No. 852534 OF 41 |