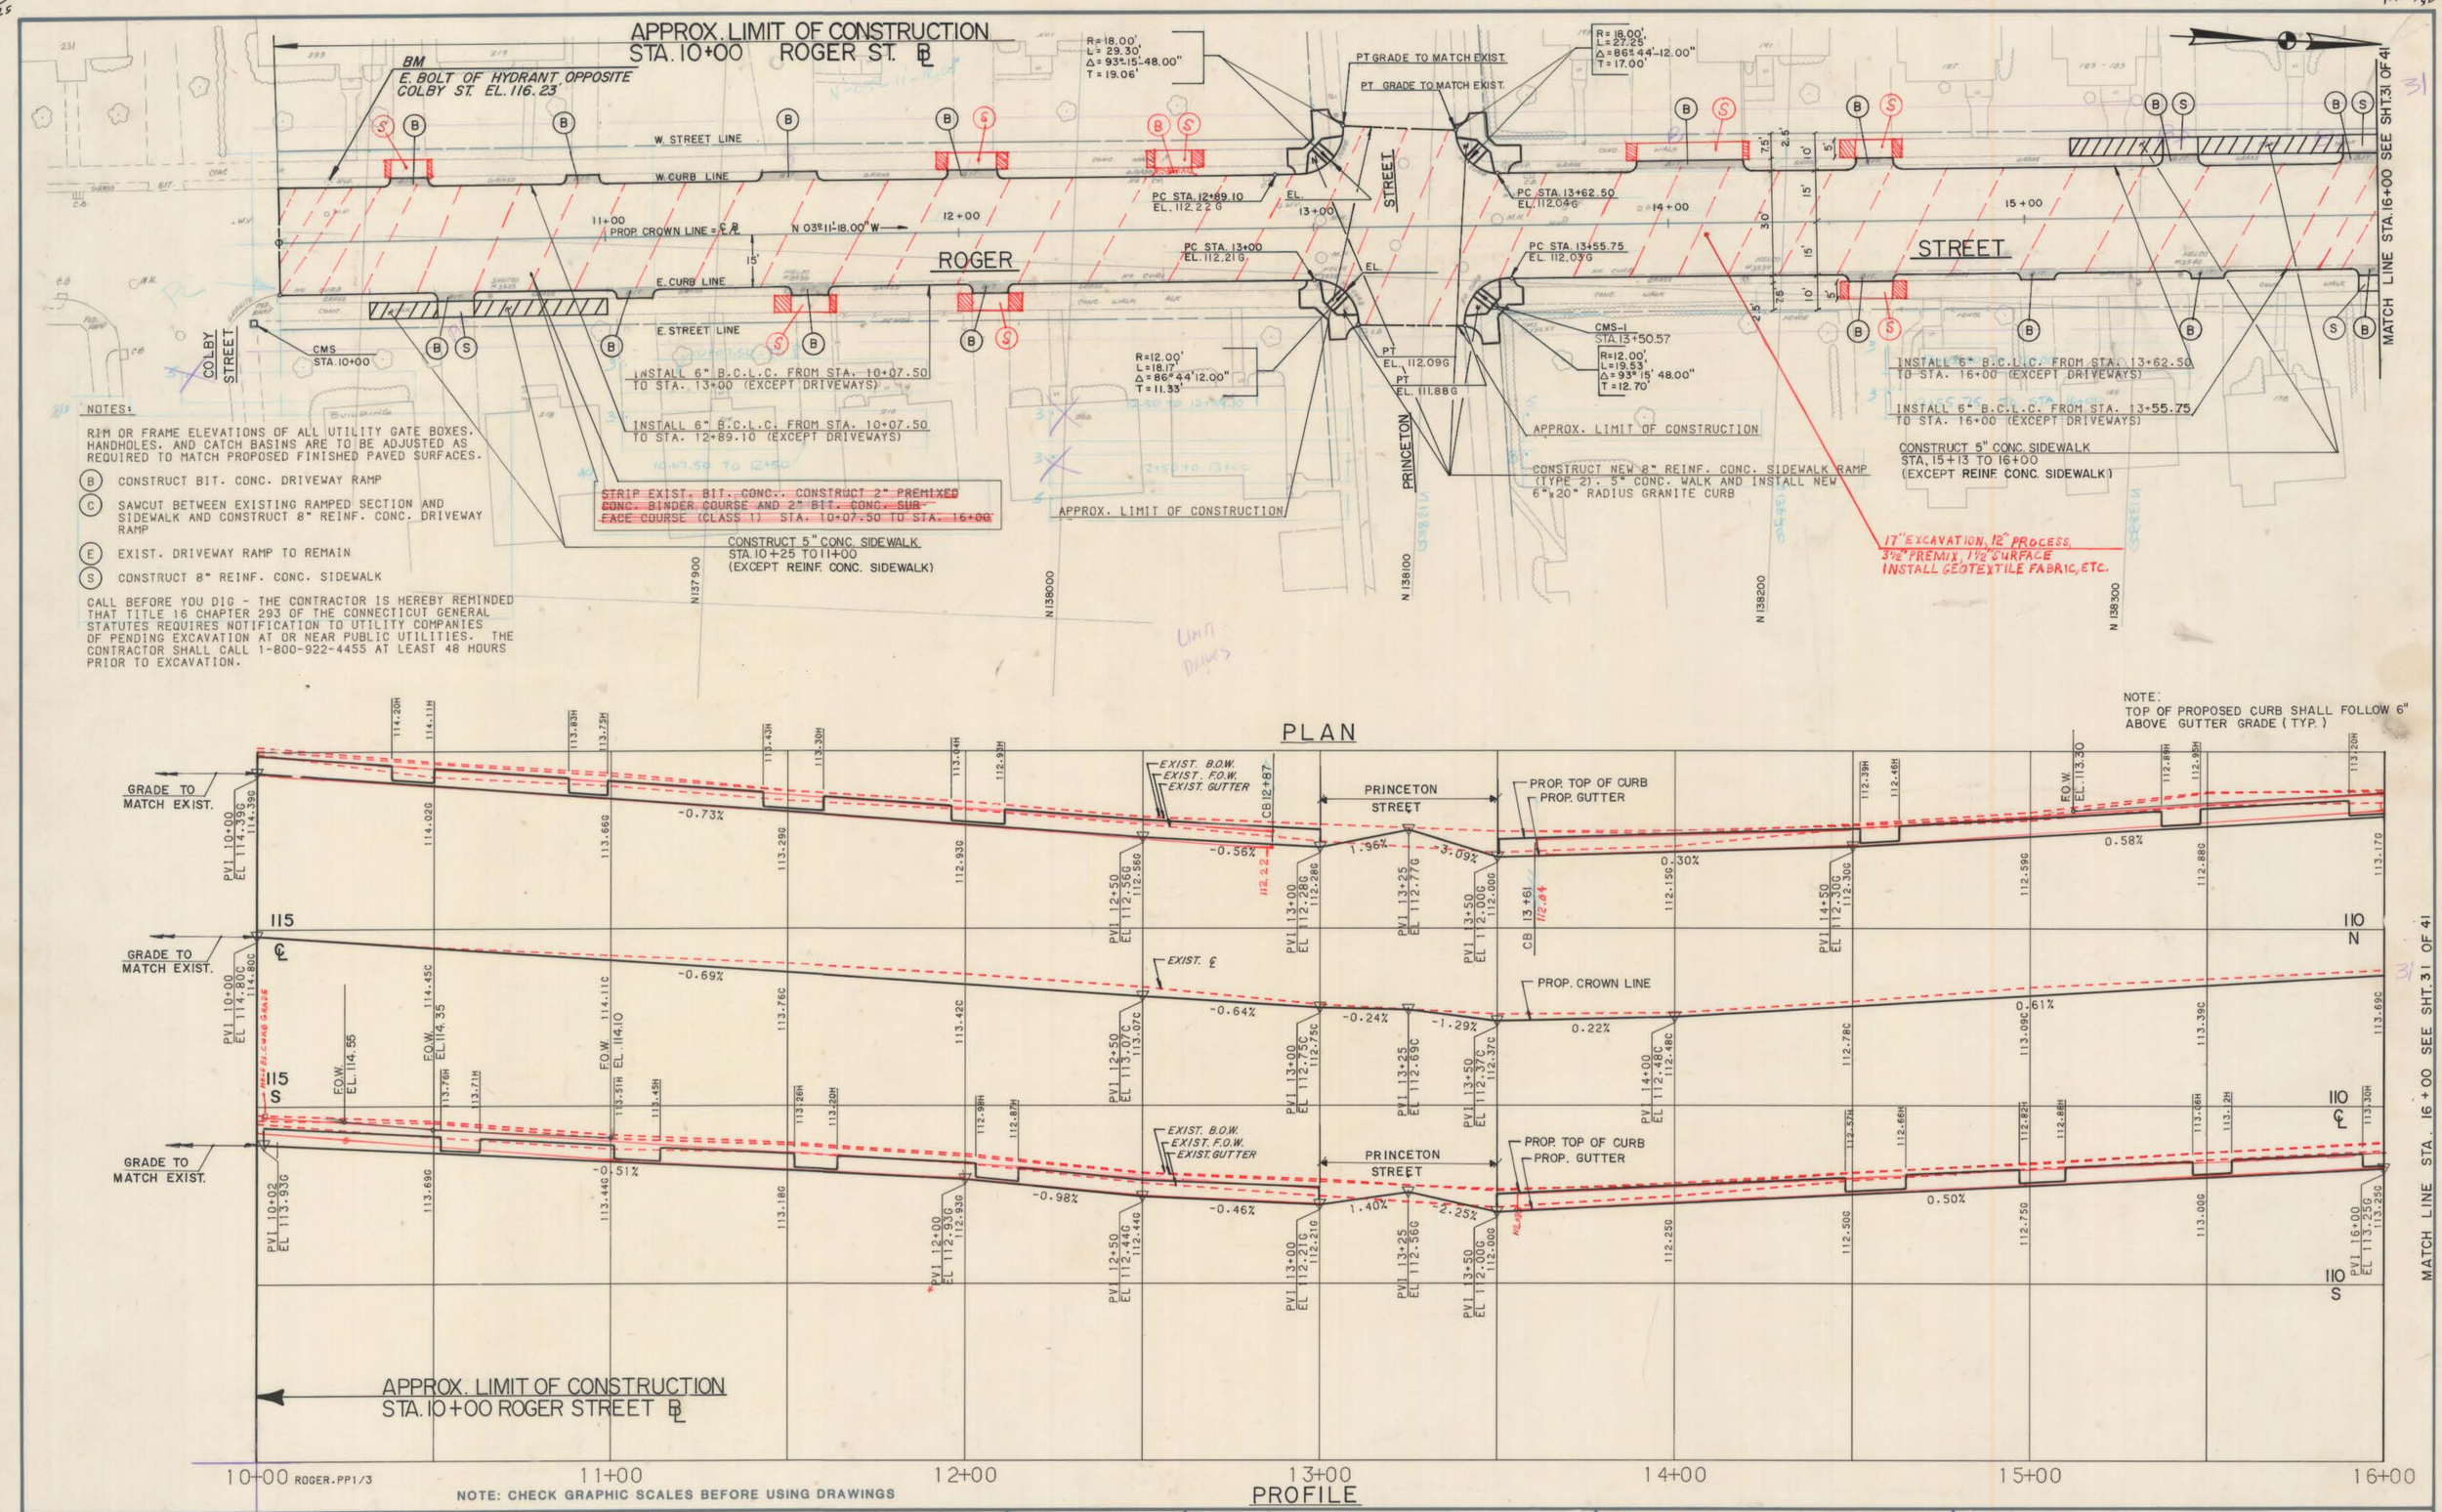

NO.	DATE	DESCRIPTION

REVISIONS

SUPV. JAC
DESIGN MDH/AEC
DRAWN N.D. FORTIN
CHECKED AEC
DATE 02·14·86

GRAPHIC SCALES
HORIZ. 1" = 20'
VERT. 1" = 2'

ROADWAY RECONSTRUCTION
HARTFORD, CONNECTICUT

STATE OF CONNECTICUT ALAN B. WEGMAN No. 10606 REGISTERED PROFESSIONAL ENGINEER

Hayden | Wegman
Consulting Engineers
WEST HARTFORD
NEW YORK • BOSTON • BUFFALO
ATLANTA • MEMPHIS

CITY OF HARTFORD, CONNECTICUT
DEPARTMENT OF PUBLIC WORKS
BUREAU OF ENGINEERING SERVICES

DAYBOOK NO. 011005
DATE

ROGER STREET
STA. 10+00 TO STA. 16+00

PLAN AND PROFILE
Contract No. E-86-2 Job No.- 852534

SHEET 30 OF 41