



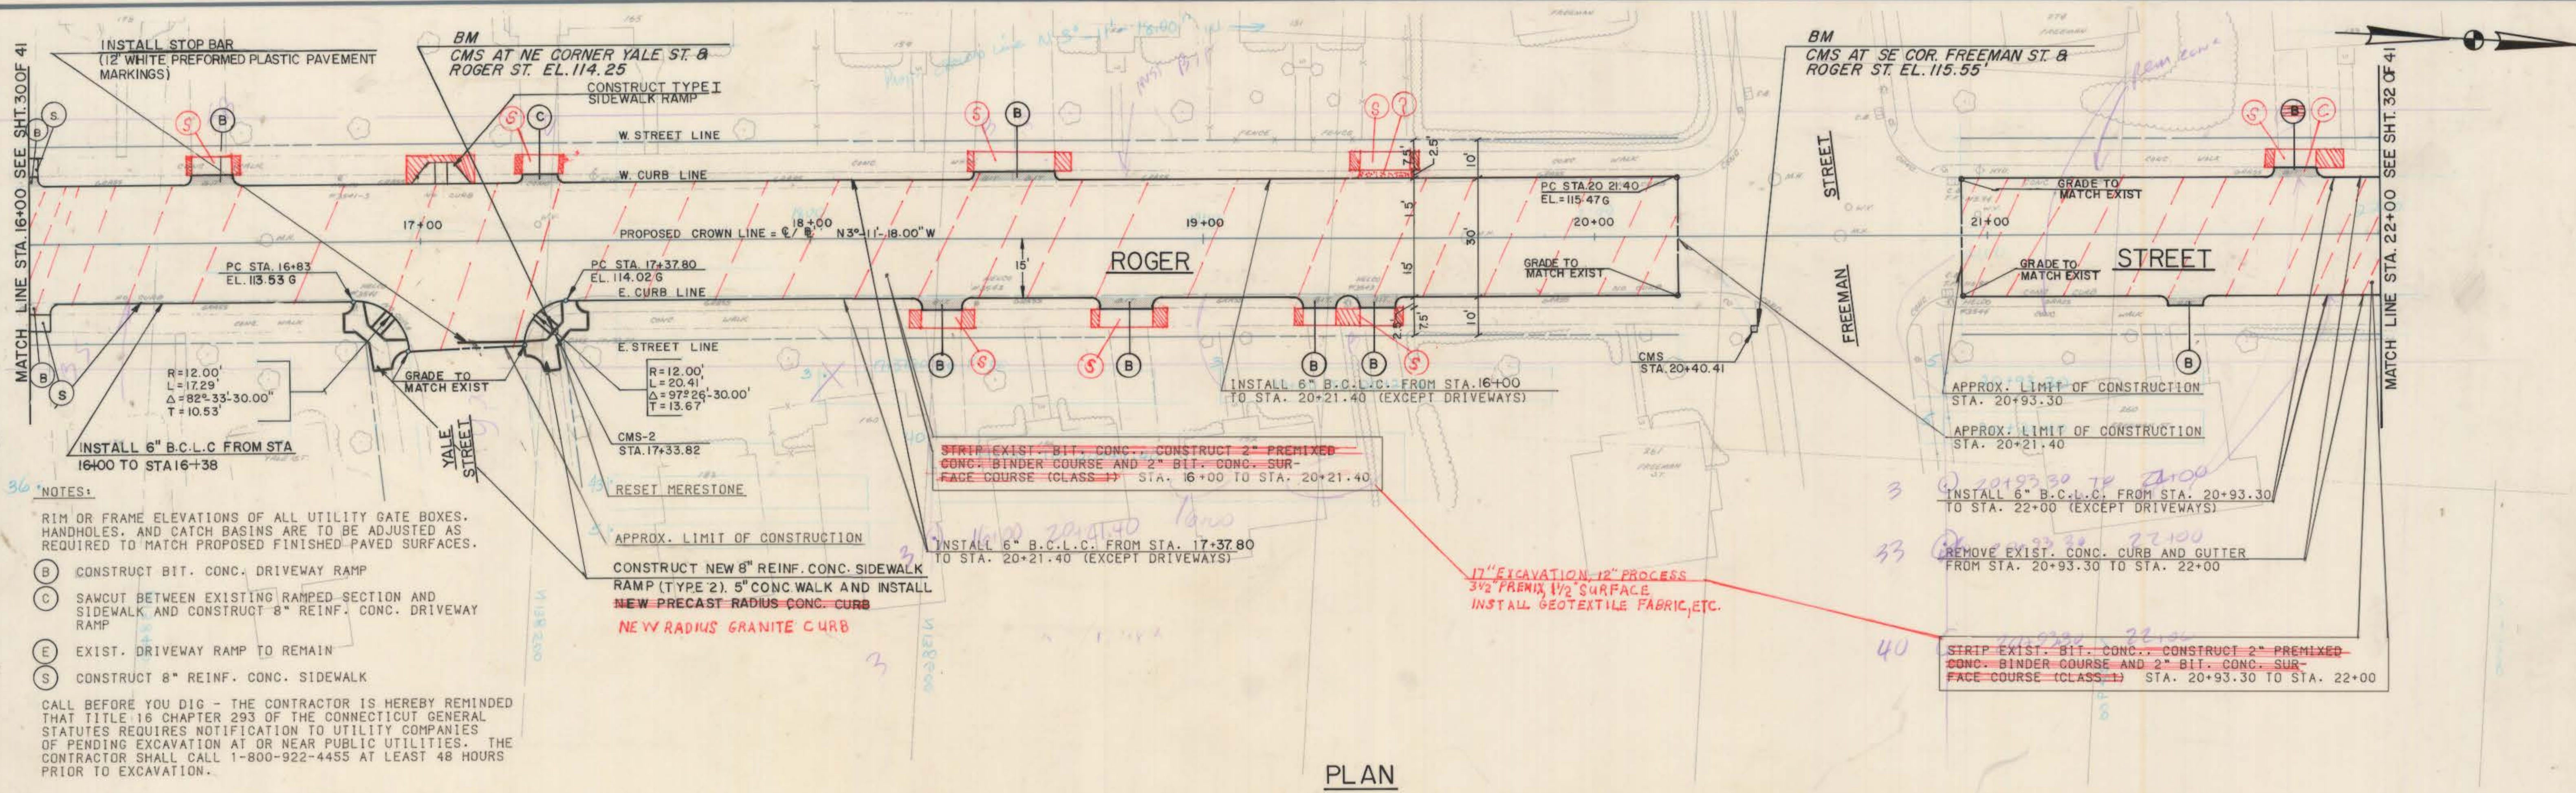

PLAN

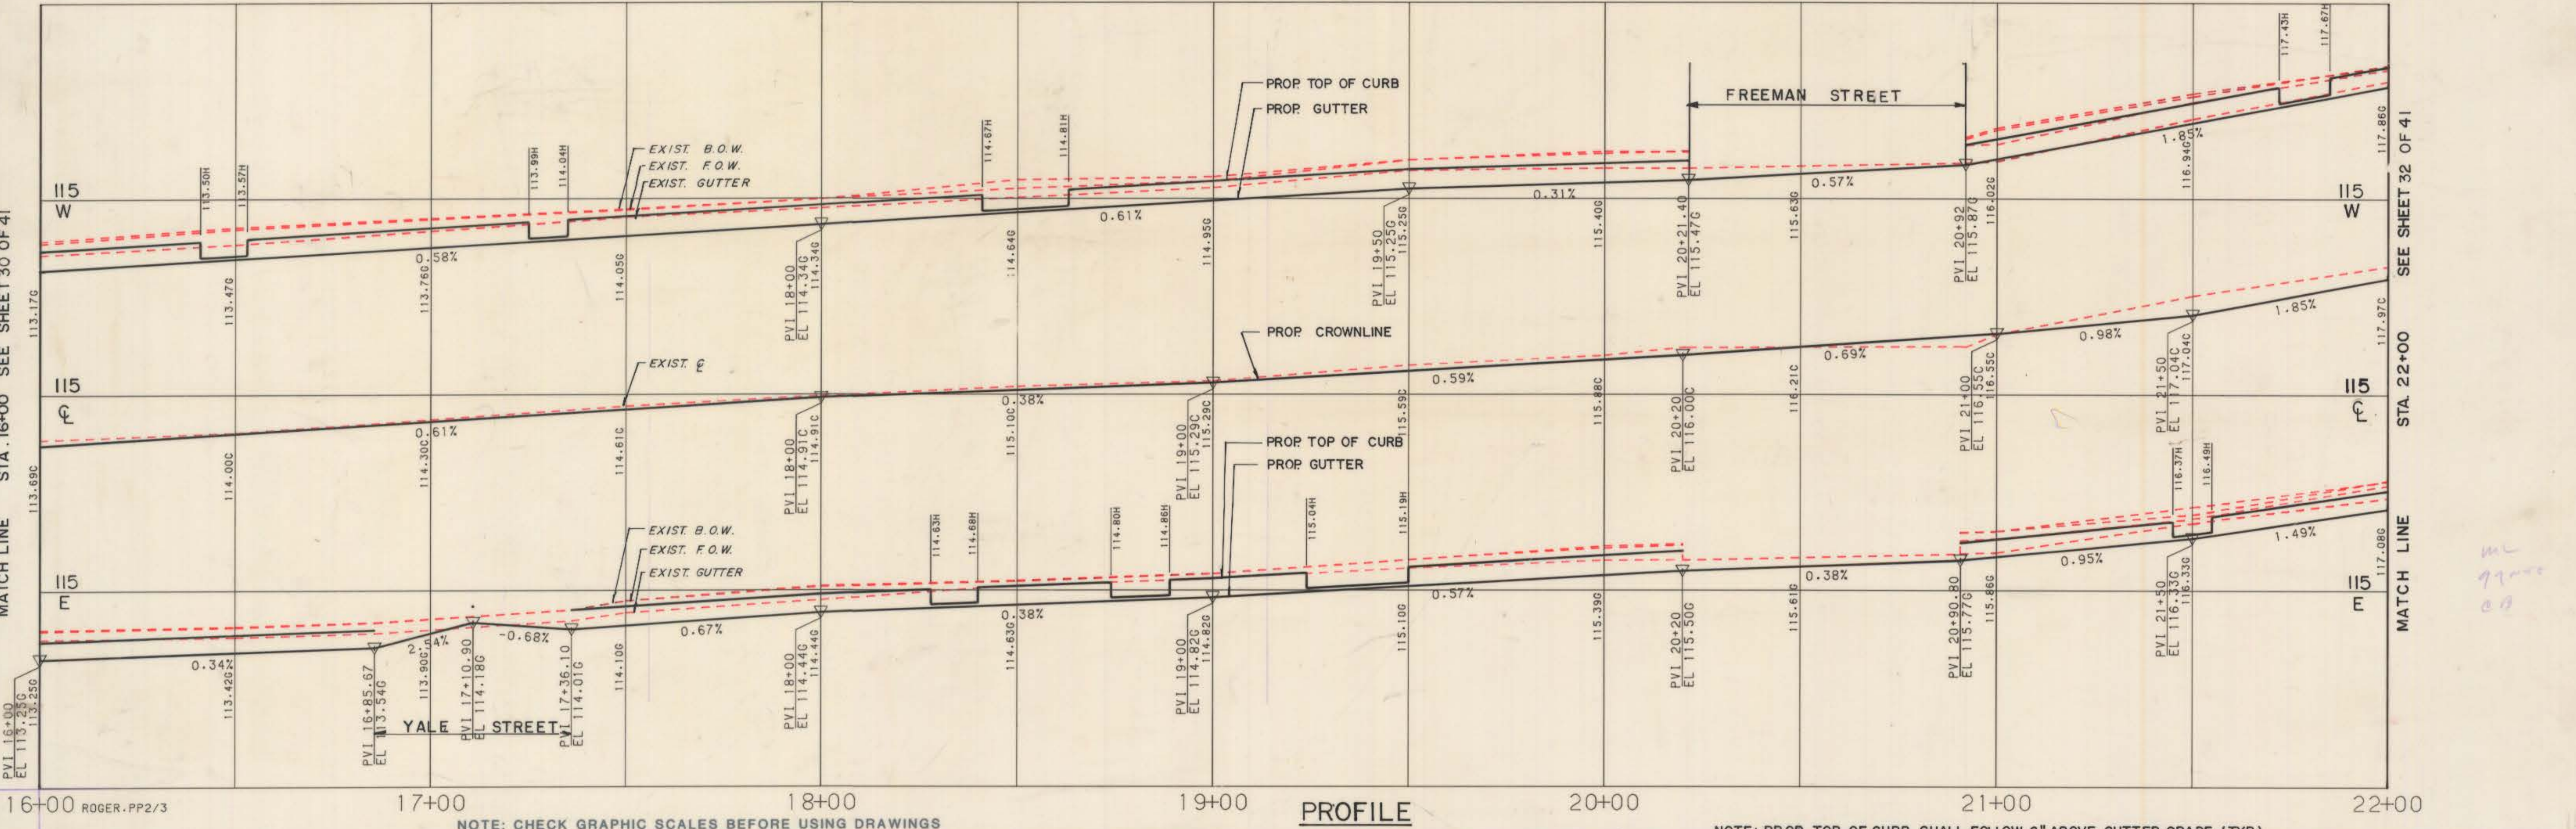

PROFILE

REVISIONS		NO.		DATE	DESCRIPTION

SUPV.	JAC
DESIGN	MDH/AEC
DRAWN	N.D. FORTIN
CHECKED	AEC
DATE	02/14/86

GRAPHIC SCALES	
HORIZ.	1"=20'
VERT.	1"=2'

ROADWAY RECONSTRUCTION HARTFORD, CONNECTICUT	
---	--

--	--

Hayden Wegman Consulting Engineers	
WEST HARTFORD NEW YORK • BOSTON • BUFFALO ATLANTA • MEMPHIS	

CITY OF HARTFORD, CONNECTICUT DEPARTMENT OF PUBLIC WORKS BUREAU OF ENGINEERING SERVICES	
---	--

ROGER STREET STA. 16+00 TO STA. 22+00	
--	--

PLAN AND PROFILE	
DAYBOOK NO. 011005	SHEET 31
DATE	Contract No. E-86-2 Job No. 852534 OF 41