
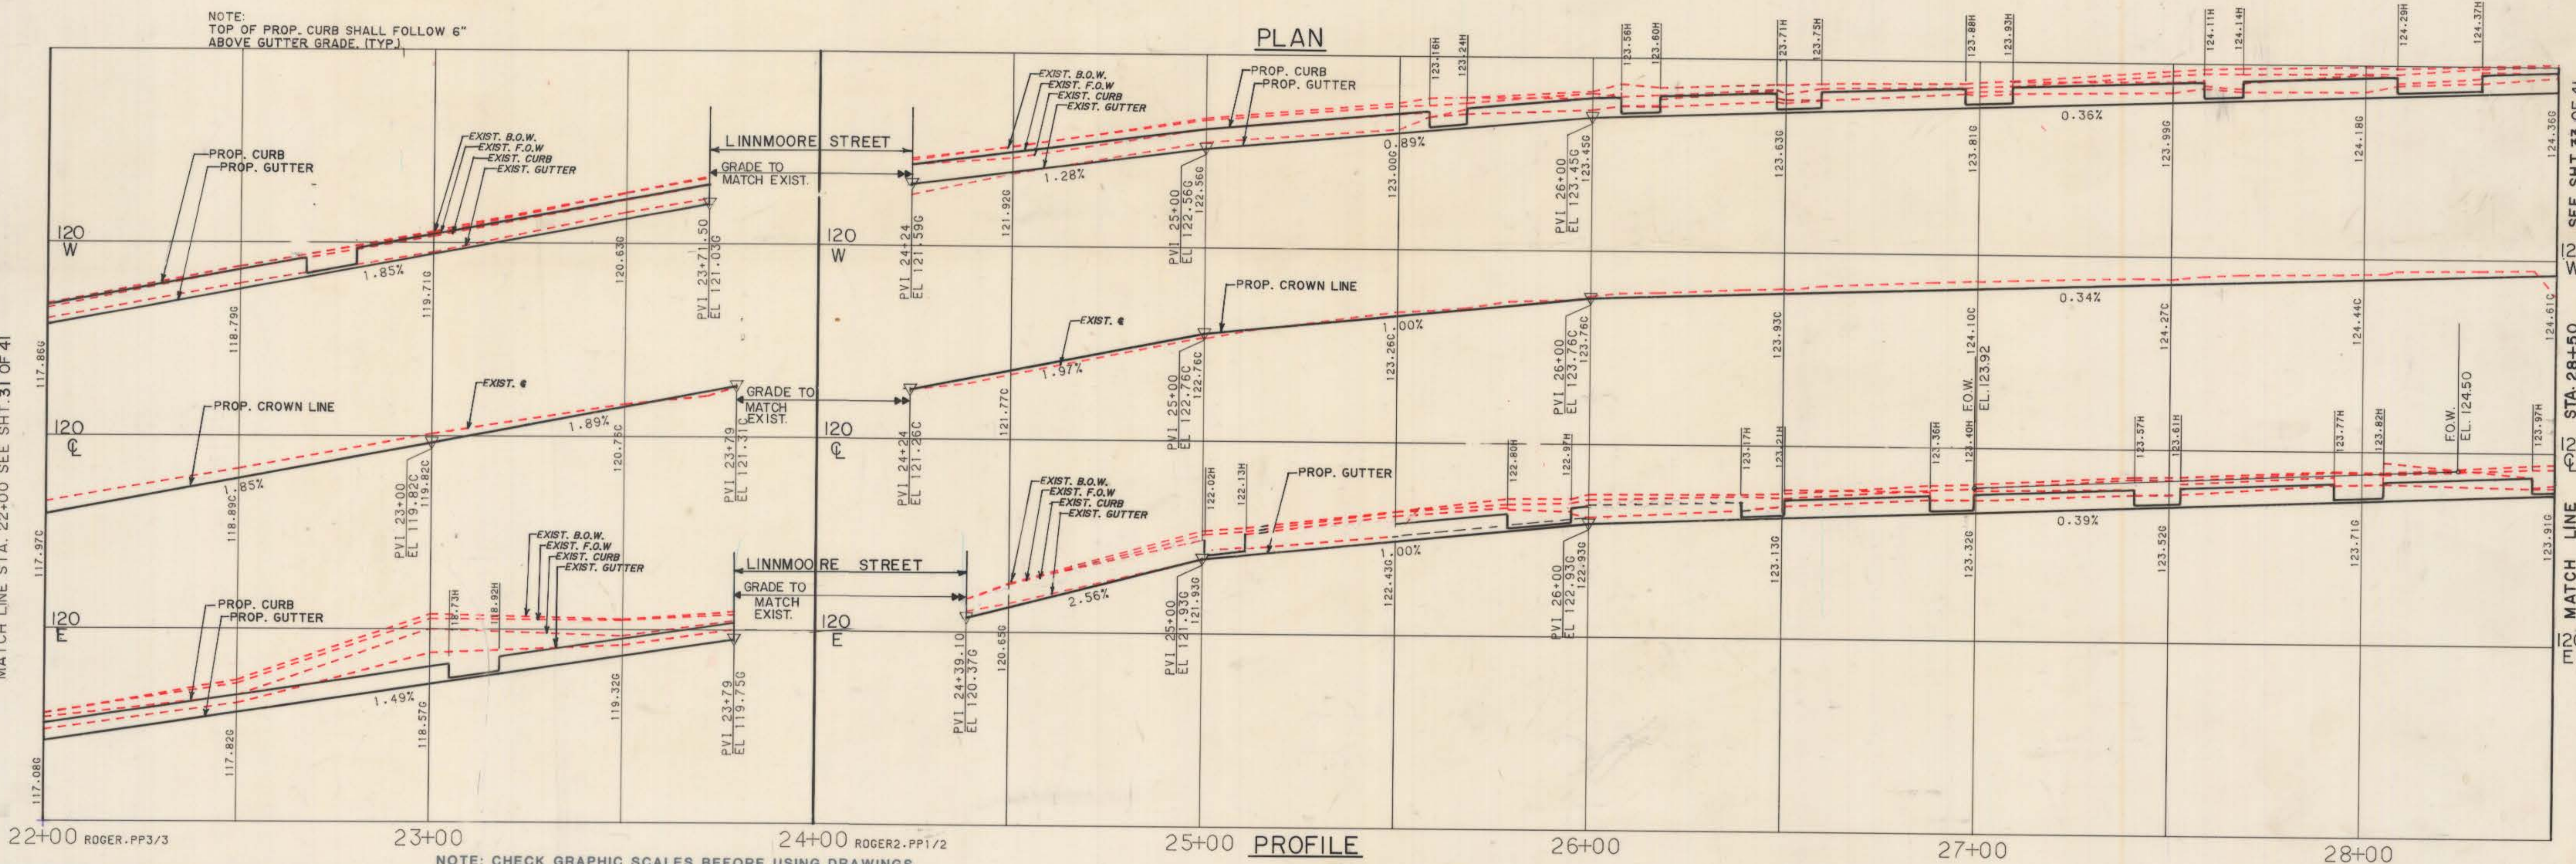


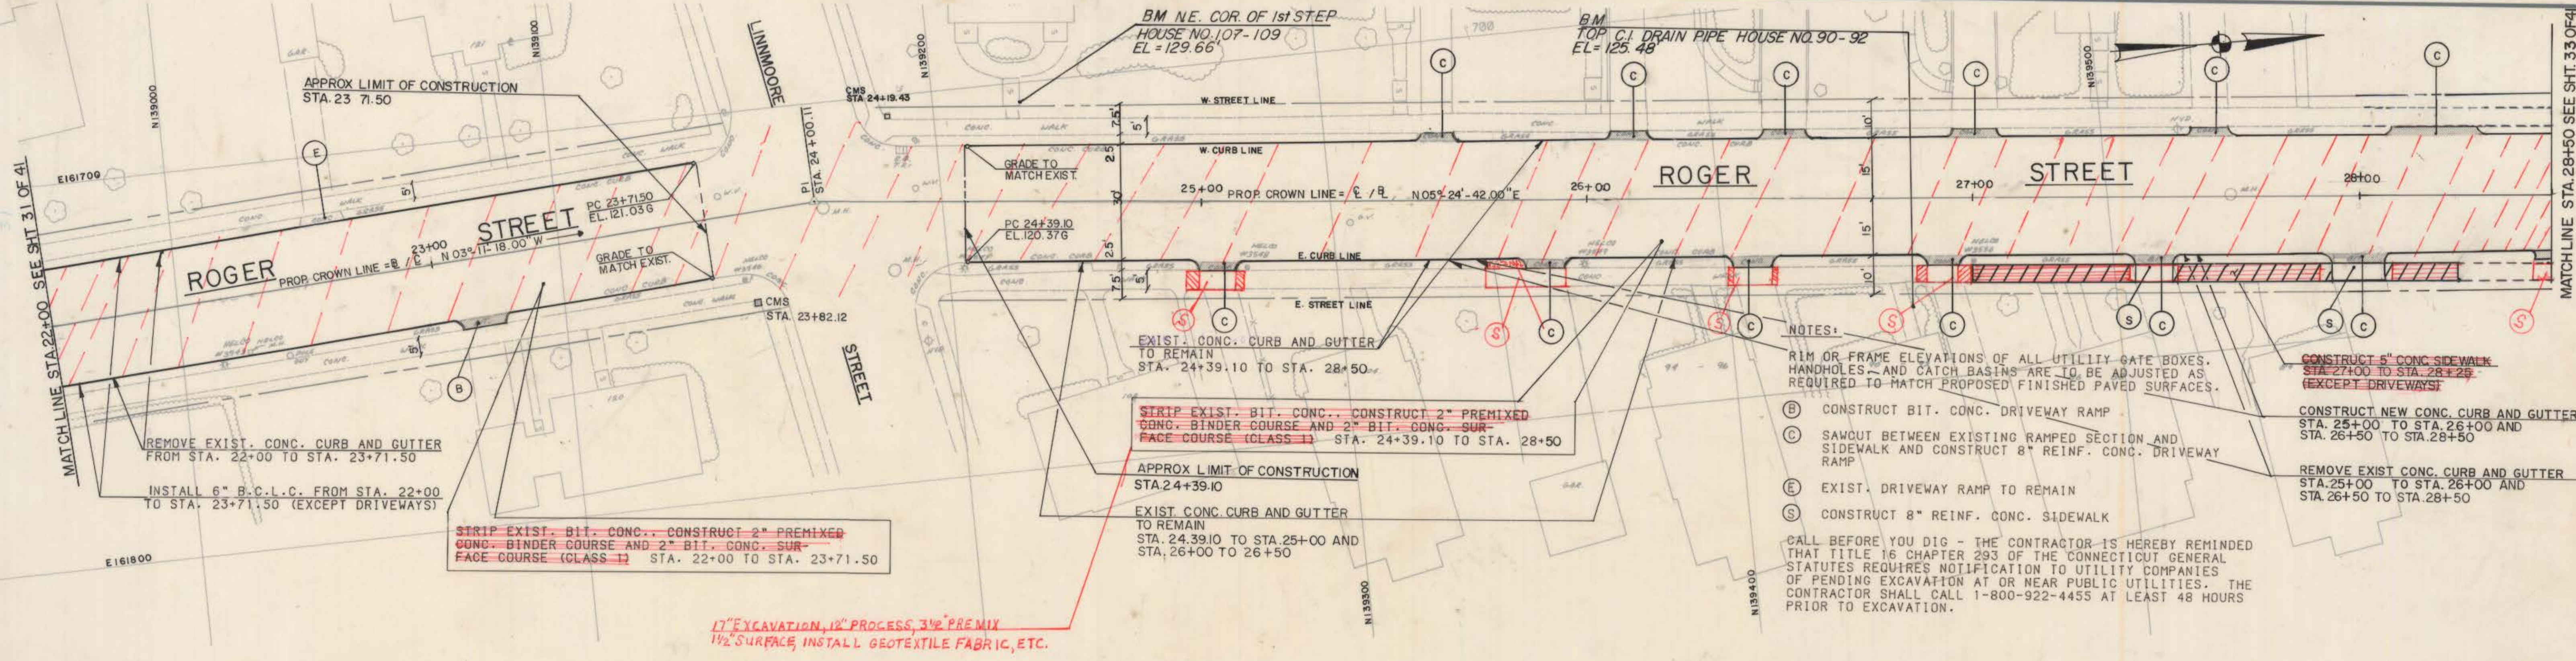

NO. DATE DESCRIPTION		REVISIONS		SUPV. JAC DESIGN MDH/AEC DRAWN RG CHECKED AEC DATE 02-14-86		GRAPHIC SCALES HORIZ. 1"=20' VERT. 1"=2'		ROADWAY RECONSTRUCTION HARTFORD, CONNECTICUT				Hayden Wegman Consulting Engineers WEST HARTFORD NEW YORK • BOSTON • BUFFALO ATLANTA • MEMPHIS		CITY OF HARTFORD, CONNECTICUT DEPARTMENT OF PUBLIC WORKS BUREAU OF ENGINEERING SERVICES DAYBOOK NO. 011005 DATE		ROGER STREET STA. 22+00 TO STA. 28+50 PLAN AND PROFILE CONTRACT NO. E86-2 Job No. 852534		SHEET 32 OF 41	
----------------------	--	-----------	--	---	--	--	--	---	--	--	--	--	--	---	--	---	--	-------------------	--