




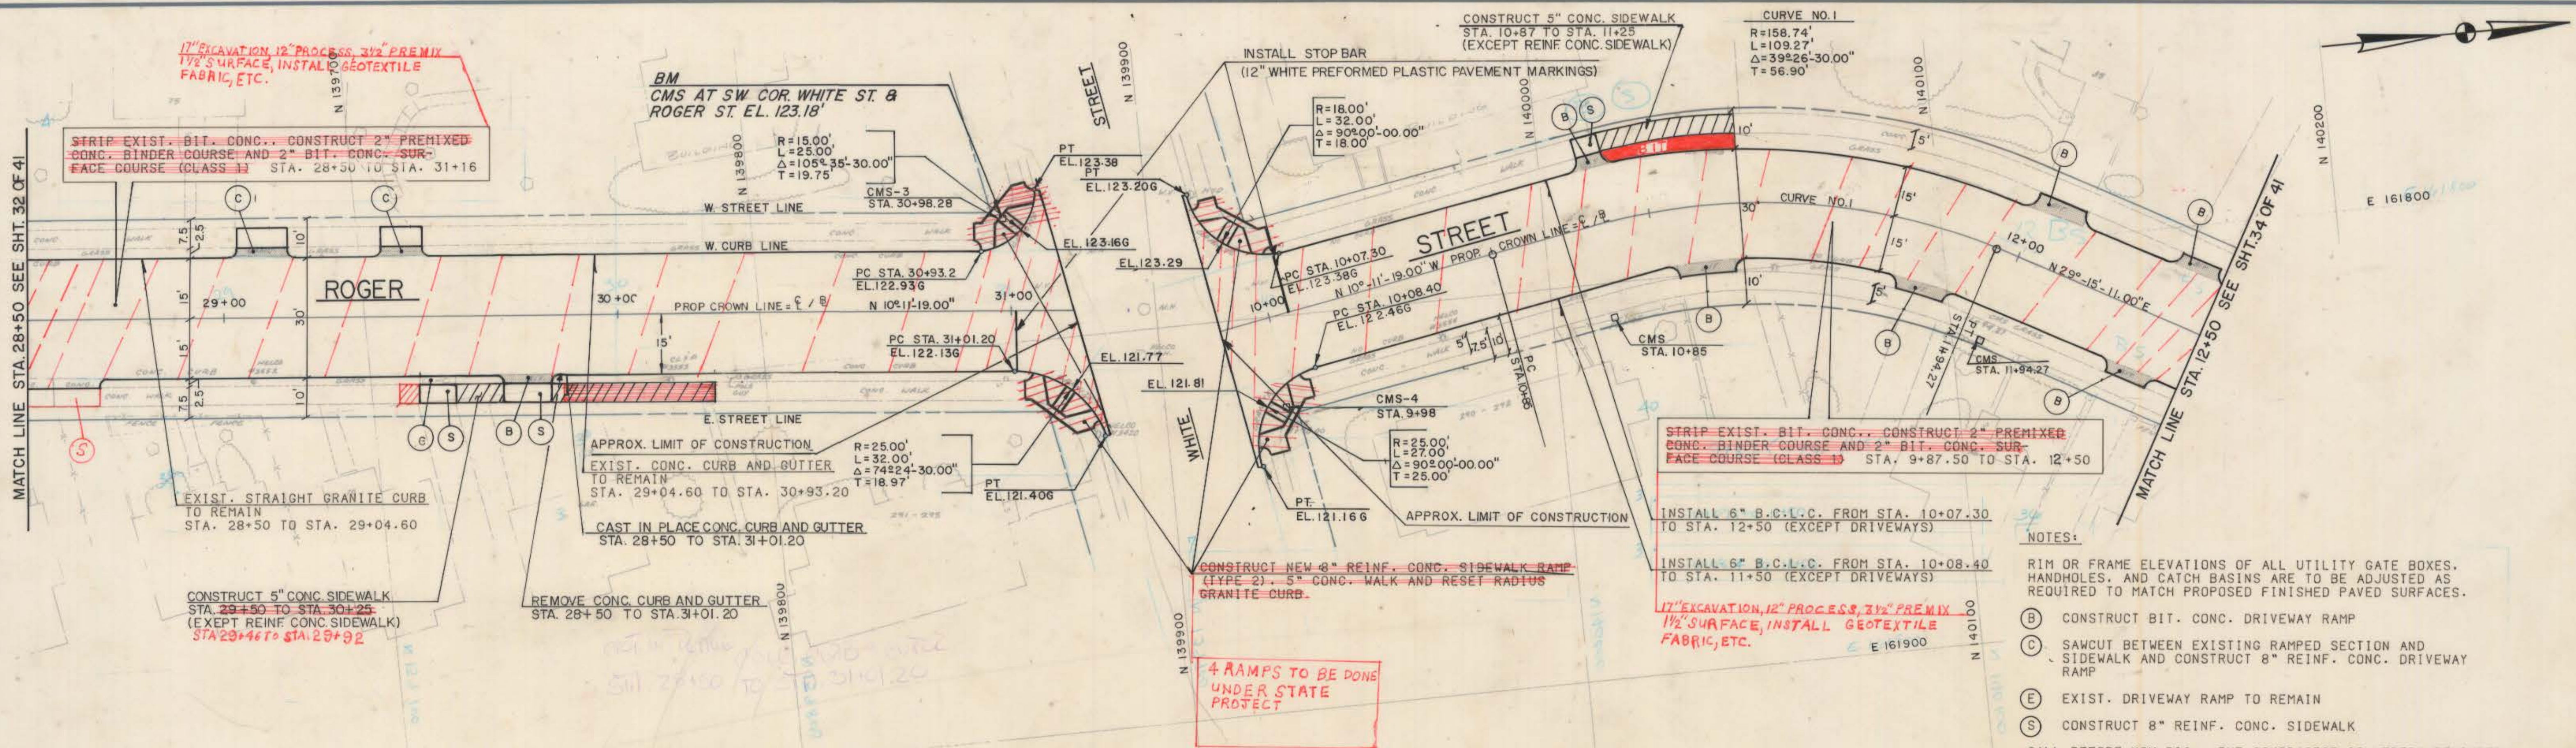

PLAN

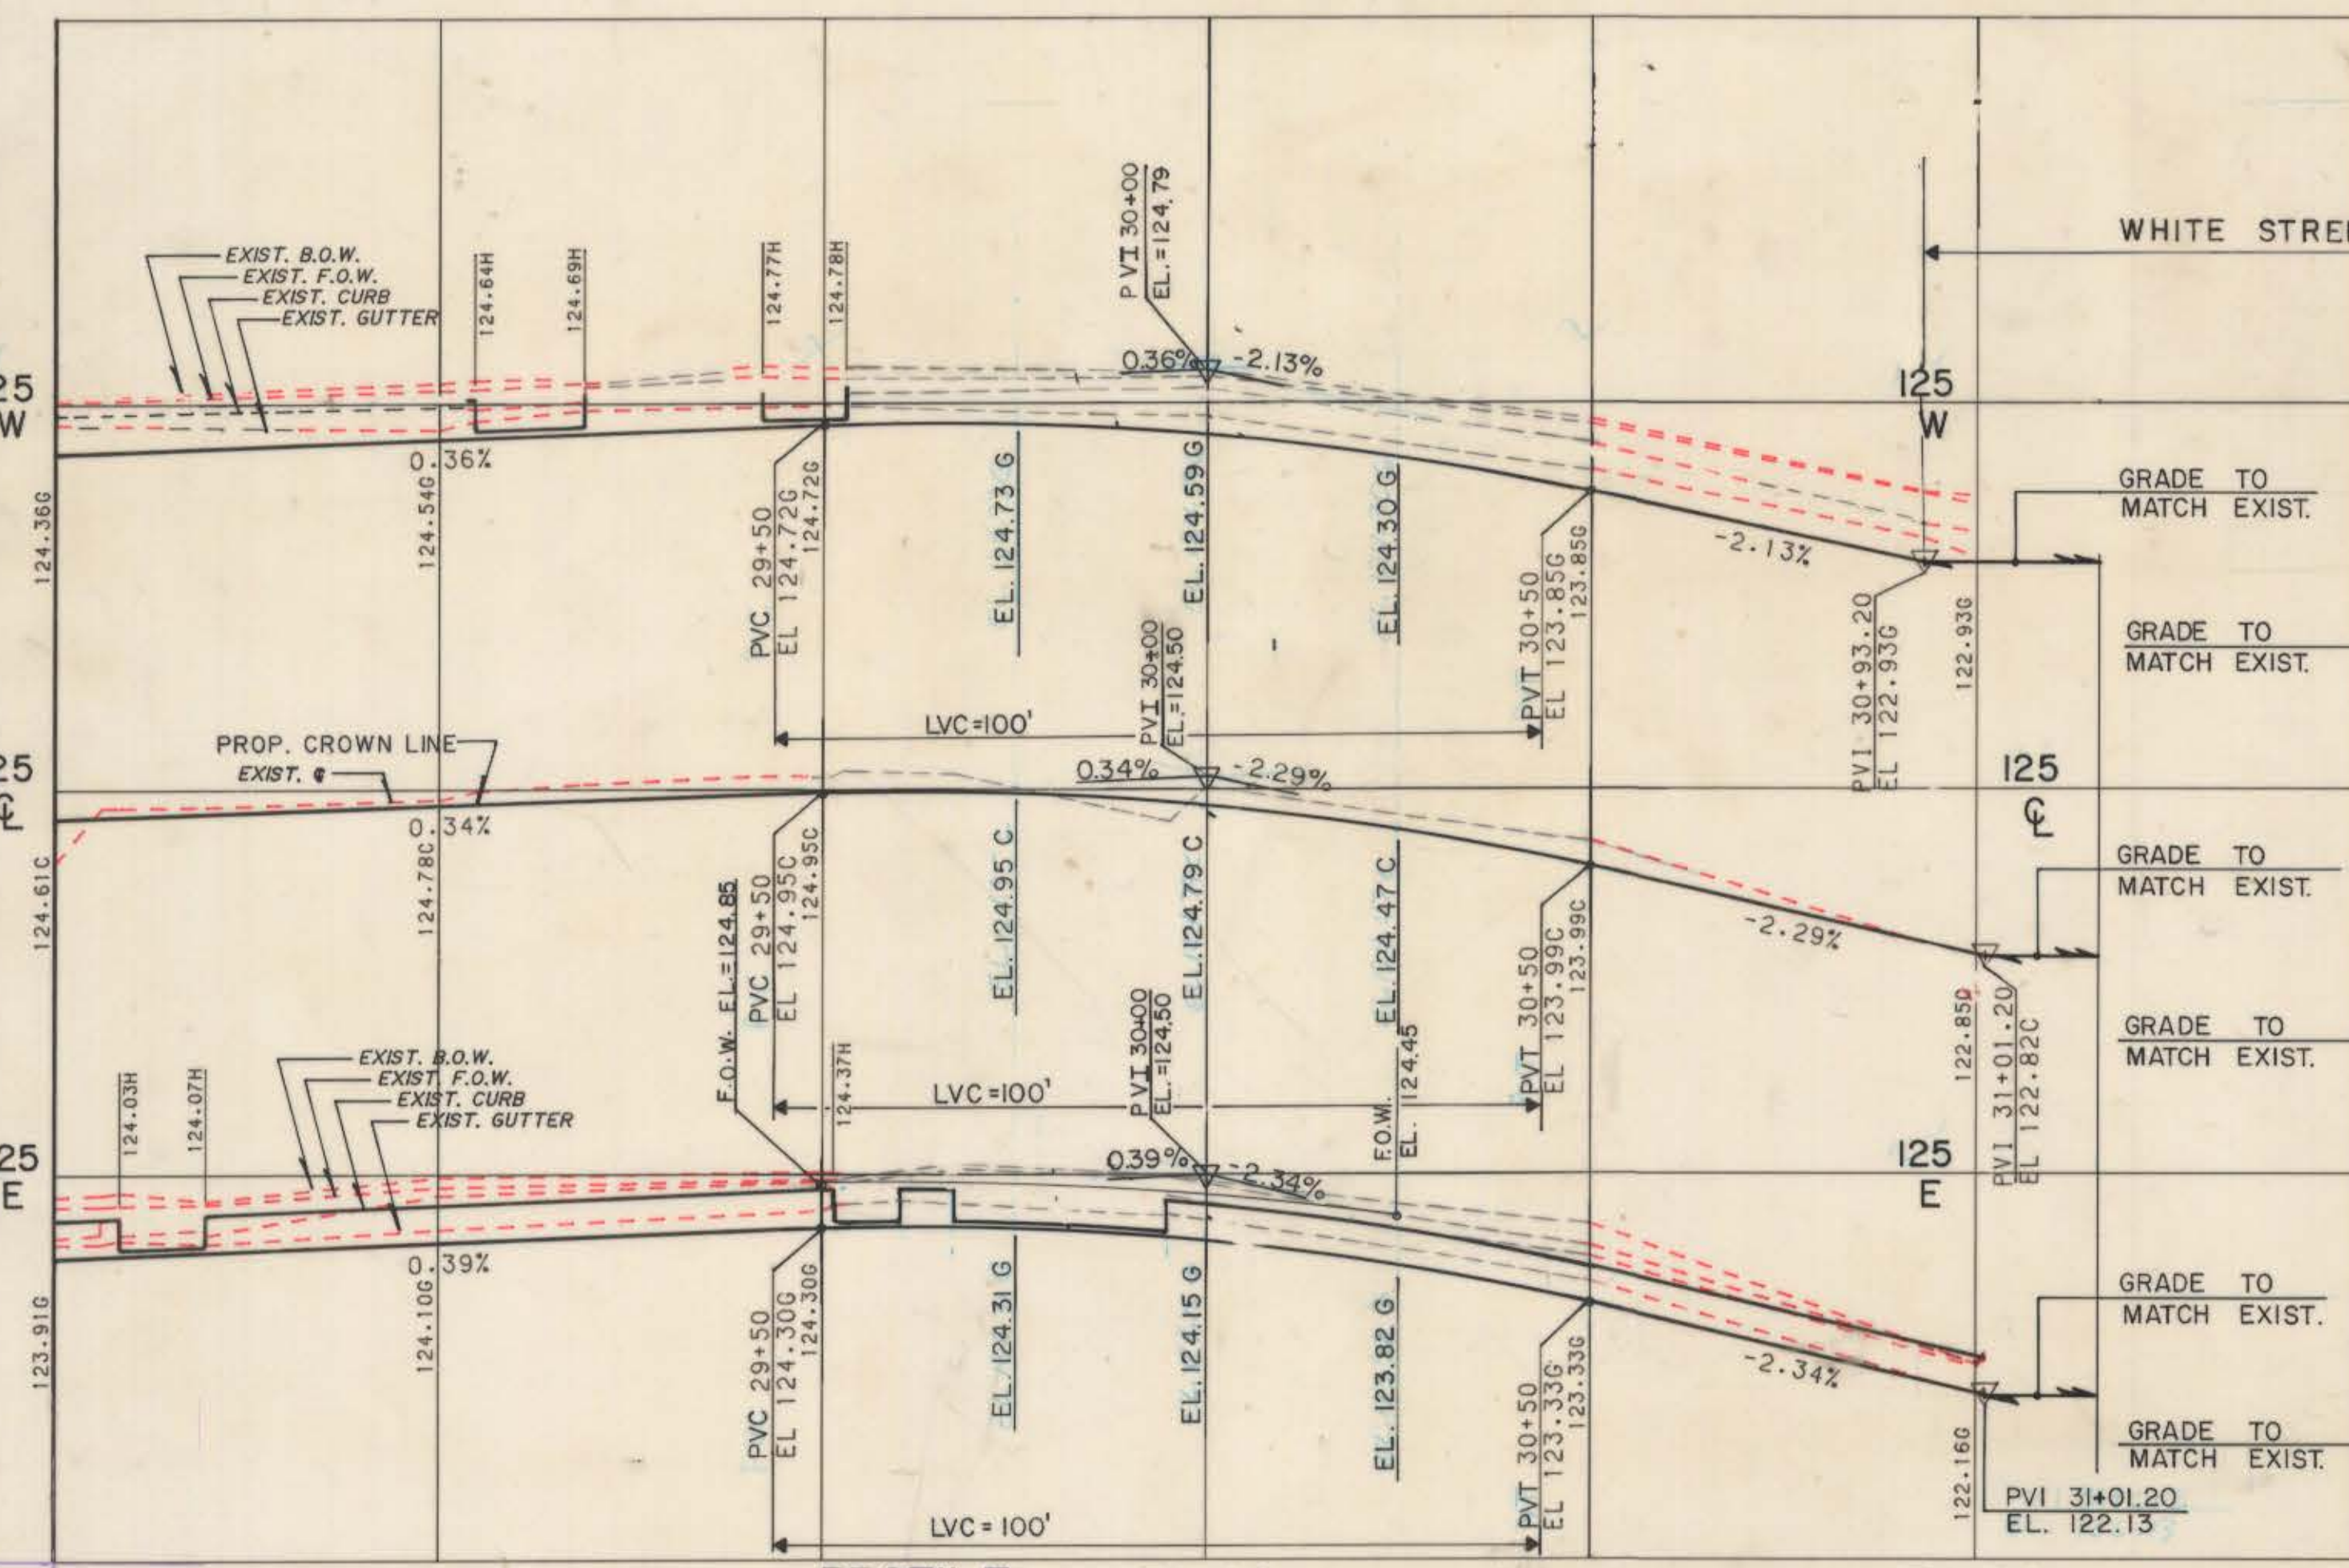

PROFILE
NOTE: CHECK GRAPHIC SCALES BEFORE USING DRAWINGS

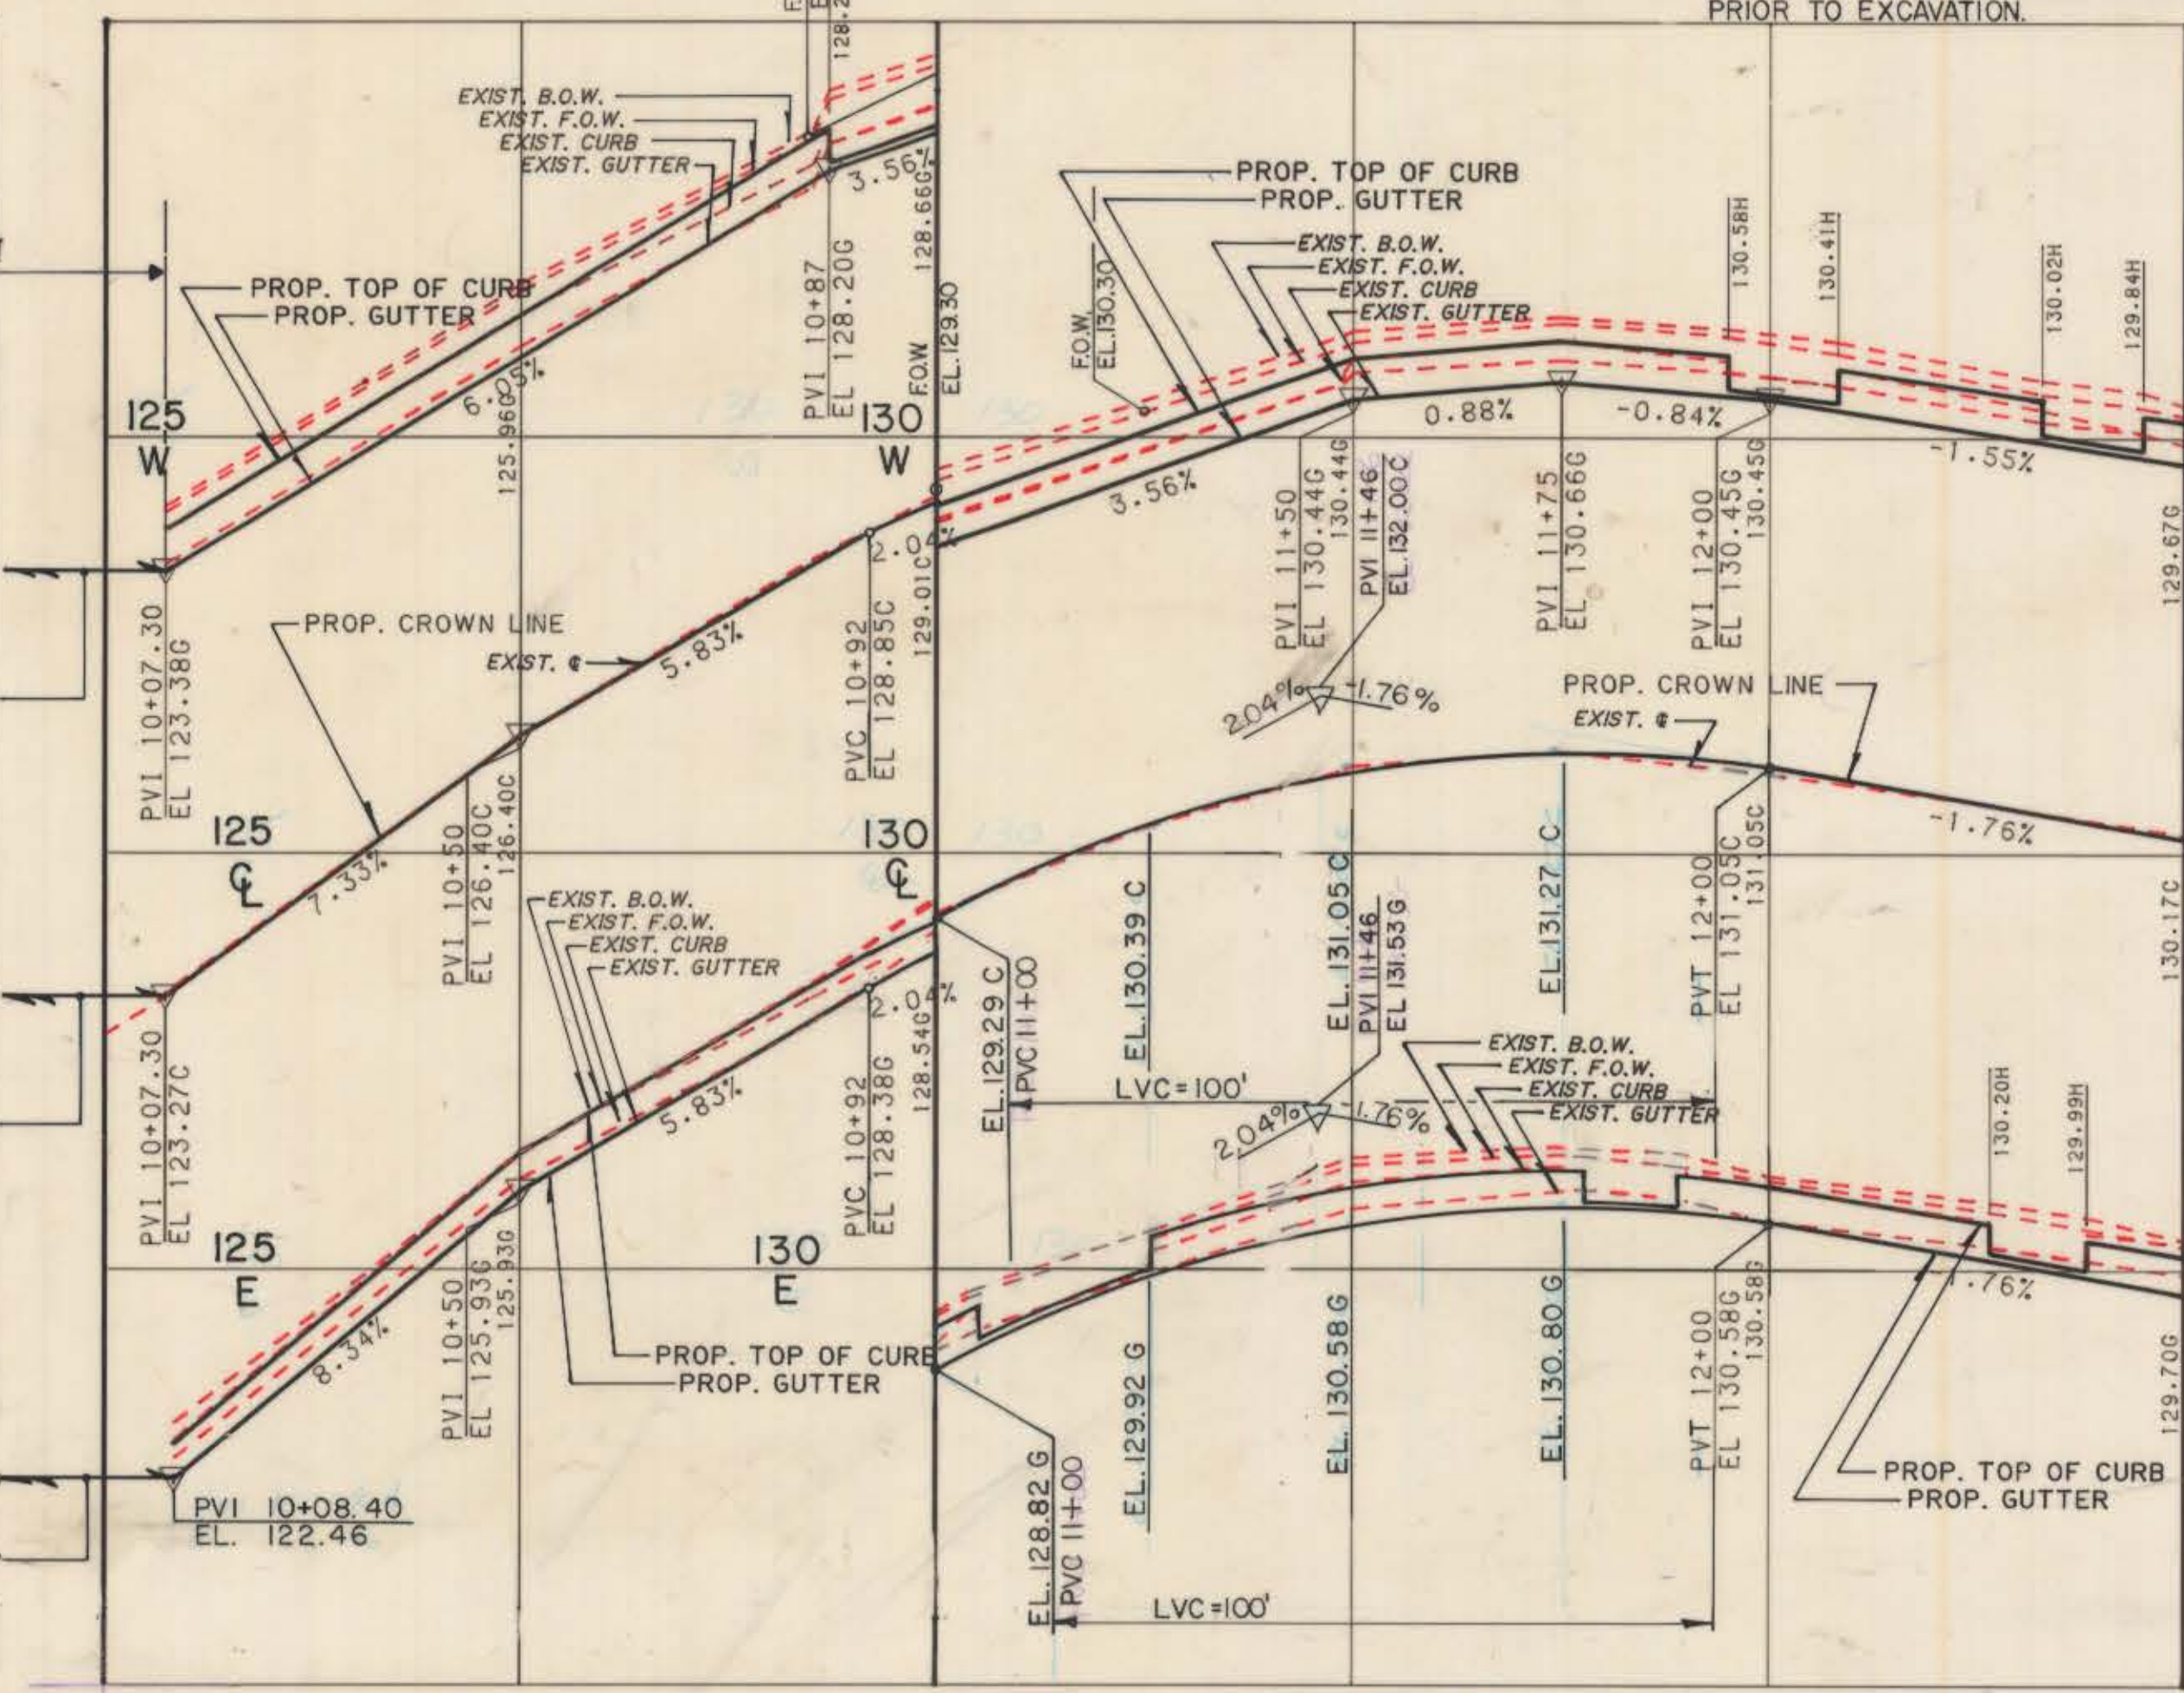

PROFILE

- NOTES:
- (B) CONSTRUCT BIT. CONC. DRIVEWAY RAMP
 - (C) SAWCUT BETWEEN EXISTING RAMPED SECTION AND SIDEWALK AND CONSTRUCT 8" REINF. CONC. DRIVEWAY RAMP
 - (E) EXIST. DRIVEWAY RAMP TO REMAIN
 - (S) CONSTRUCT 8" REINF. CONC. SIDEWALK
- CALL BEFORE YOU DIG - THE CONTRACTOR IS HEREBY REMINDED THAT TITLE 16 CHAPTER 293 OF THE CONNECTICUT GENERAL STATUTES REQUIRES NOTIFICATION TO UTILITY COMPANIES OF PENDING EXCAVATION AT OR NEAR PUBLIC UTILITIES. THE CONTRACTOR SHALL CALL 1-800-922-4455 AT LEAST 48 HOURS PRIOR TO EXCAVATION.

NO.		DATE	DESCRIPTION
1		02-14-86	REVISIONS

SUPV.	JAC
DESIGN	MDH/AEC
DRAWN	N.D. FORTIN
CHECKED	AEC
DATE	02-14-86



Hayden | Wegman
Consulting Engineers

WEST HARTFORD
NEW YORK • BOSTON • BUFFALO
ATLANTA • MEMPHIS

CITY OF HARTFORD, CONNECTICUT
DEPARTMENT OF PUBLIC WORKS
BUREAU OF ENGINEERING SERVICES

DAYBOOK NO. 011005
DATE

ROGER STREET
STA. 28+50 TO STA. 31+50
STA. 10+00 TO STA. 12+50

PLAN AND PROFILE

Contract No. E-86-1 Job No. - 852534

SHEET 33 OF 41