


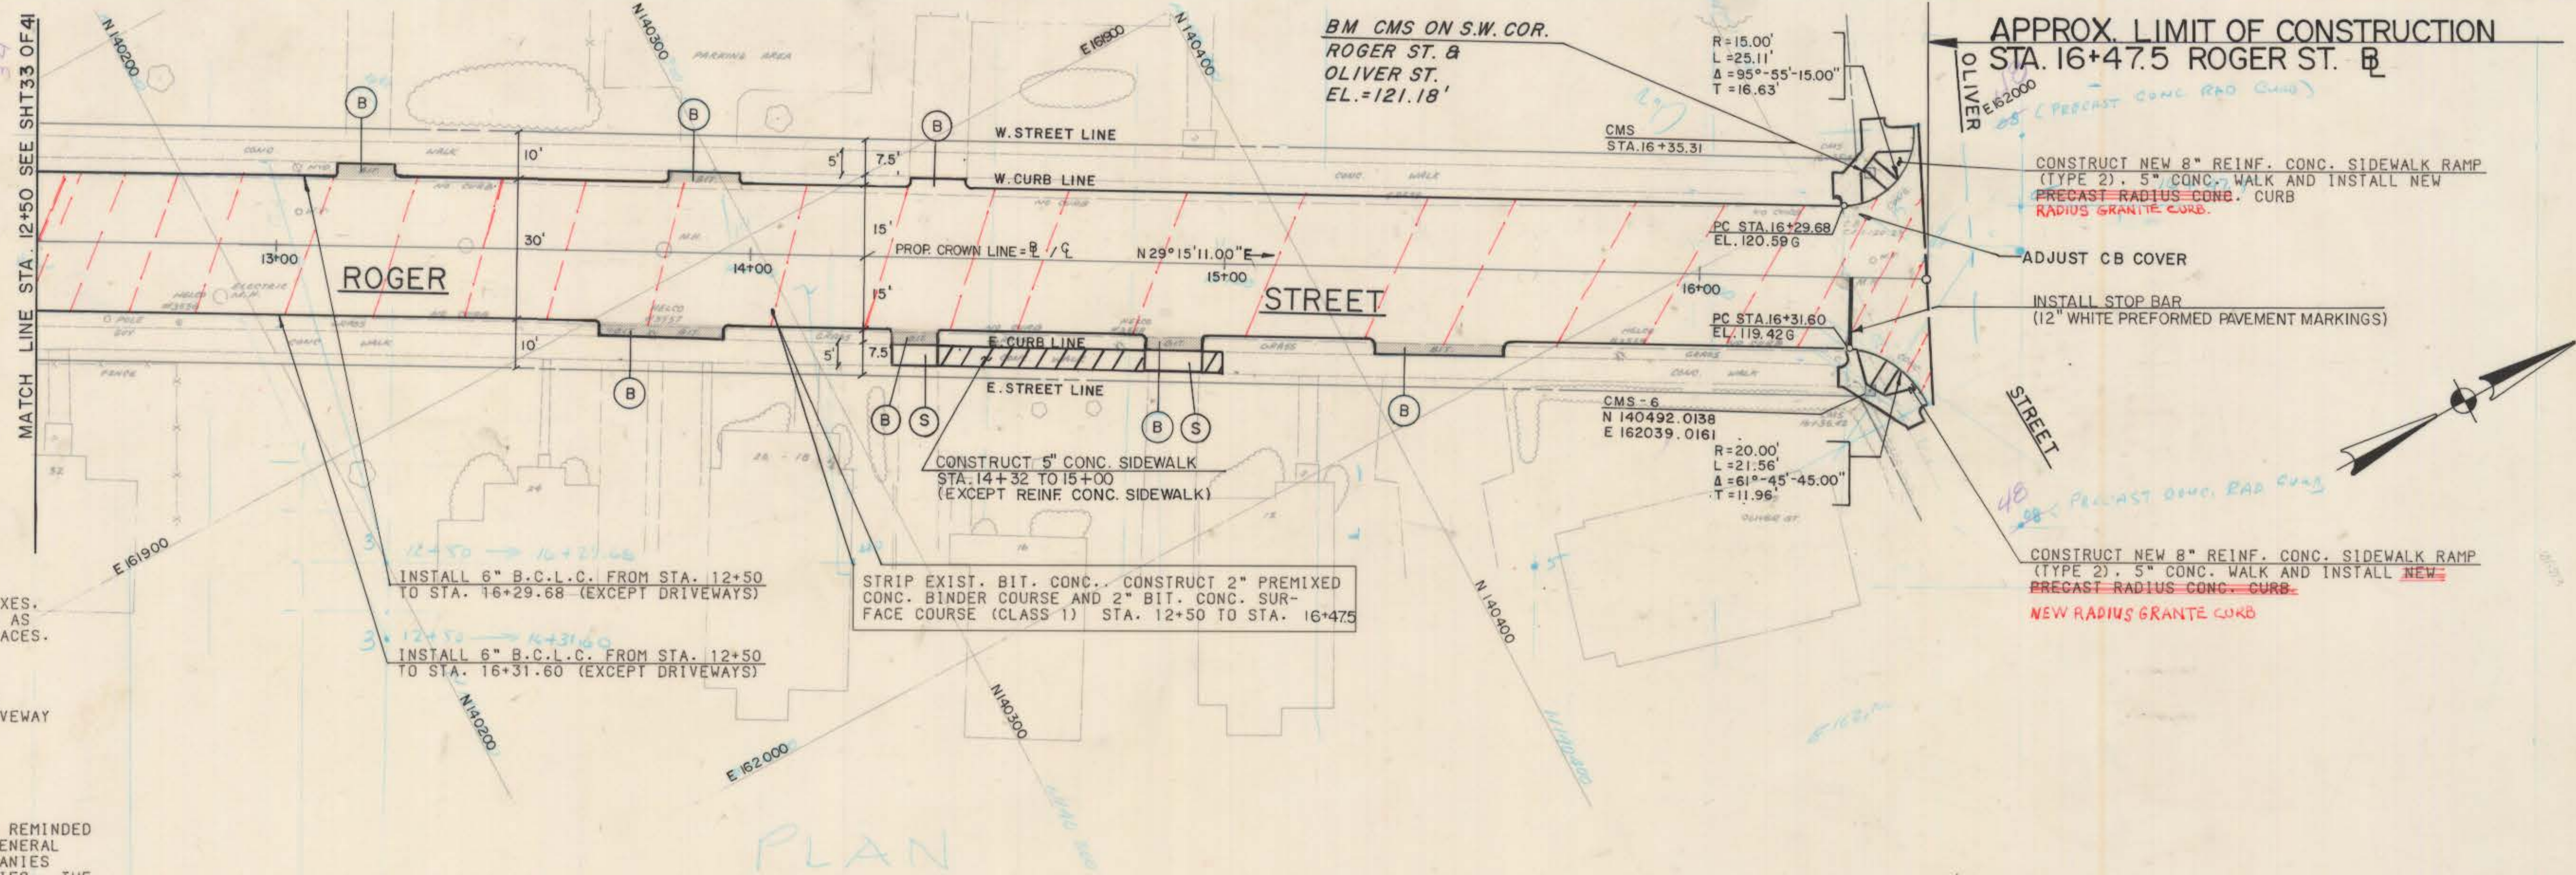

NOTES:

RIM OR FRAME ELEVATIONS OF ALL UTILITY GATE BOXES, HANDHOLES, AND CATCH BASINS ARE TO BE ADJUSTED AS REQUIRED TO MATCH PROPOSED FINISHED PAVED SURFACES.

(B) CONSTRUCT BIT. CONC. DRIVEWAY RAMP


(C) SAWCUT BETWEEN EXISTING RAMPED SECTION AND SIDEWALK AND CONSTRUCT 8\" REINF. CONC. DRIVEWAY RAMP

(E) EXIST. DRIVEWAY RAMP TO REMAIN

(S) CONSTRUCT 8\" REINF. CONC. SIDEWALK

CALL BEFORE YOU DIG - THE CONTRACTOR IS HEREBY REMINDED THAT TITLE 16 CHAPTER 293 OF THE CONNECTICUT GENERAL STATUTES REQUIRES NOTIFICATION TO UTILITY COMPANIES OF PENDING EXCAVATION AT OR NEAR PUBLIC UTILITIES. THE CONTRACTOR SHALL CALL 1-800-922-4455 AT LEAST 48 HOURS PRIOR TO EXCAVATION.

PLAN

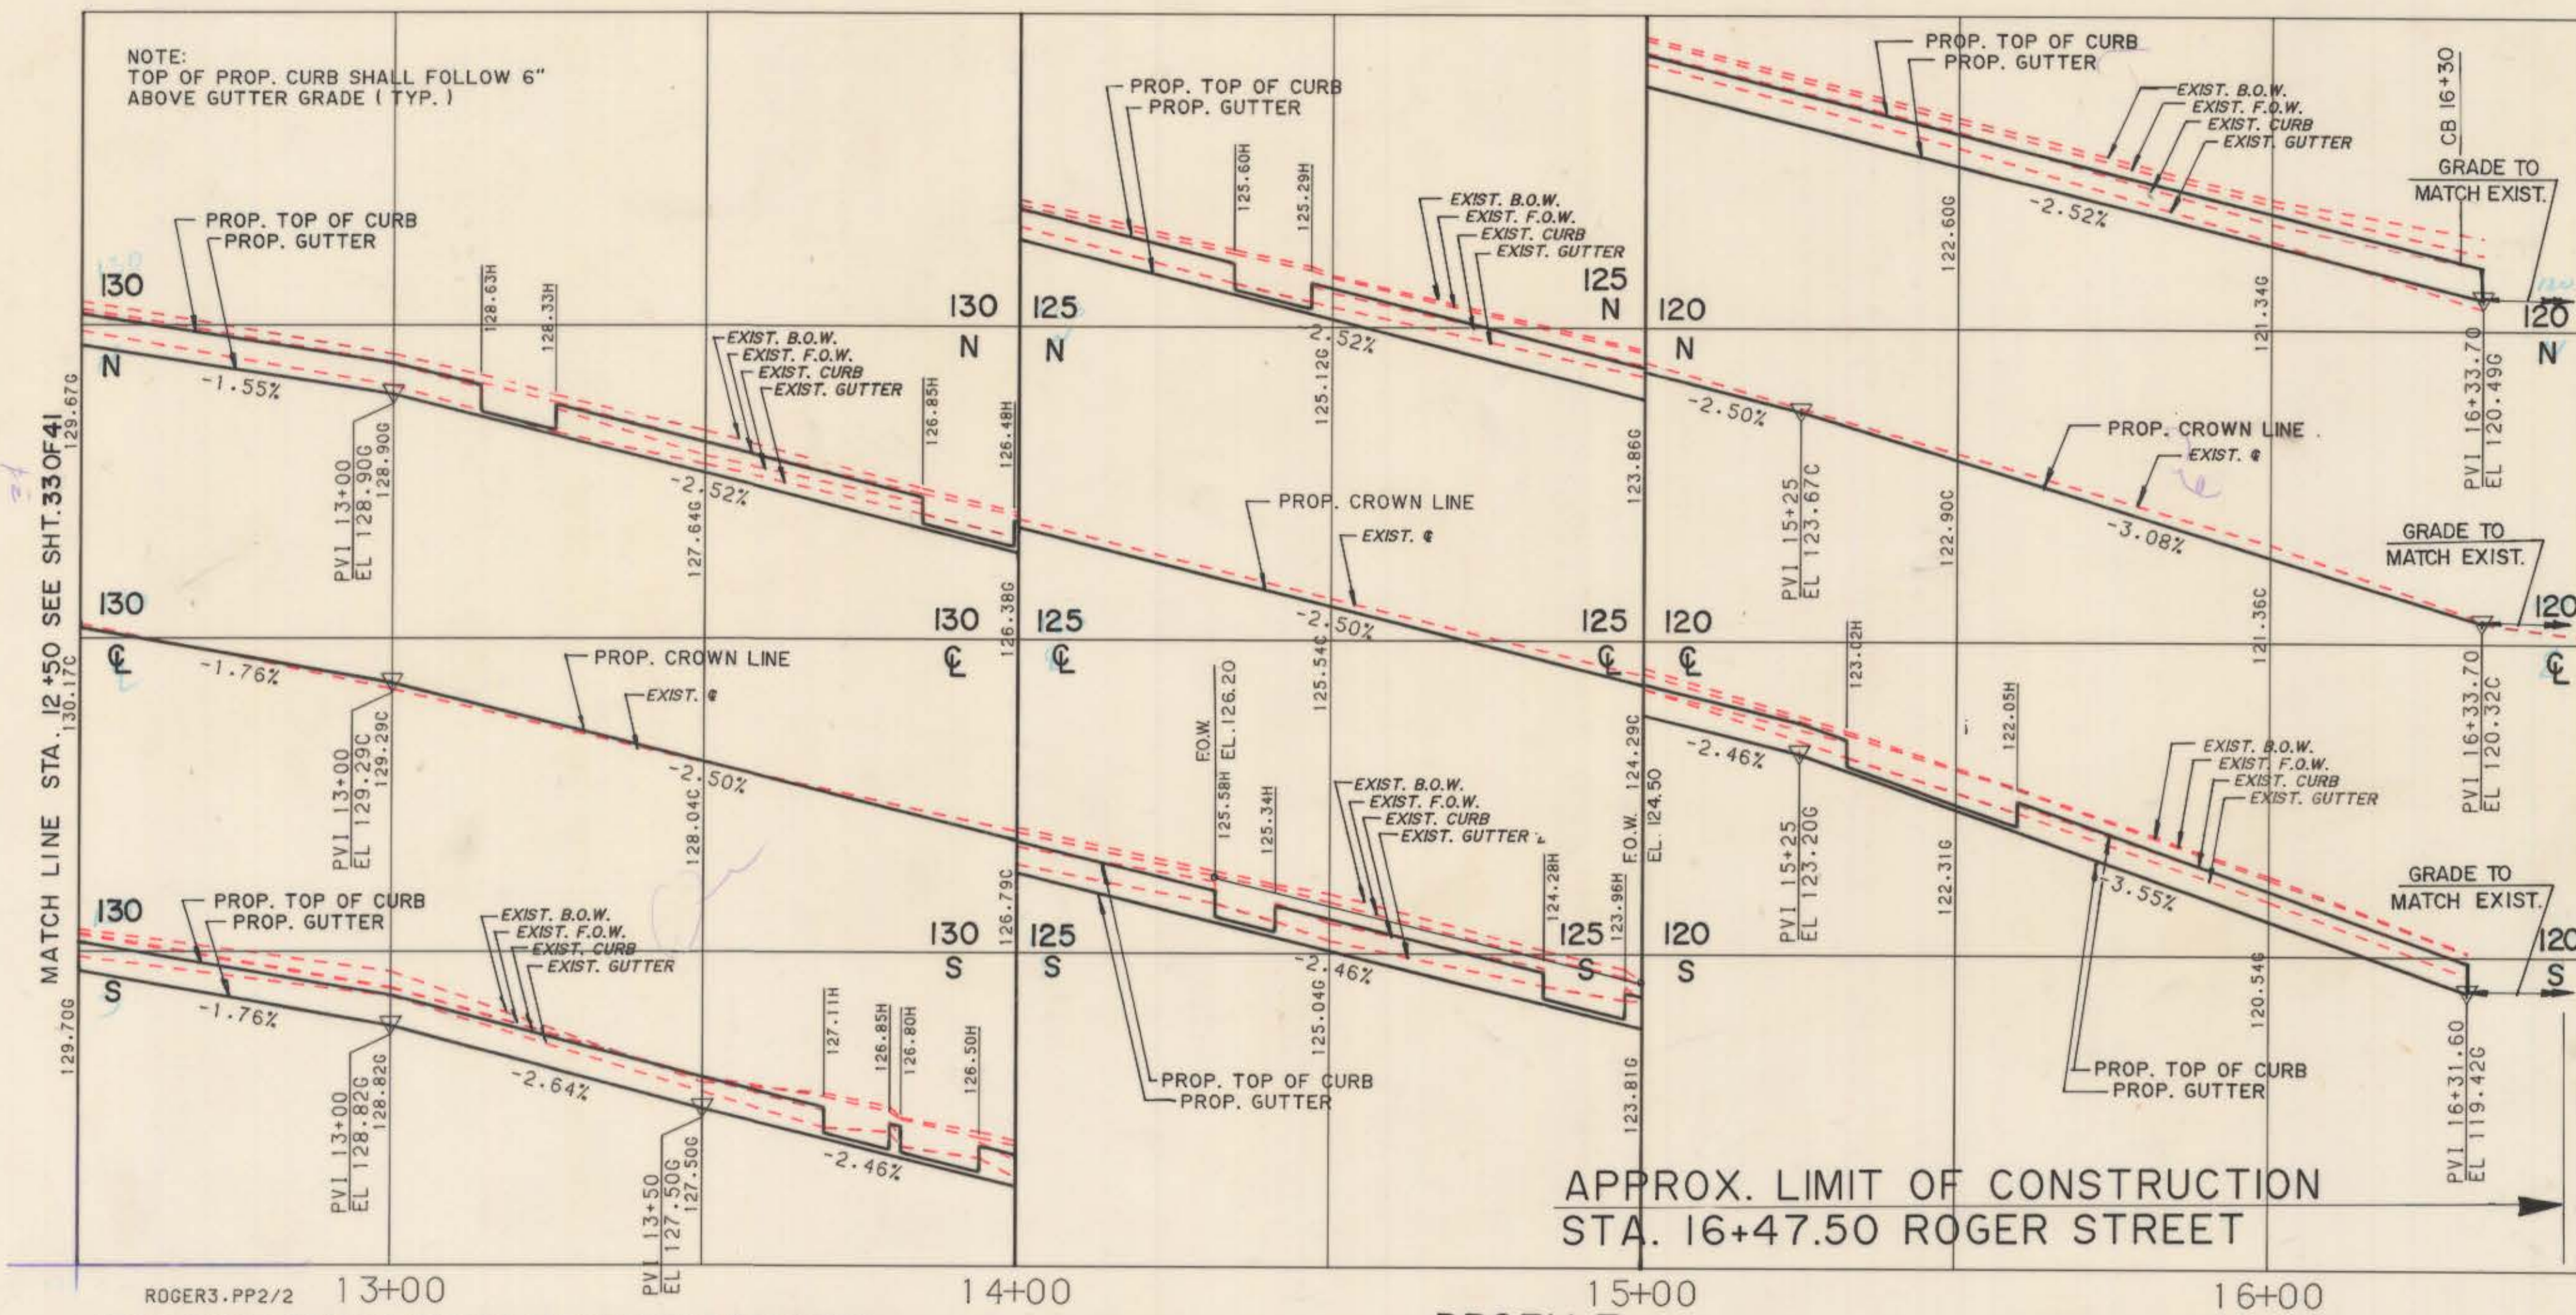

PROFILE

SUPV. JAC DESIGN MDH/AEC DRAWN MJN CHECKED AEC DATE 02-14-86		GRAPHIC SCALES HORIZ. 1"=20' VERT. 1"=2'		ROADWAY RECONSTRUCTION HARTFORD, CONNECTICUT		CITY OF HARTFORD, CONNECTICUT DEPARTMENT OF PUBLIC WORKS BUREAU OF ENGINEERING SERVICES		ROGER STREET STA. 12+50 TO STA. 16+47.50		PLAN AND PROFILE SHEET 34 OF 41	
NO. DATE DESCRIPTION REVISIONS		NO. 10000 REGISTERED PROFESSIONAL ENGINEER		Hayden Wegman Consulting Engineers WEST HARTFORD NEW YORK • BOSTON • BUFFALO ATLANTA • MEMPHIS		DAYBOOK NO. 011005 DATE		Contract No. E86- 2 Job No. - 852534		12+50 → 16+47.50	