



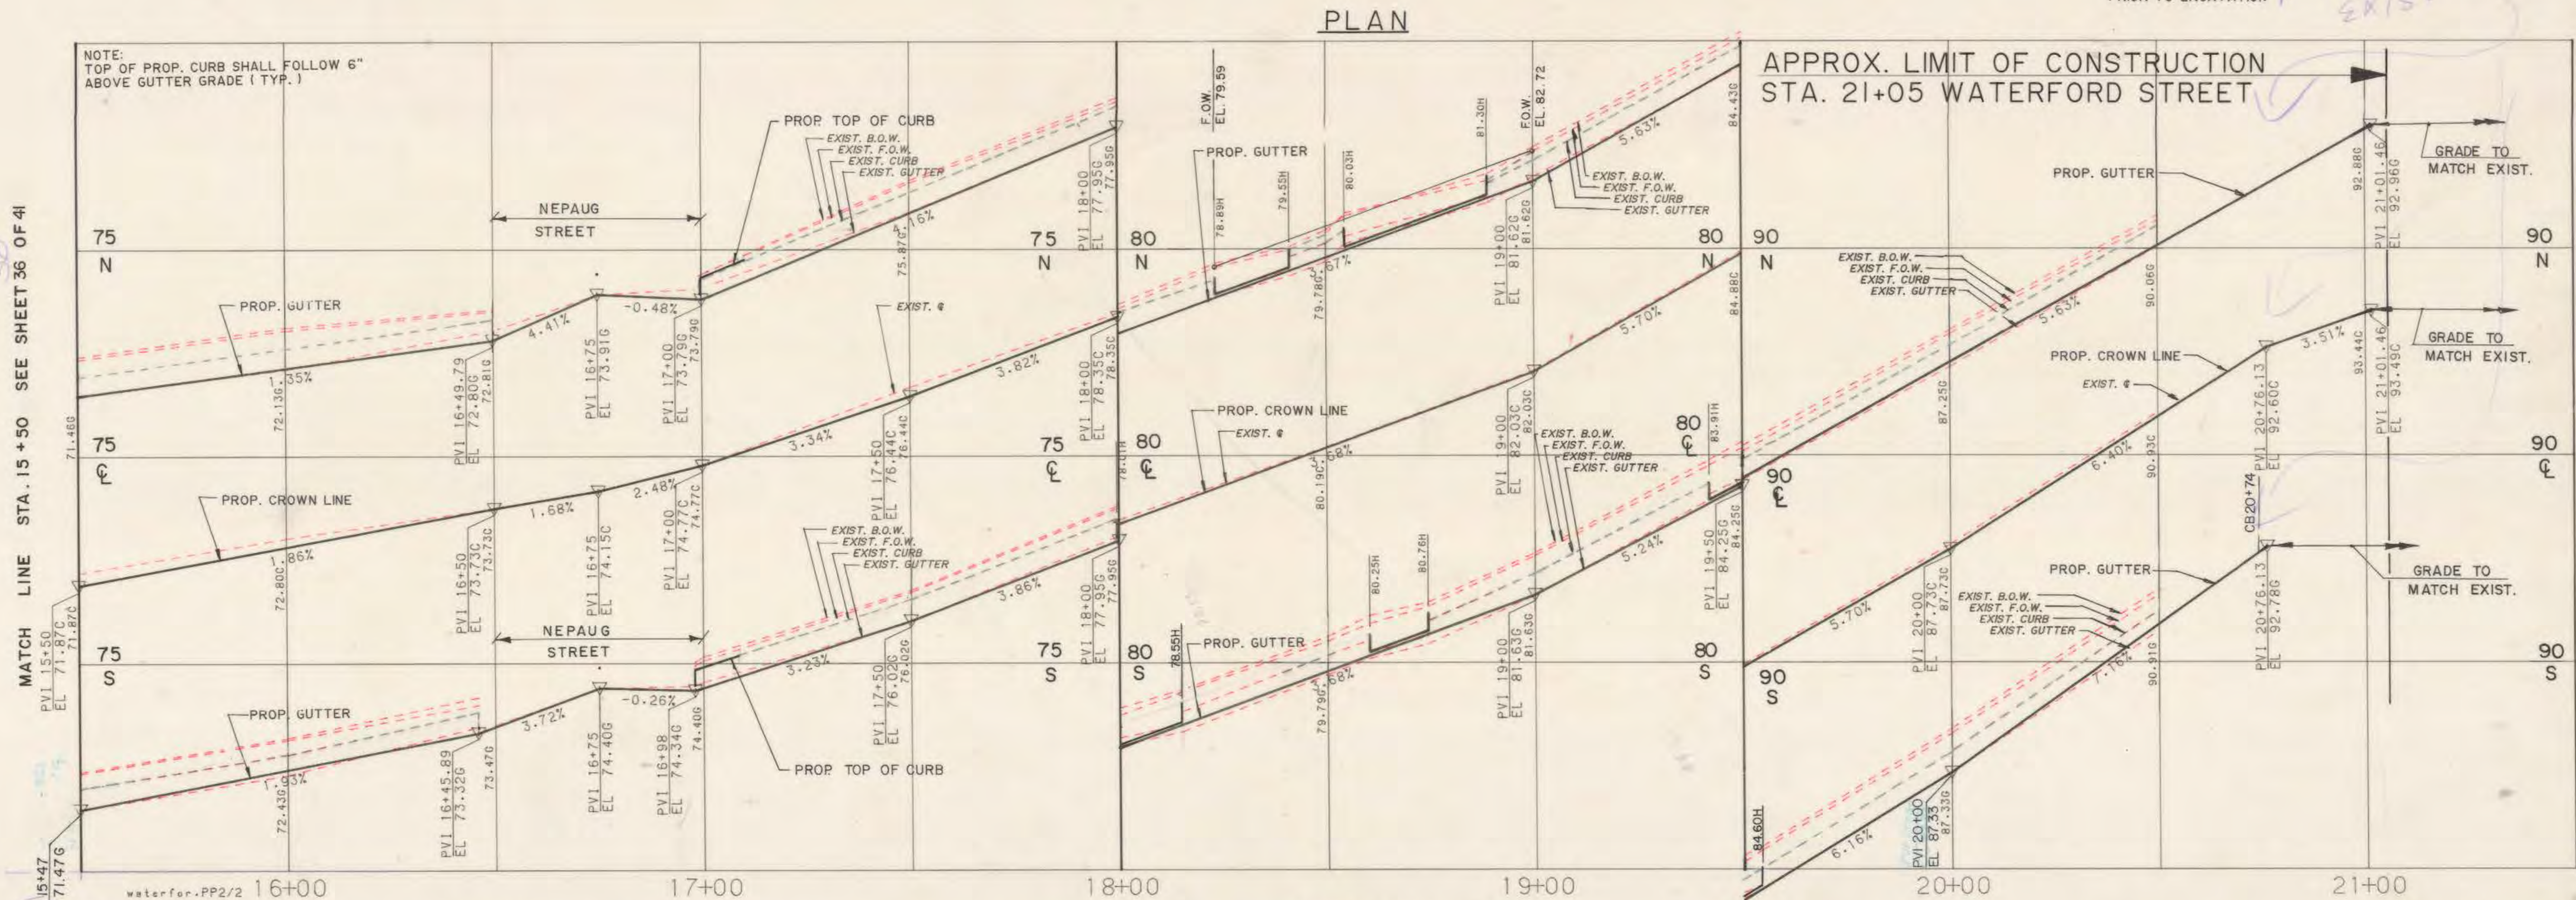

			SUPV.	JAC
			DESIGN	MDH/AEC
			DRAWN	JRM
			CHECKED	AEC
NO.	DATE	DESCRIPTION	DATE	02-12-86
REVISIONS				

GRAPHIC SCALES
HORIZ. 1"=20'
VERT. 1"=2'

ROADWAY RECONSTRUCTION
HARTFORD, CONNECTICUT

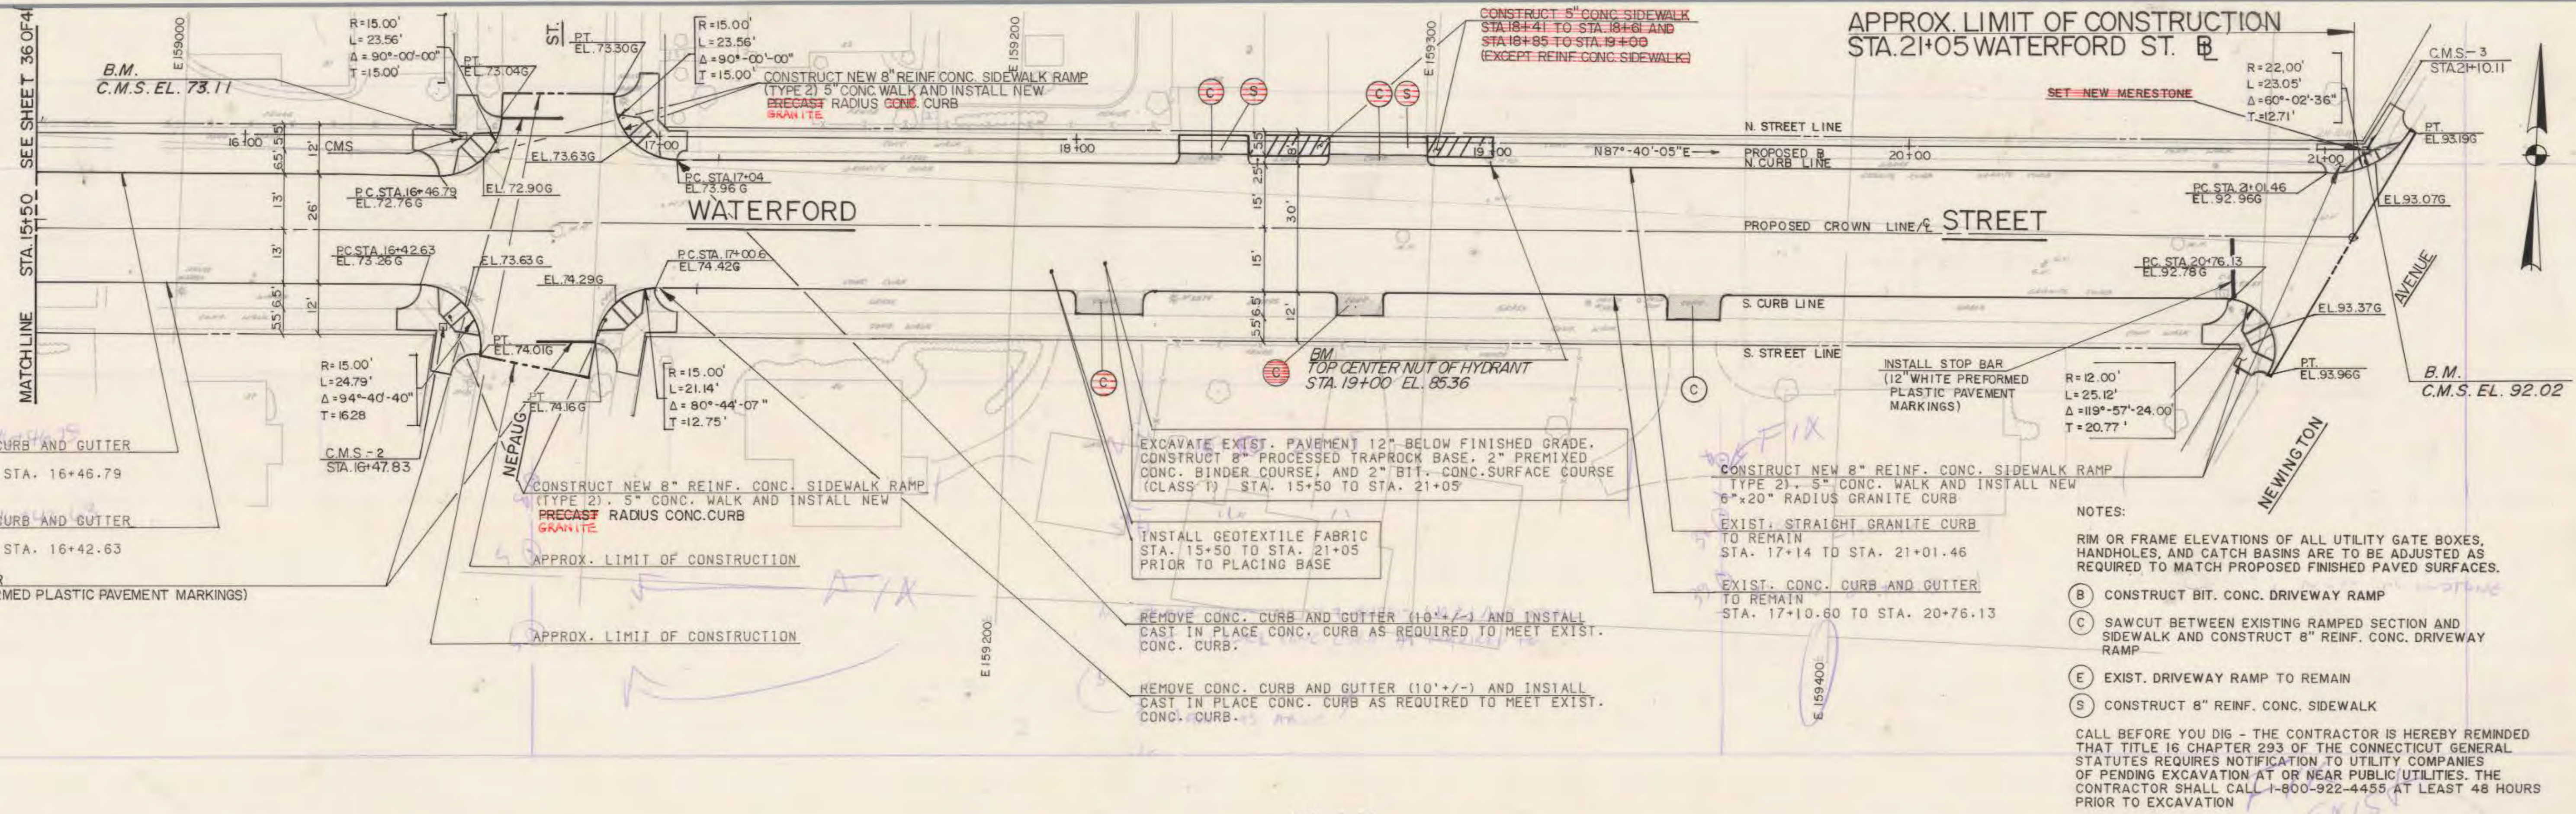

Hayden | Wegman
Consulting Engineers

WEST HARTFORD
NEW YORK • BOSTON • BUFFALO
ATLANTA • MEMPHIS

CITY OF HARTFORD, CONNECTICUT
DEPARTMENT OF PUBLIC WORKS
BUREAU OF ENGINEERING SERVICES

DAYBOOK NO. 011005
DATE

WATERFORD STREET
STA. 15+50 TO STA. 21+05

PLAN AND PROFILE

Contract No. E86-2 Job No. - 852534

SHEET 37
OF 41