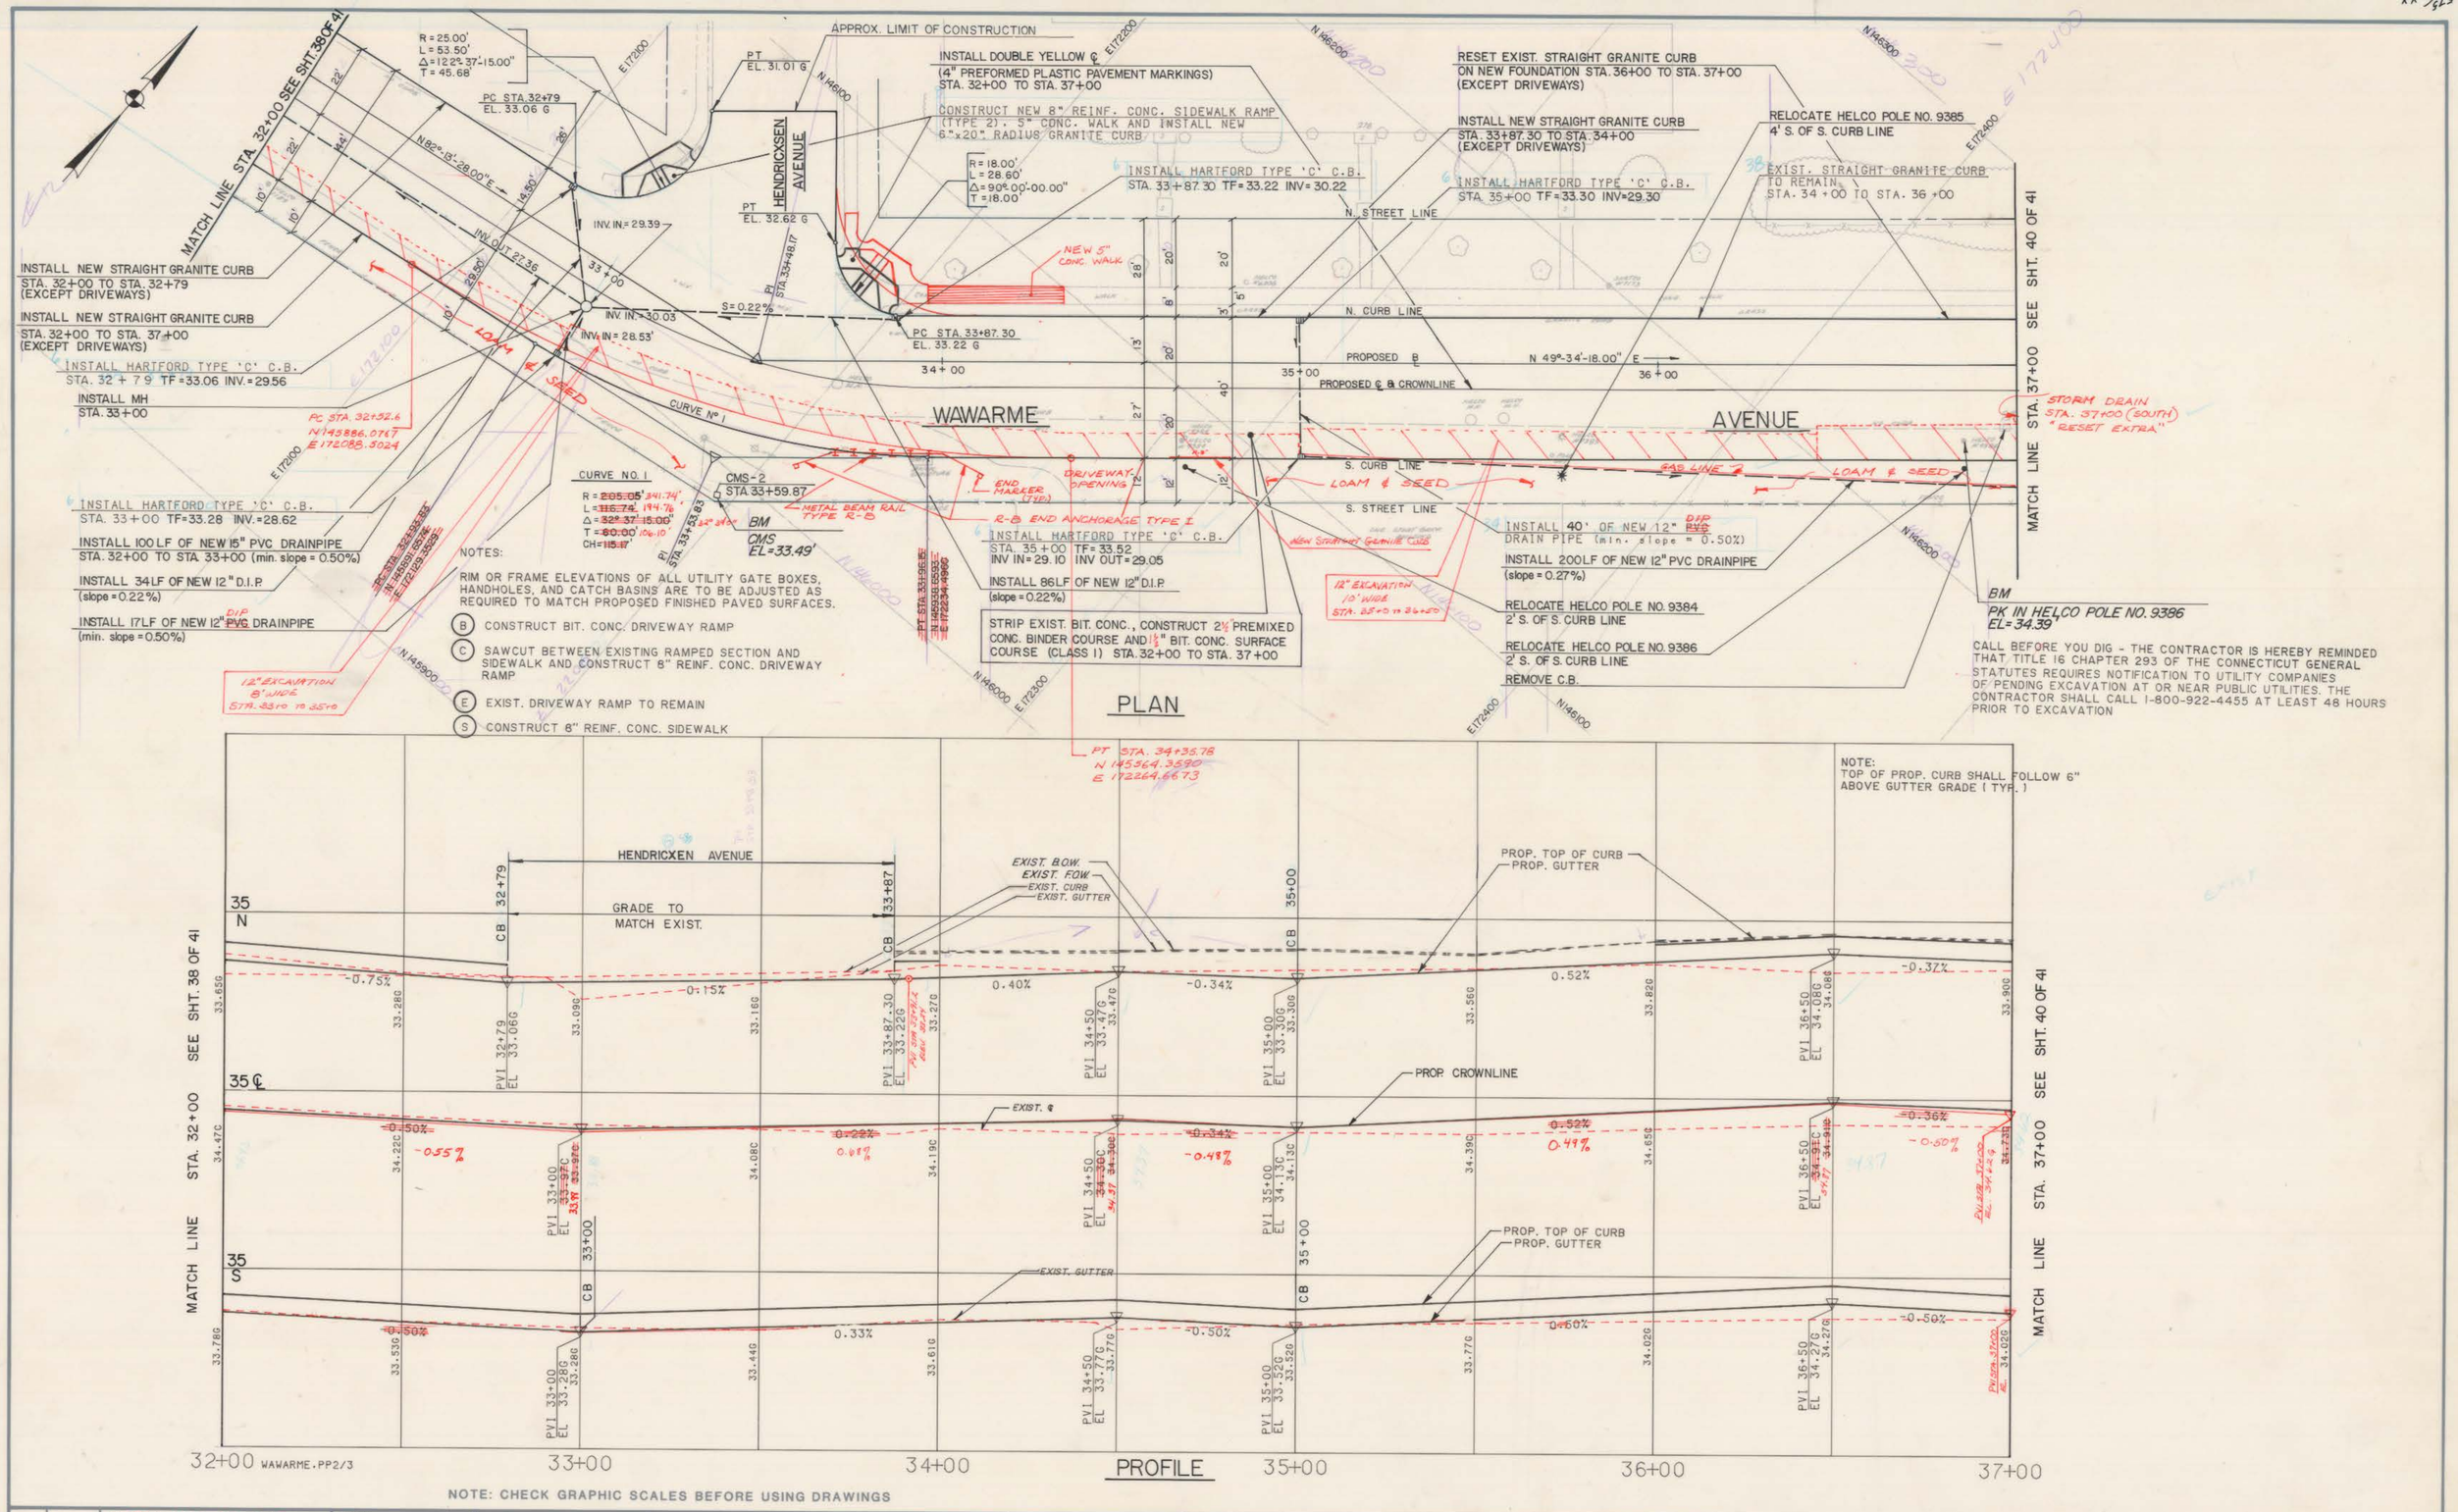

NOTE: CHECK GRAPHIC SCALES BEFORE USING DRAWINGS

NO.	DATE	DESCRIPTION
		NOTE: SOLID RED LINE INDICATES AS-BUILT PROFILE
1	1-26-87 / 1/23/87	CHECKED BY MDH / AS BUILT • DRAFTED BY: MJN

REVISIONS

SUPV.	JAC
DESIGN	MDH/AEC
DRAWN	N.D. Vortin
CHECKED	AEC
DATE	02·28·86

GRAPHIC SCALES
HORIZ. 1" = 20'
VERT. 1" = 2'

ROADWAY RECONSTRUCTION
HARTFORD, CONNECTICUT

STATE OF CONNECTICUT · ALAN R. WEGMAN · NO. 10606 · REGISTERED PROFESSIONAL ENGINEER

Hayden | Wegman
Consulting Engineers
WEST HARTFORD
NEW YORK • BOSTON • BUFFALO
ATLANTA • MEMPHIS

CITY OF HARTFORD, CONNECTICUT
DEPARTMENT OF PUBLIC WORKS
BUREAU OF ENGINEERING SERVICES

DAYBOOK NO. 011005
DATE

WAWARME AVENUE
STA. 32+00 TO STA. 37+00

PLAN AND PROFILE
Contract No. E-86-2 Job No.- 852534

SHEET 39 OF 41

575/4 XX