

22 1/2 625

EXIST. STRAIGHT GRANITE CURB
TO REMAIN STA. 37+00 TO STA. 38+00
RESET STRAIGHT GRANITE CURB ON NEW
FOUNDATION STA. 38+00 TO STA. 38+74.60
(EXCEPT DRIVEWAYS)

CONSTRUCT NEW 8" REINF. CONC. SIDEWALK RAMP
(TYPE 2), 5" CONC. WALK AND RESET RADIUS
GRANITE CURB
APPROX. LIMIT OF CONSTRUCTION

INSTALL MBR ANCHORAGE
TYPE I (23'-6")

REMOVE GUIDE RAIL
INSTALL NEW RADIUS GRANITE CURB

PI STA. 40+85.65 =
0+00 (SOUTH)
N146406.99
E172740.51

(TOTAL) CURVE NO. 2
R=120.00'
L=123.52'
Δ=58°-58'-32"
T=67.86'
CH=118.14'

PC STA. 41+12.29
PT STA. 41+12.29
N146406.99
E172740.51

RESET EXIST. STRAIGHT GRANITE
CURB ON NEW FOUNDATION
(EXCEPT DRIVEWAYS) STA. 39+52.60
TO STA. 41+12.29

RELOCATE SIGN

INSTALL METAL BEAM RAIL
(TYPE R-B) W 6 X 8.5 POSTS
6'-3" SPACING SEE METAL BEAM RAIL
DETAIL AND PLAN VIEW SHEET.

NOTES:

RIM OR FRAME ELEVATIONS OF ALL UTILITY GATE BOXES,
HANDHOLES, AND CATCH BASINS ARE TO BE ADJUSTED AS
REQUIRED TO MATCH PROPOSED FINISHED PAVED SURFACES.

- (B) CONSTRUCT BIT. CONC. DRIVEWAY RAMP
- (C) SAWCUT BETWEEN EXISTING RAMPED SECTION AND
SIDEWALK AND CONSTRUCT 8" REINF. CONC. DRIVEWAY
RAMP
- (E) EXIST. DRIVEWAY RAMP TO REMAIN
- (S) CONSTRUCT 8" REINF. CONC. SIDEWALK

CALL BEFORE YOU DIG - THE CONTRACTOR IS HEREBY REMINDED
THAT TITLE 16 CHAPTER 293 OF THE CONNECTICUT GENERAL
STATUTES REQUIRES NOTIFICATION TO UTILITY COMPANIES
OF PENDING EXCAVATION AT OR NEAR PUBLIC UTILITIES. THE
CONTRACTOR SHALL CALL 1-800-922-4455 AT LEAST 48 HOURS
PRIOR TO EXCAVATION.


STRIP EXIST. BIT. CONC., CONSTRUCT 2" PREMIXED
CONC. BINDER COURSE AND 2" BIT. CONC. SUR-
FACE COURSE (CLASS 1) STA. 37+00 TO STA. 41+50

INSTALL DOUBLE YELLOW C (4" PREFORMED PLASTIC
PAVEMENT MARKINGS) STA. 37+00 TO STA. 40+85.65 (=0+00 S.)

INSTALL 64' OF NEW 12" PVC DRAINPIPE
(min slope = 0.50%)

INSTALL 38' OF NEW 12" PVC DRAINPIPE
(slope = 0.27%)

PLAN

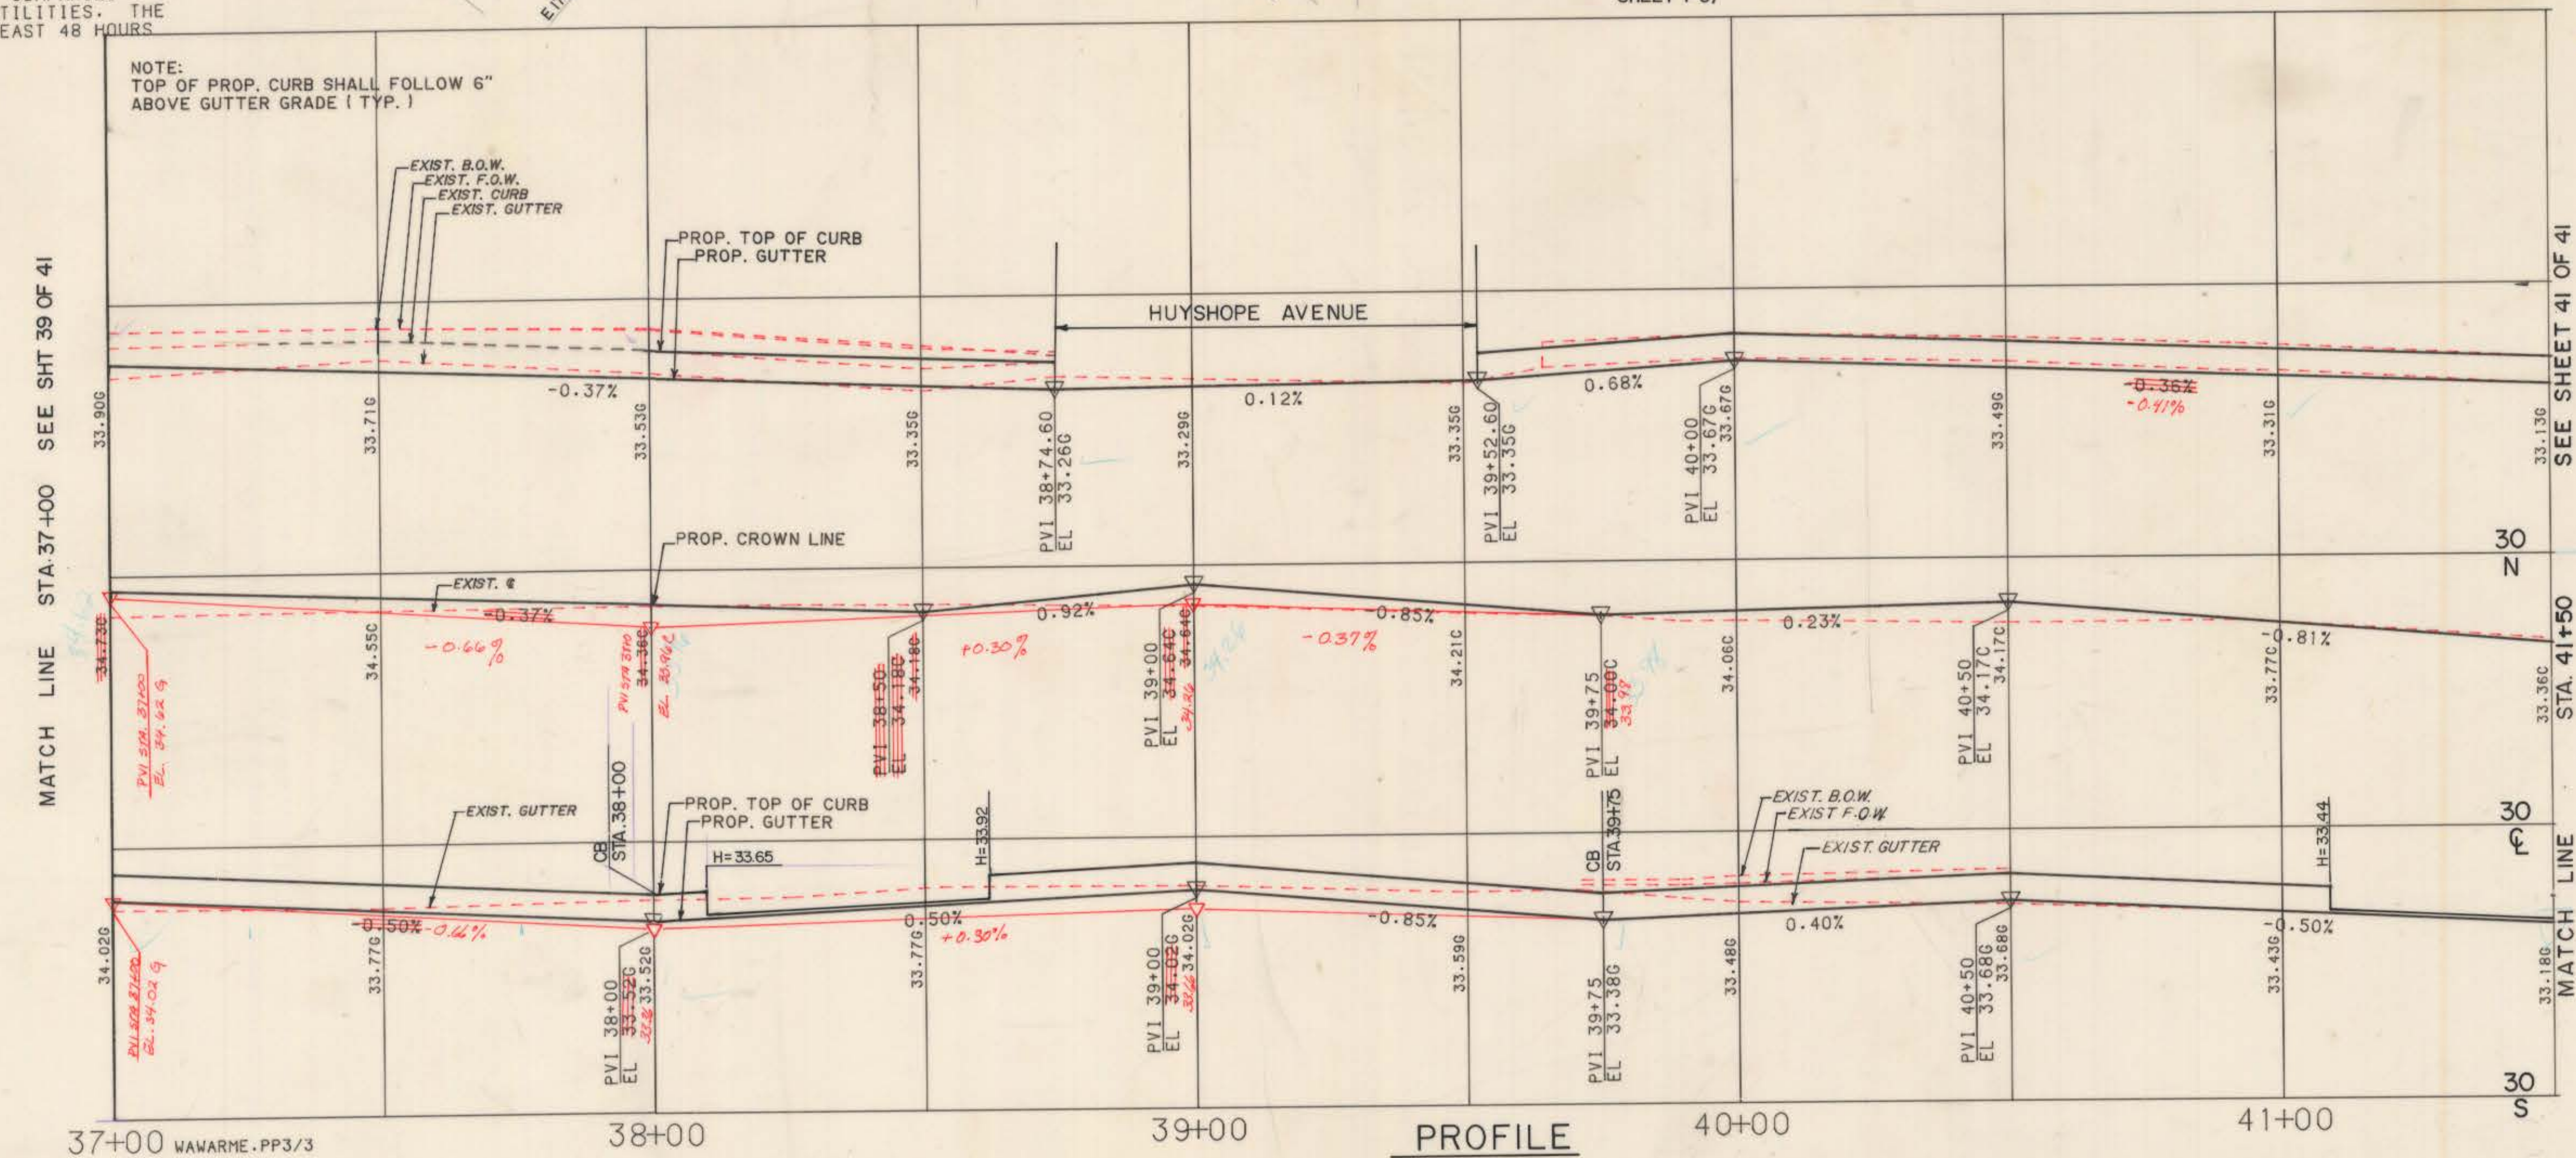

NOTE: CHECK GRAPHIC SCALES BEFORE USING DRAWINGS

REVISIONS		SUPV. JAC
DESIGN MDH/AEC		GRAPHIC SCALES
DRAWN CSY/KHT		HORIZ. 1"=20'
CHECKED AEC		VERT. 1"=2'
DATE 02.28.86		

ROADWAY RECONSTRUCTION
HARTFORD, CONNECTICUT



Hayden | Wegman
Consulting Engineers
WEST HARTFORD
NEW YORK • BOSTON • BUFFALO
ATLANTA • MEMPHIS

CITY OF HARTFORD, CONNECTICUT
DEPARTMENT OF PUBLIC WORKS
BUREAU OF ENGINEERING SERVICES

DAYBOOK NO. 011005
DATE

WAWARME AVENUE
STA. 37+00 TO STA. 41+50 (NORTH)
STA. 0+00 TO STA. 0+73.50 (SOUTH)

PLAN AND PROFILE
CONTRACT NO.E86-2 Job No.- 852534

SHEET 40
OF 41

575 4 22