575/4 DD

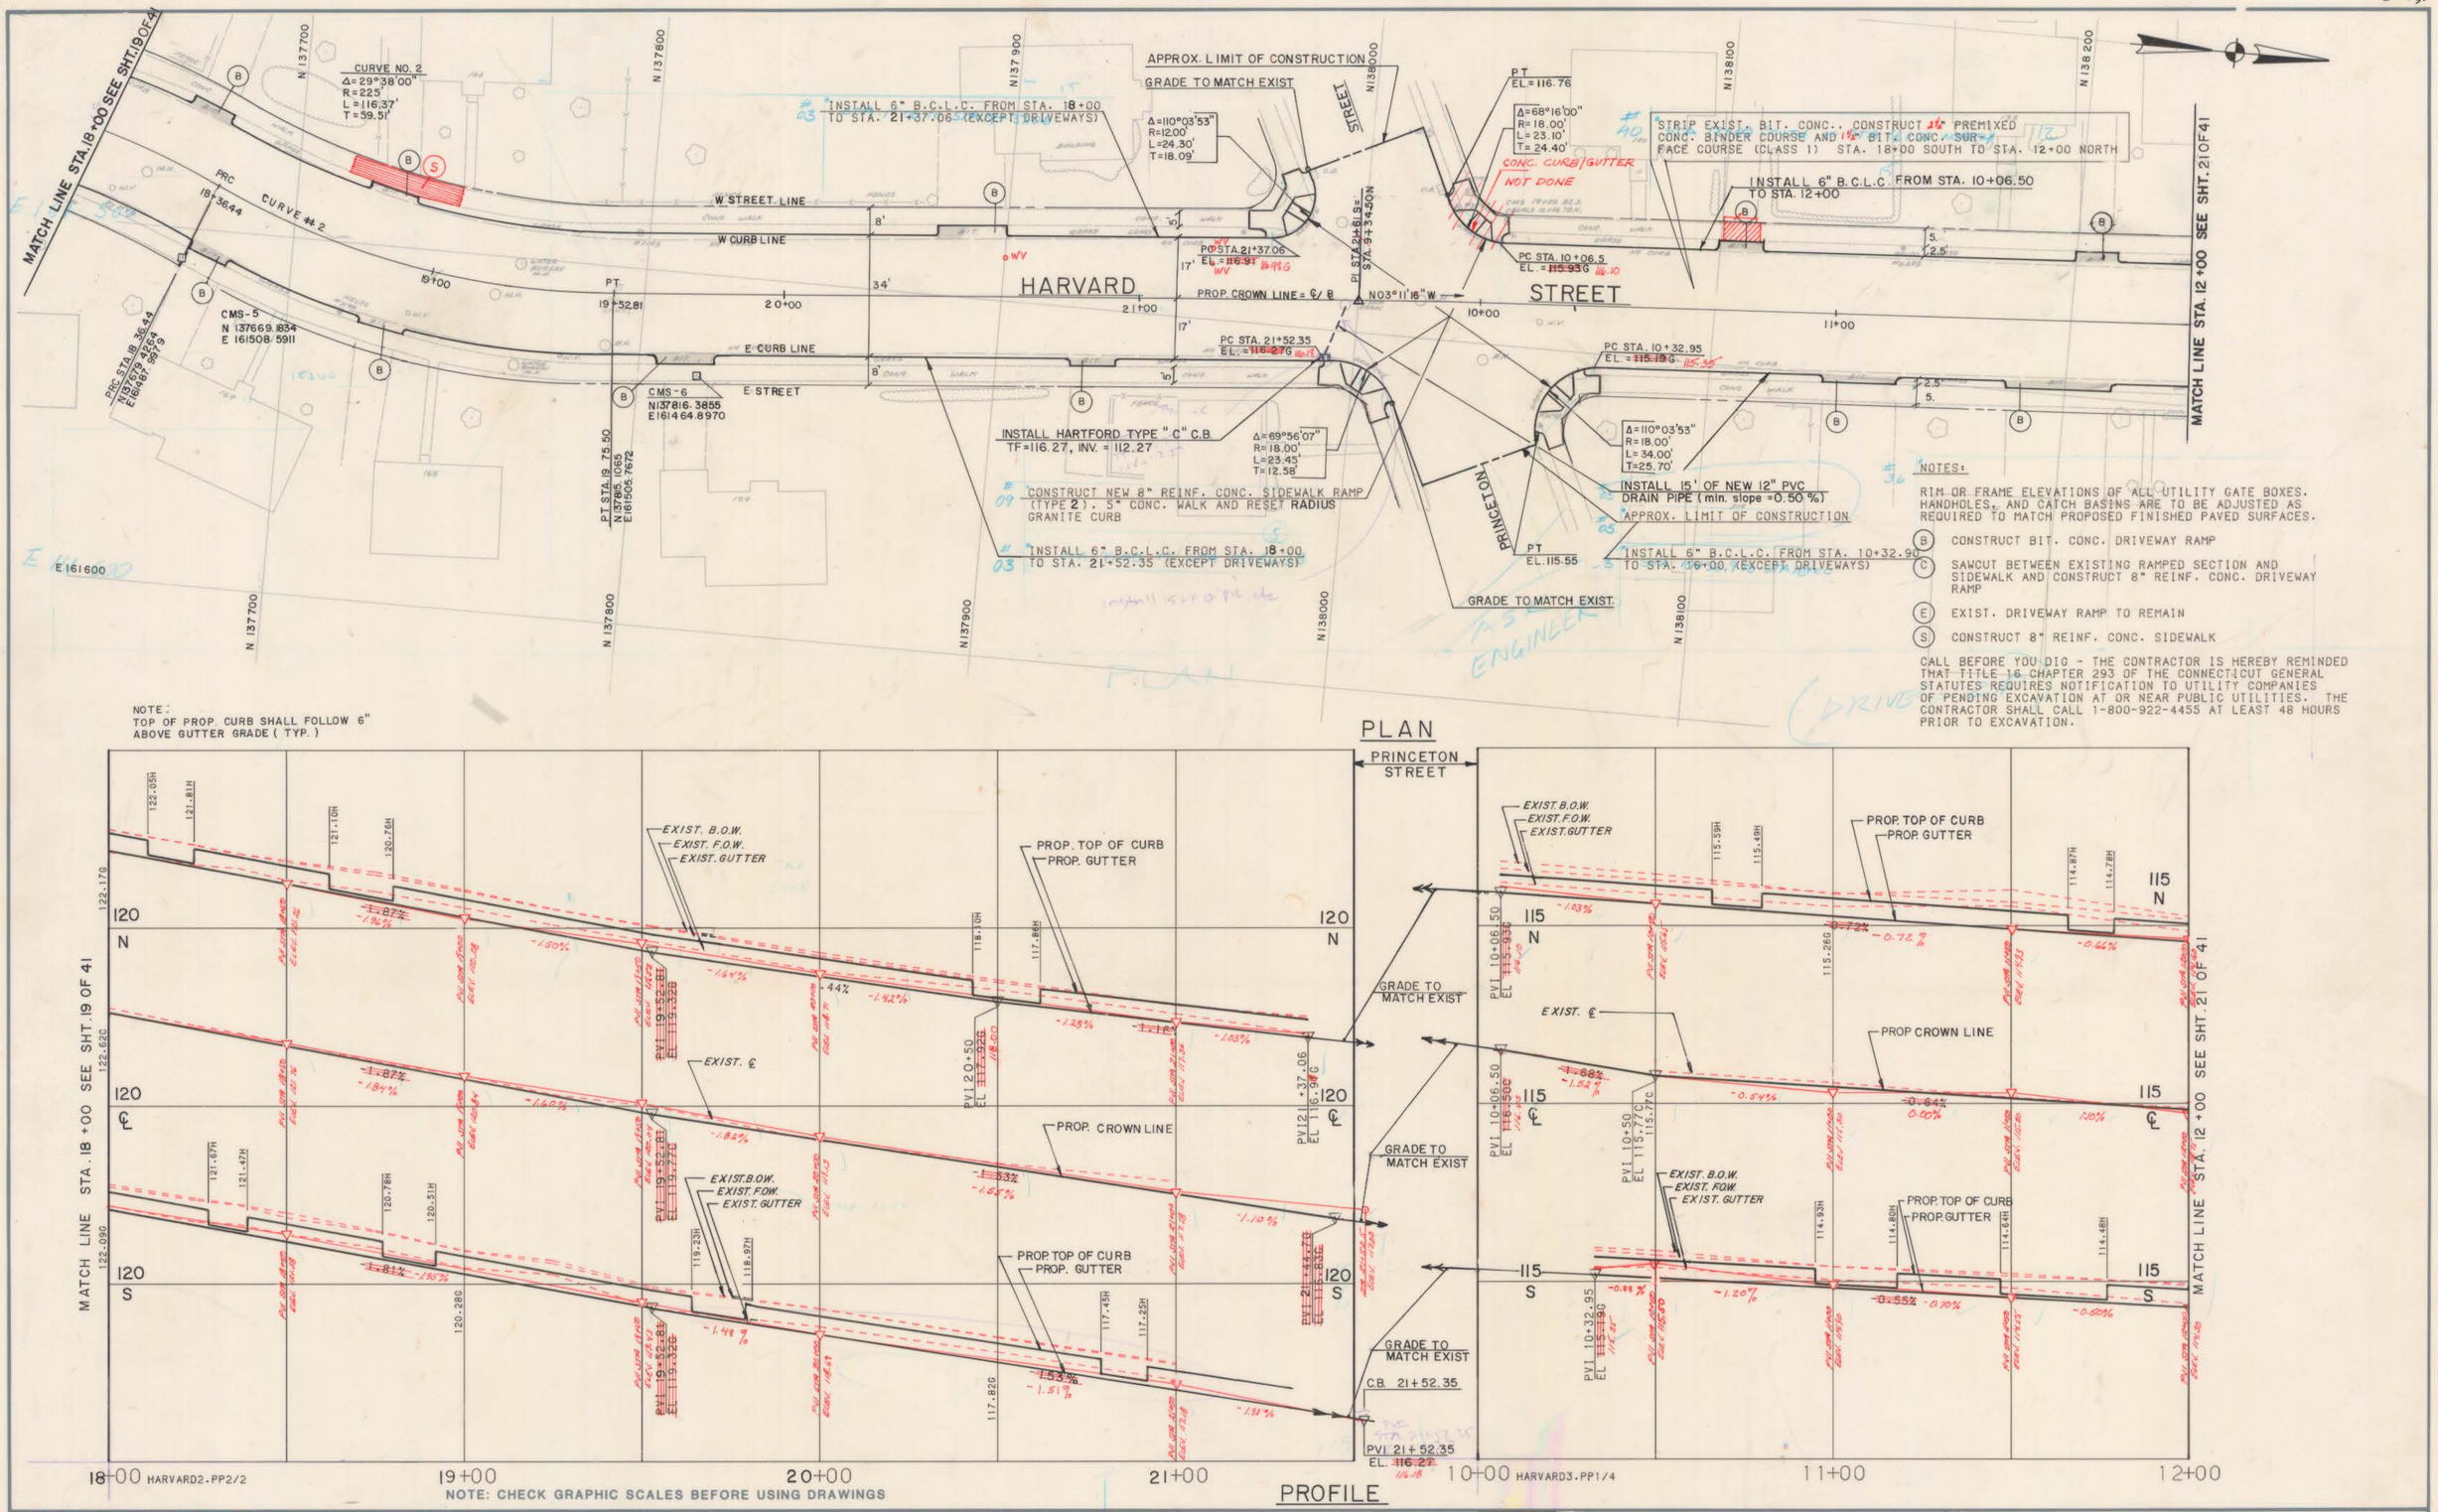

NOTES:

RIM OR FRAME ELEVATIONS OF ALL UTILITY GATE BOXES, HANDHOLES, AND CATCH BASINS ARE TO BE ADJUSTED AS REQUIRED TO MATCH PROPOSED FINISHED PAVED SURFACES.

(B) CONSTRUCT BIT. CONC. DRIVEWAY RAMP

(C) SAWCUT BETWEEN EXISTING RAMPED SECTION AND SIDEWALK AND CONSTRUCT 8" REINF. CONC. DRIVEWAY RAMP

(E) EXIST. DRIVEWAY RAMP TO REMAIN

(S) CONSTRUCT 8" REINF. CONC. SIDEWALK

CALL BEFORE YOU DIG - THE CONTRACTOR IS HEREBY REMINDED THAT TITLE 16 CHAPTER 293 OF THE CONNECTICUT GENERAL STATUTES REQUIRES NOTIFICATION TO UTILITY COMPANIES OF PENDING EXCAVATION AT OR NEAR PUBLIC UTILITIES. THE CONTRACTOR SHALL CALL 1-800-922-4455 AT LEAST 48 HOURS PRIOR TO EXCAVATION.

NOTE:
TOP OF PROP. CURB SHALL FOLLOW 6" ABOVE GUTTER GRADE (TYP.)

PLAN

NOTE: CHECK GRAPHIC SCALES BEFORE USING DRAWINGS

PROFILE

NO.	DATE	DESCRIPTION
2	1/27/87	ADD PLAN NOTES; AS BUILT DRAFTED BY MDH
1		AS BUILT - REP SOLID LINE
		HORIZONTAL AS BUILT BY: MAN
		VERTICAL AS BUILT BY: KJF
		CHECKED BY: MCC
	JAN 87	

REVISIONS

SUPV.	JAC
DESIGN	MDH/AEC
DRAWN	RG
CHECKED	AEC
DATE	02·18·86

GRAPHIC SCALES
HORIZ. 1" = 20'
VERT. 1" = 2'

ROADWAY RECONSTRUCTION
HARTFORD, CONNECTICUT

STATE OF CONNECTICUT — ALAN R. WEGMAN — NO. 10606 — REGISTERED PROFESSIONAL ENGINEER

Hayden | Wegman
Consulting Engineers
WEST HARTFORD
NEW YORK • BOSTON • BUFFALO
ATLANTA • MEMPHIS

CITY OF HARTFORD, CONNECTICUT
DEPARTMENT OF PUBLIC WORKS
BUREAU OF ENGINEERING SERVICES

DAYBOOK NO. 011005
DATE

HARVARD STREET
STA. 18+00 TO STA. 21+61 S
STA. 9+35 TO STA. 12 +00 N

PLAN AND PROFILE

Contract No. E86-2 Job No.- 852534

SHEET 20 OF 41

575/4 DD