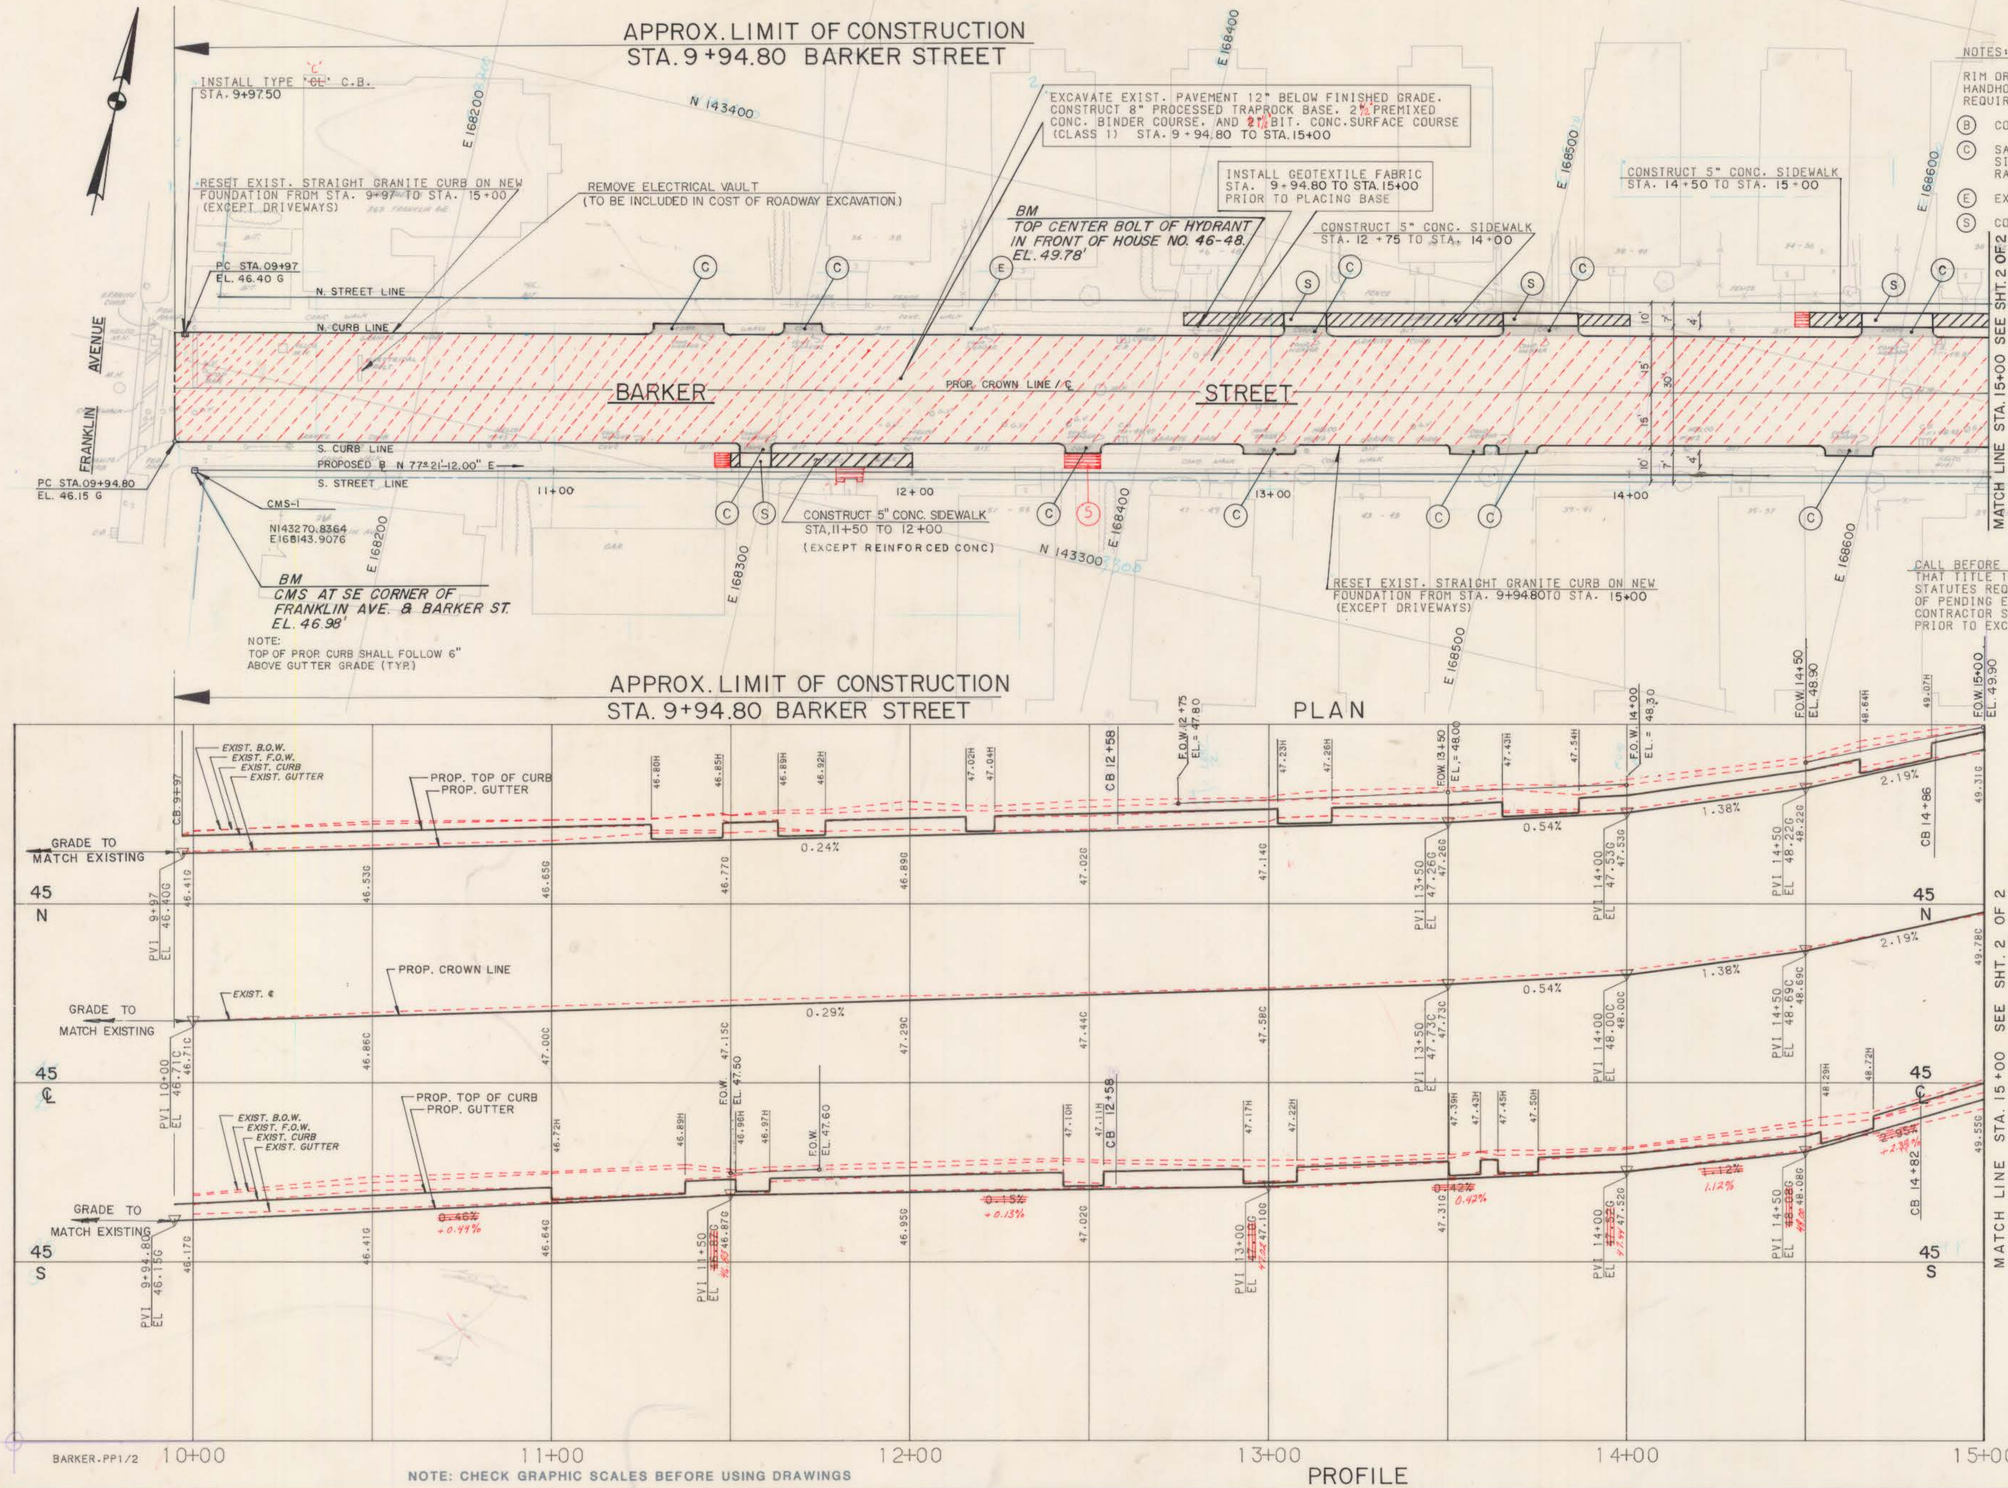

NOTE: CHECK GRAPHIC SCALES BEFORE USING DRAWINGS

NO.	DATE	DESCRIPTION
2	1/21/87	Add Geo-Tex - As Built - Directed by: MJM. AS BUILTS BY RJK CHECKED BY MCL

REVISIONS

SUPV. JAC
DESIGN MDH/AEC
DRAWN N. DeFortin
CHECKED AEC
DATE 02·12·86

GRAPHIC SCALES
HORIZ. 1" = 20'
VERT. 1" = 2'

ROADWAY RECONSTRUCTION
HARTFORD, CONNECTICUT

Hayden | Wegman
Consulting Engineers
WEST HARTFORD
NEW YORK • BOSTON • BUFFALO
ATLANTA • MEMPHIS

CITY OF HARTFORD, CONNECTICUT
DEPARTMENT OF PUBLIC WORKS
BUREAU OF ENGINEERING SERVICES

DAYBOOK NO. 011005
DATE

BARKER STREET
STA. 09 94.80 TO STA. 15+00

PLAN AND PROFILE
Contract No. E86-2 Job No.- 852534

SHEET 1 OF 41