



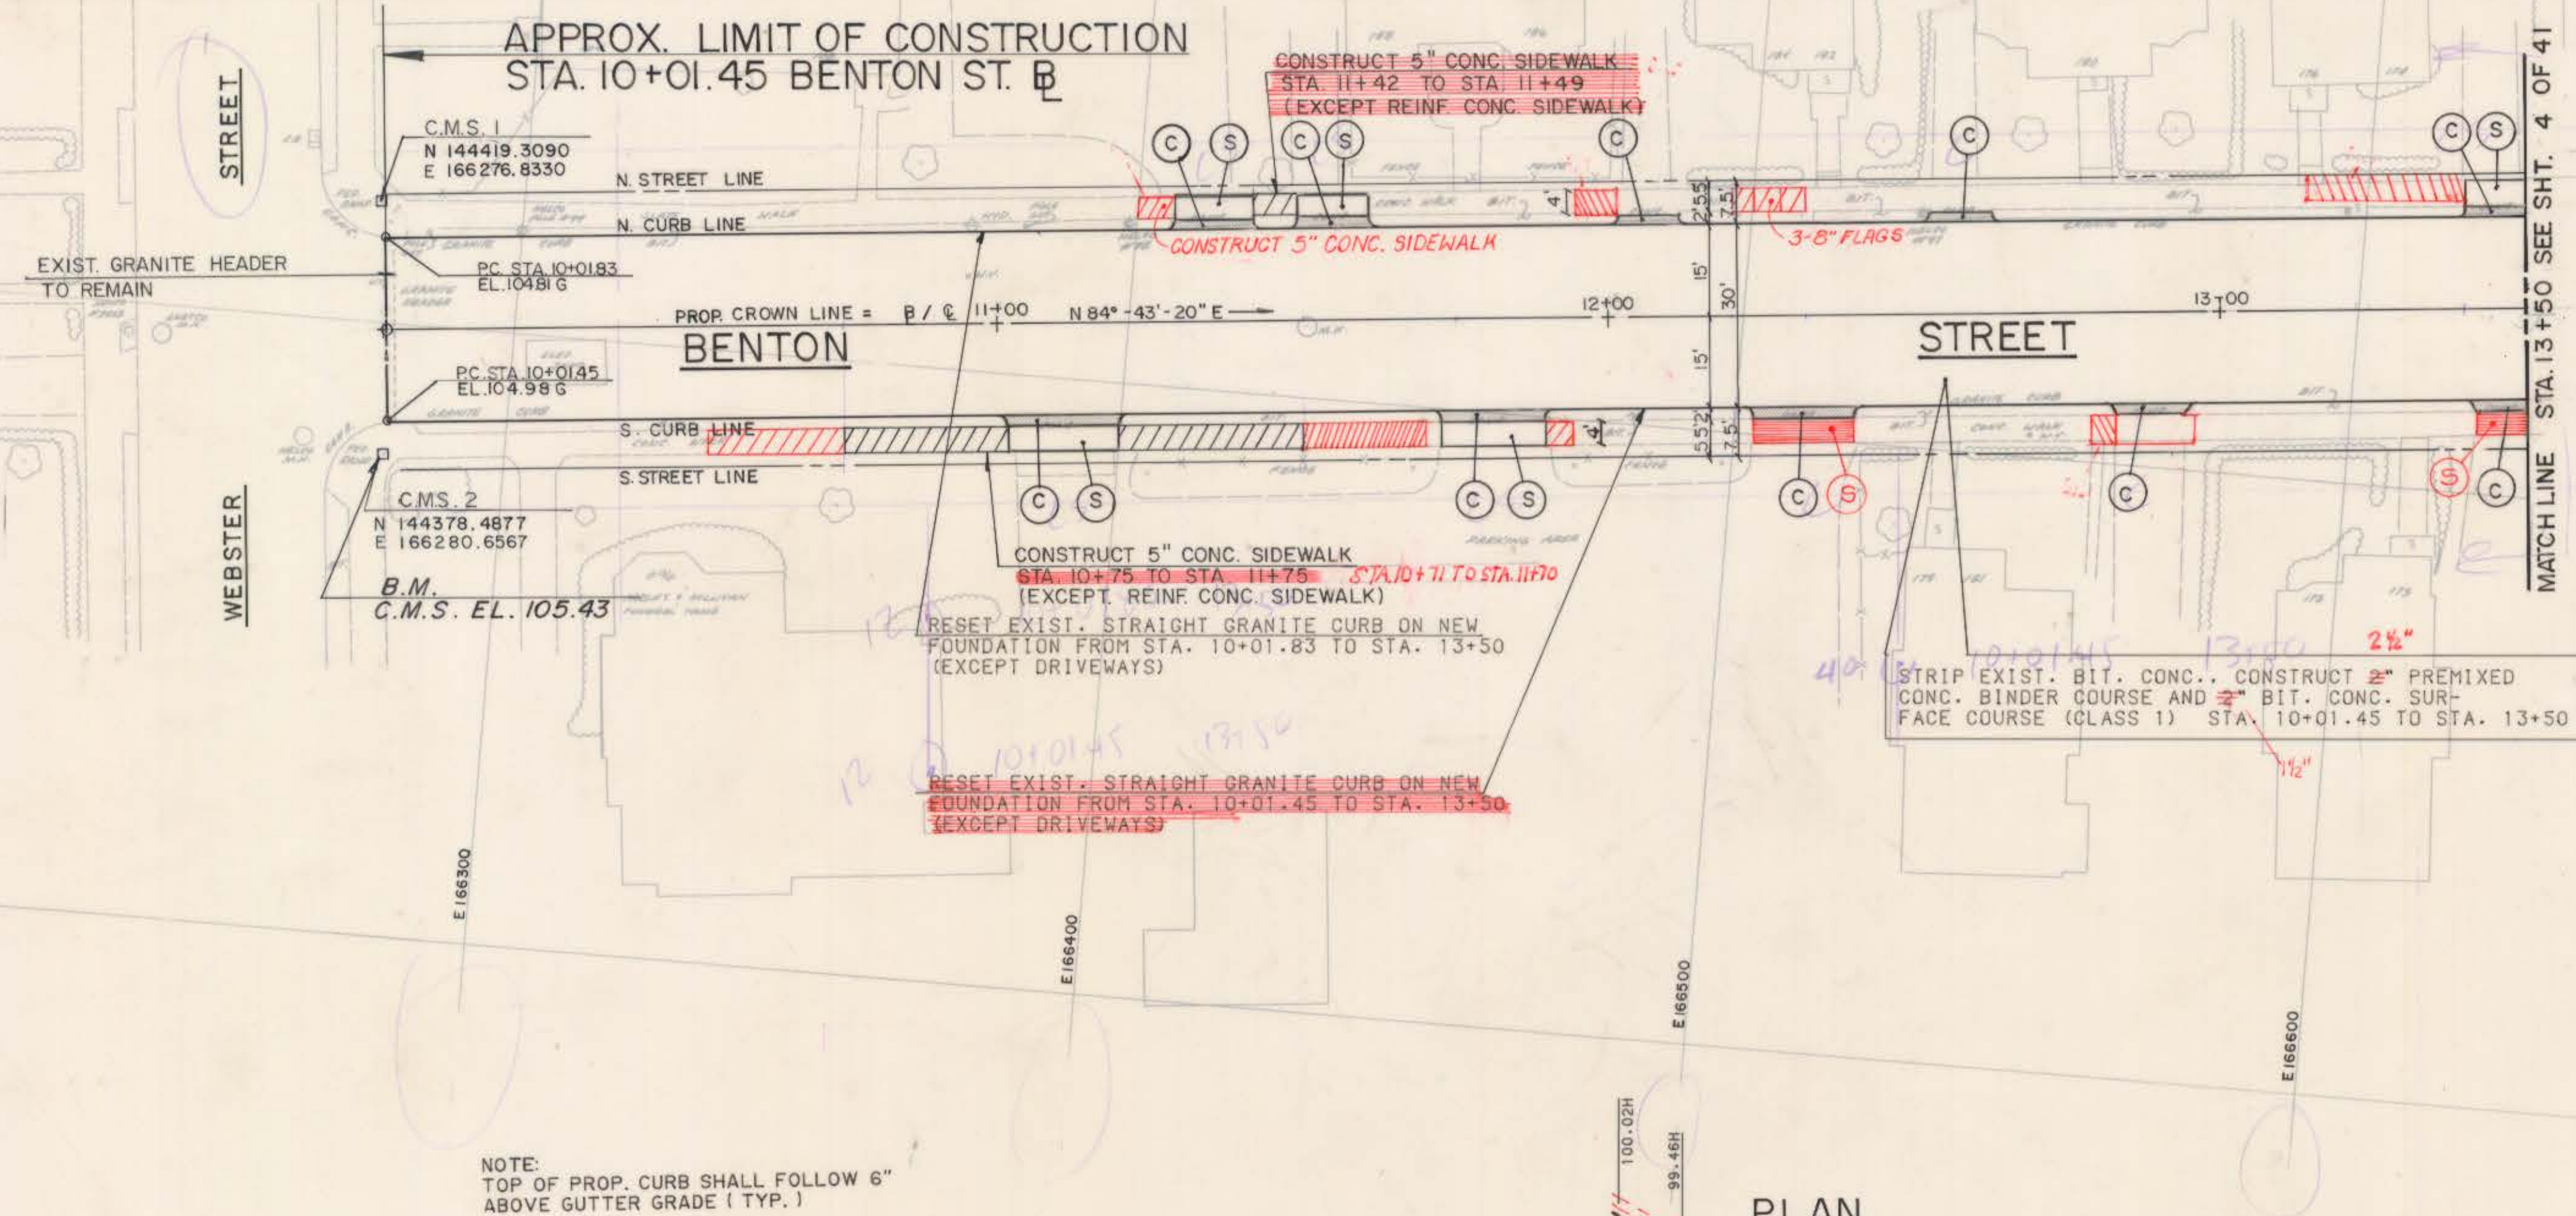

NOTE:
TOP OF PROP. CURB SHALL FOLLOW 6"
ABOVE GUTTER GRADE (TYP.)

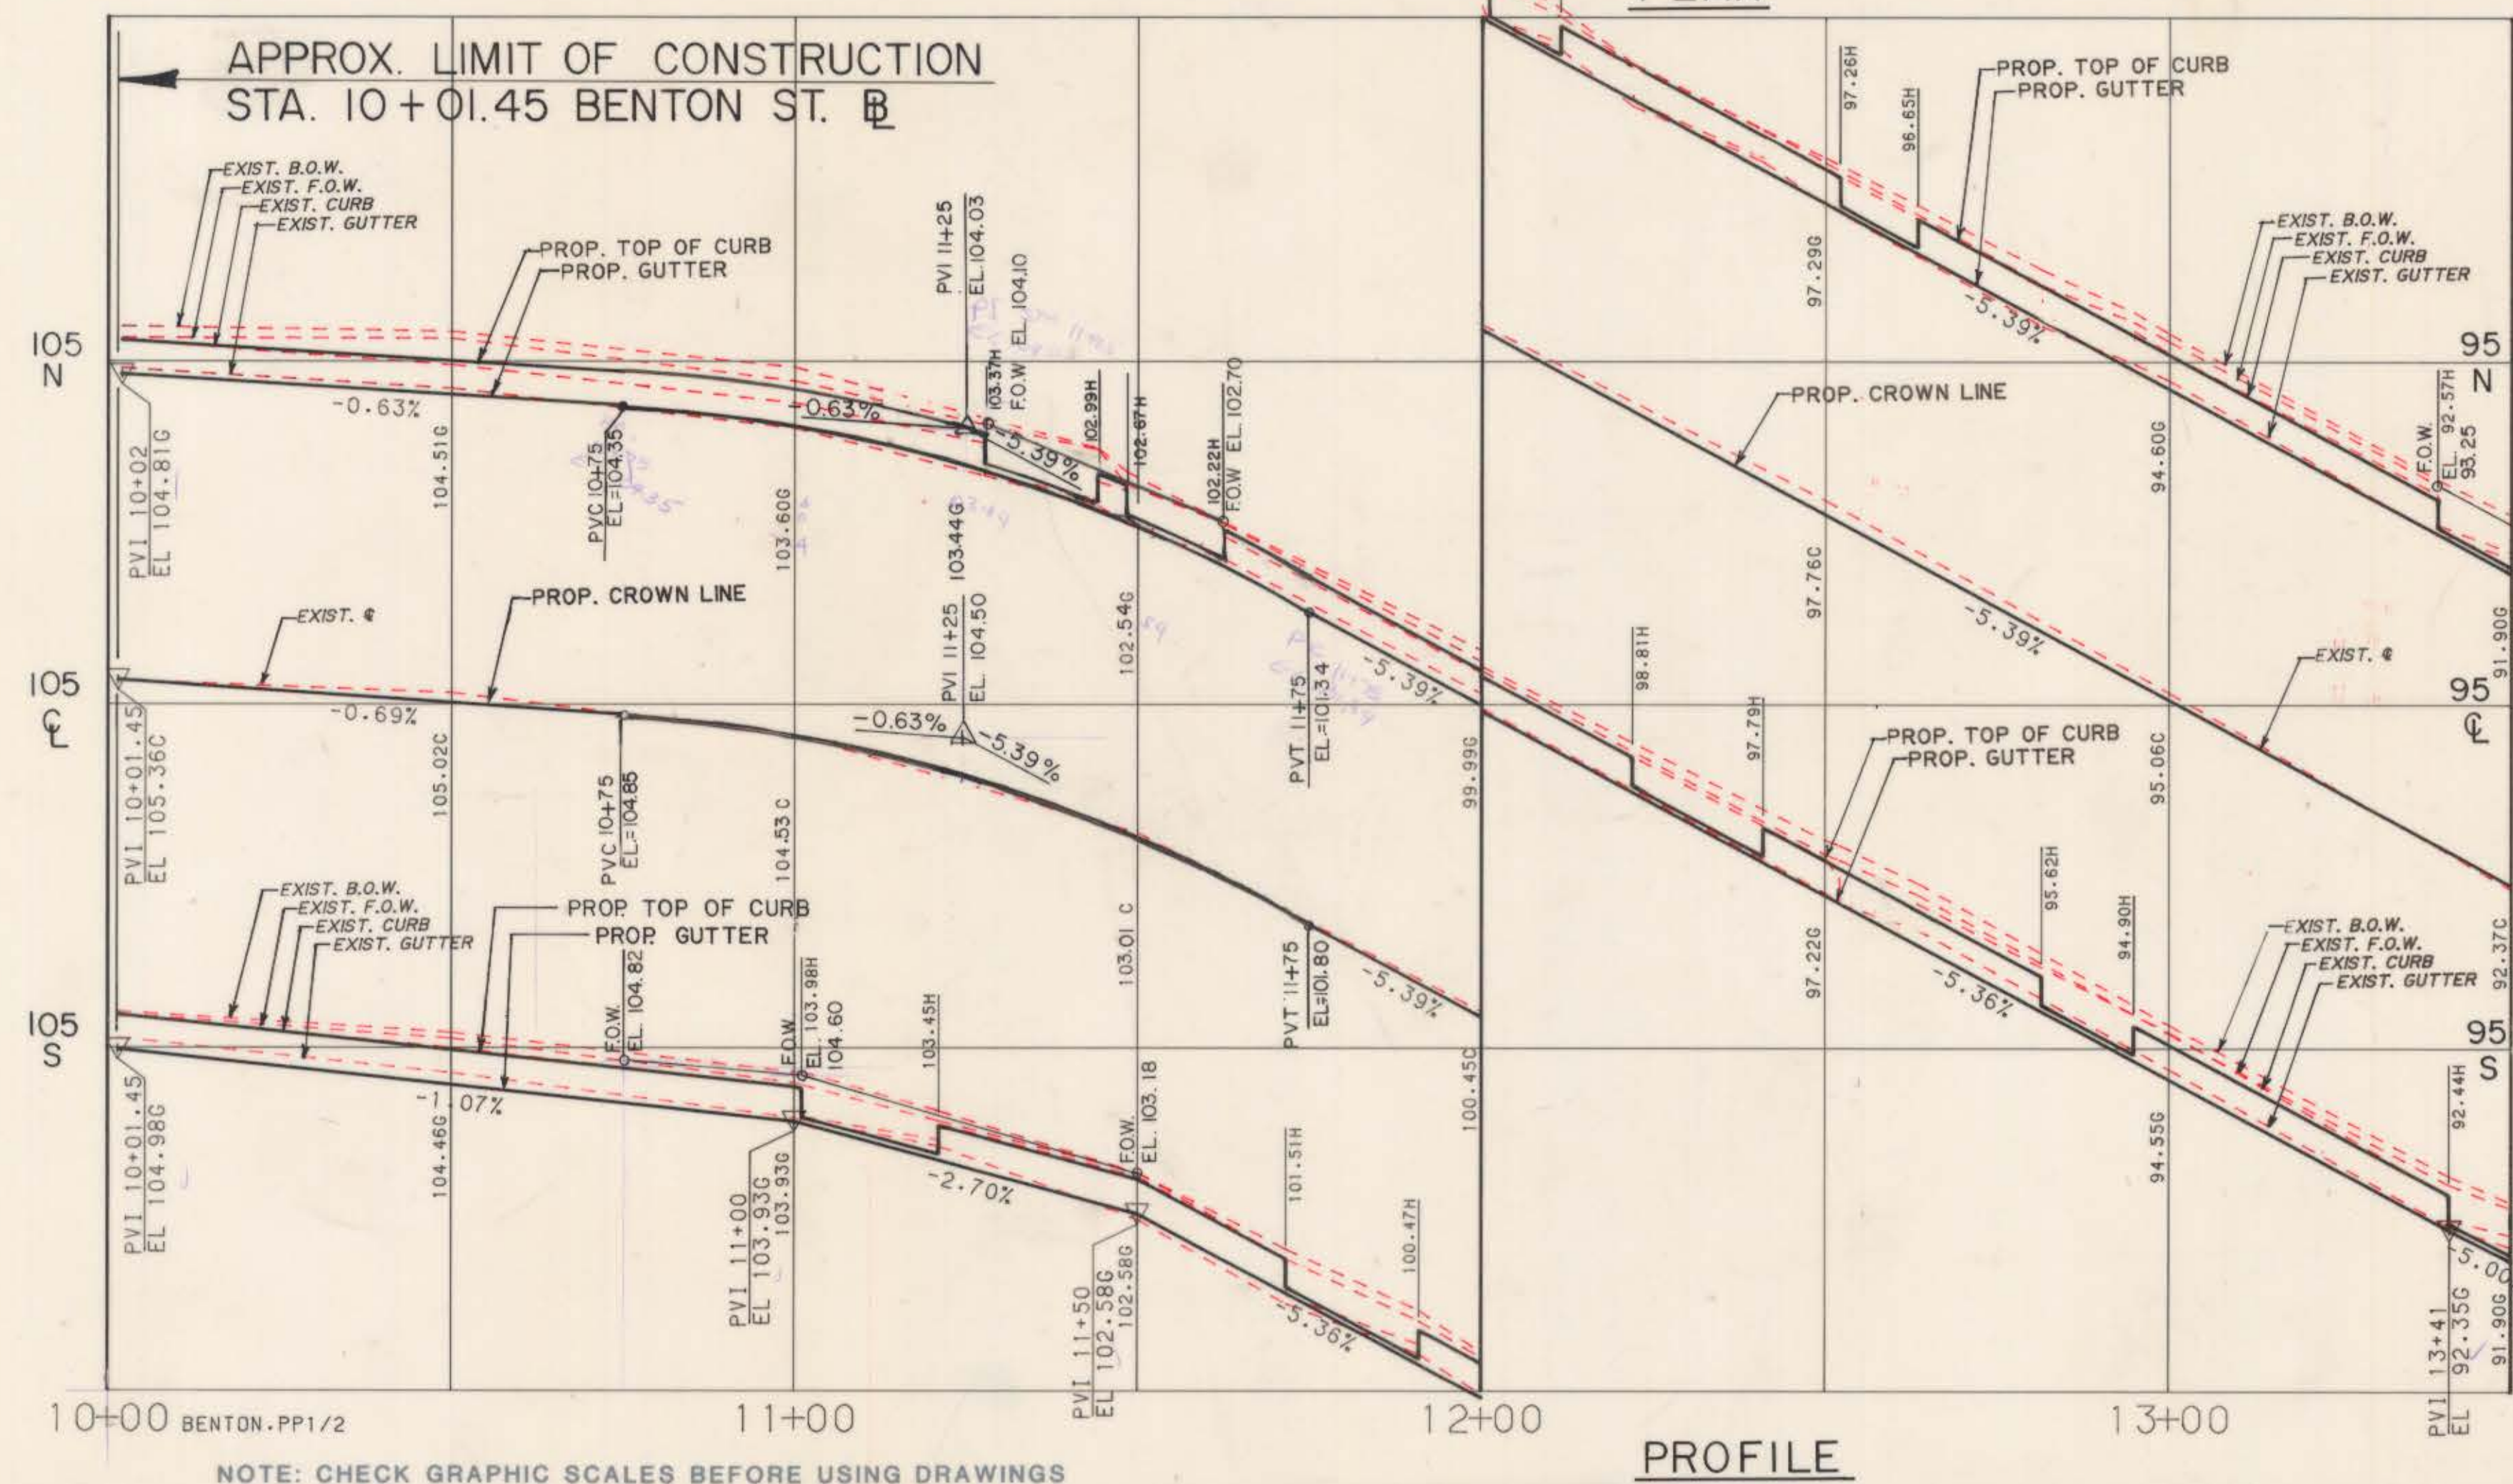

NOTE: CHECK GRAPHIC SCALES BEFORE USING DRAWINGS

			SUPV. JAC	GRAPHIC SCALES	ROADWAY RECONSTRUCTION HARTFORD, CONNECTICUT  Hayden Wegman Consulting Engineers WEST HARTFORD NEW YORK • BOSTON • BUFFALO ATLANTA • MEMPHIS	CITY OF HARTFORD, CONNECTICUT DEPARTMENT OF PUBLIC WORKS BUREAU OF ENGINEERING SERVICES	BENTON STREET STA:10+01.45 TO STA:13 + 50	PLAN AND PROFILE Contract No. E86-2 Job No.- 852534	SHEET 3	
			DESIGN MDH/AEC	HORIZ. 1"=20'						
			DRAWN RG	VERT. 1"=2'						
			CHECKED AEC							
NO.	DATE	JAN 87	DESCRIPTION	REVISIONS						
			DATE	02-15-86					OF 41	