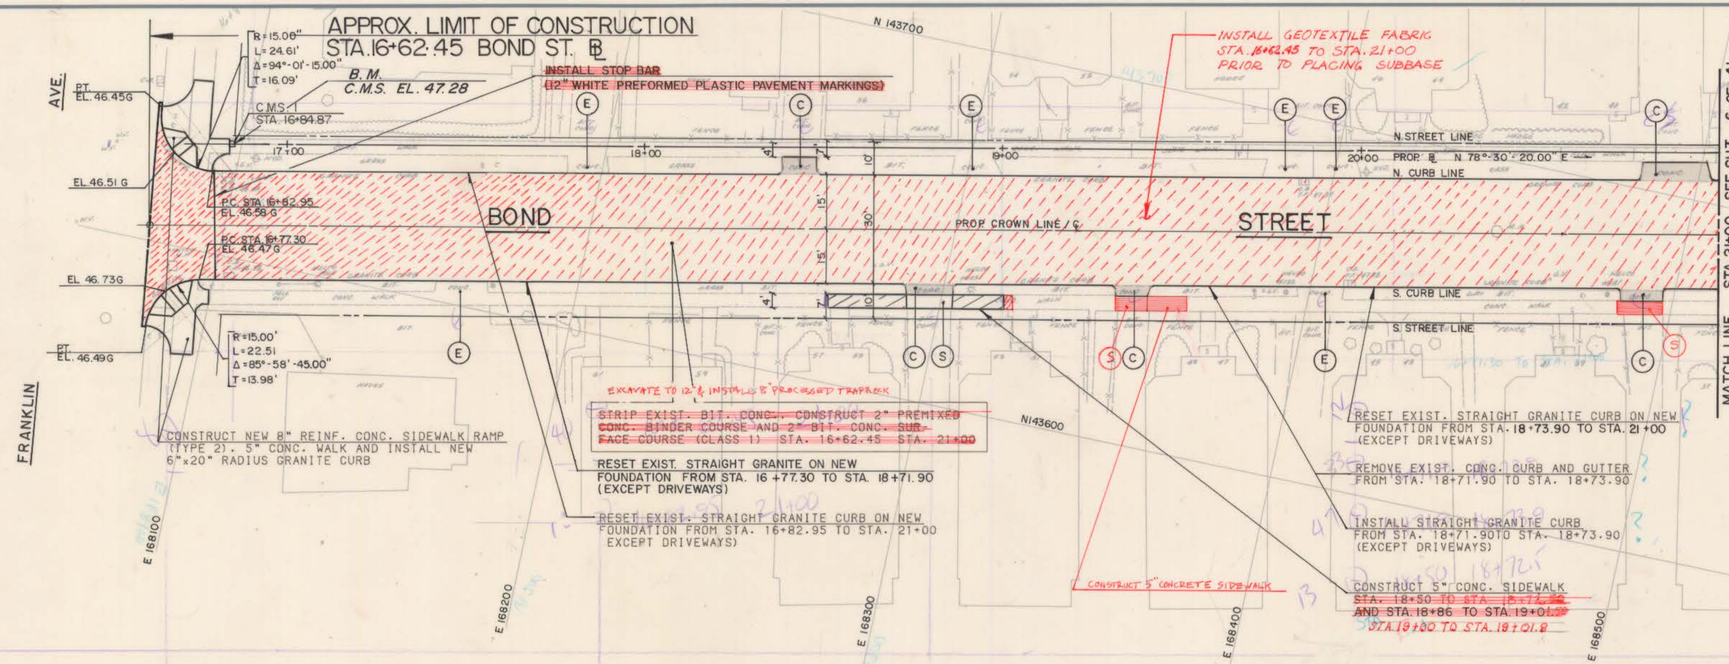

PLAN

NOTES:

RIM OR FRAME ELEVATIONS OF ALL UTILITY GATE BOXES, HANDHOLES, AND CATCH BASINS ARE TO BE ADJUSTED AS REQUIRED TO MATCH PROPOSED FINISHED PAVED SURFACES.

(B) CONSTRUCT BIT. CONC. DRIVEWAY RAMP

(C) SAWCUT BETWEEN EXISTING RAMPED SECTION AND SIDEWALK AND CONSTRUCT 8" REINF. CONC. DRIVEWAY RAMP

(E) EXIST. DRIVEWAY RAMP TO REMAIN

(S) CONSTRUCT 8" REINF. CONC. SIDEWALK

CALL BEFORE YOU DIG - THE CONTRACTOR IS HEREBY REMINDED THAT TITLE 16 CHAPTER 293 OF THE CONNECTICUT GENERAL STATUTES REQUIRES NOTIFICATION TO UTILITY COMPANIES OF PENDING EXCAVATION AT OR NEAR PUBLIC UTILITIES. THE CONTRACTOR SHALL CALL 1-800-922-4455 AT LEAST 48 HOURS PRIOR TO EXCAVATION.

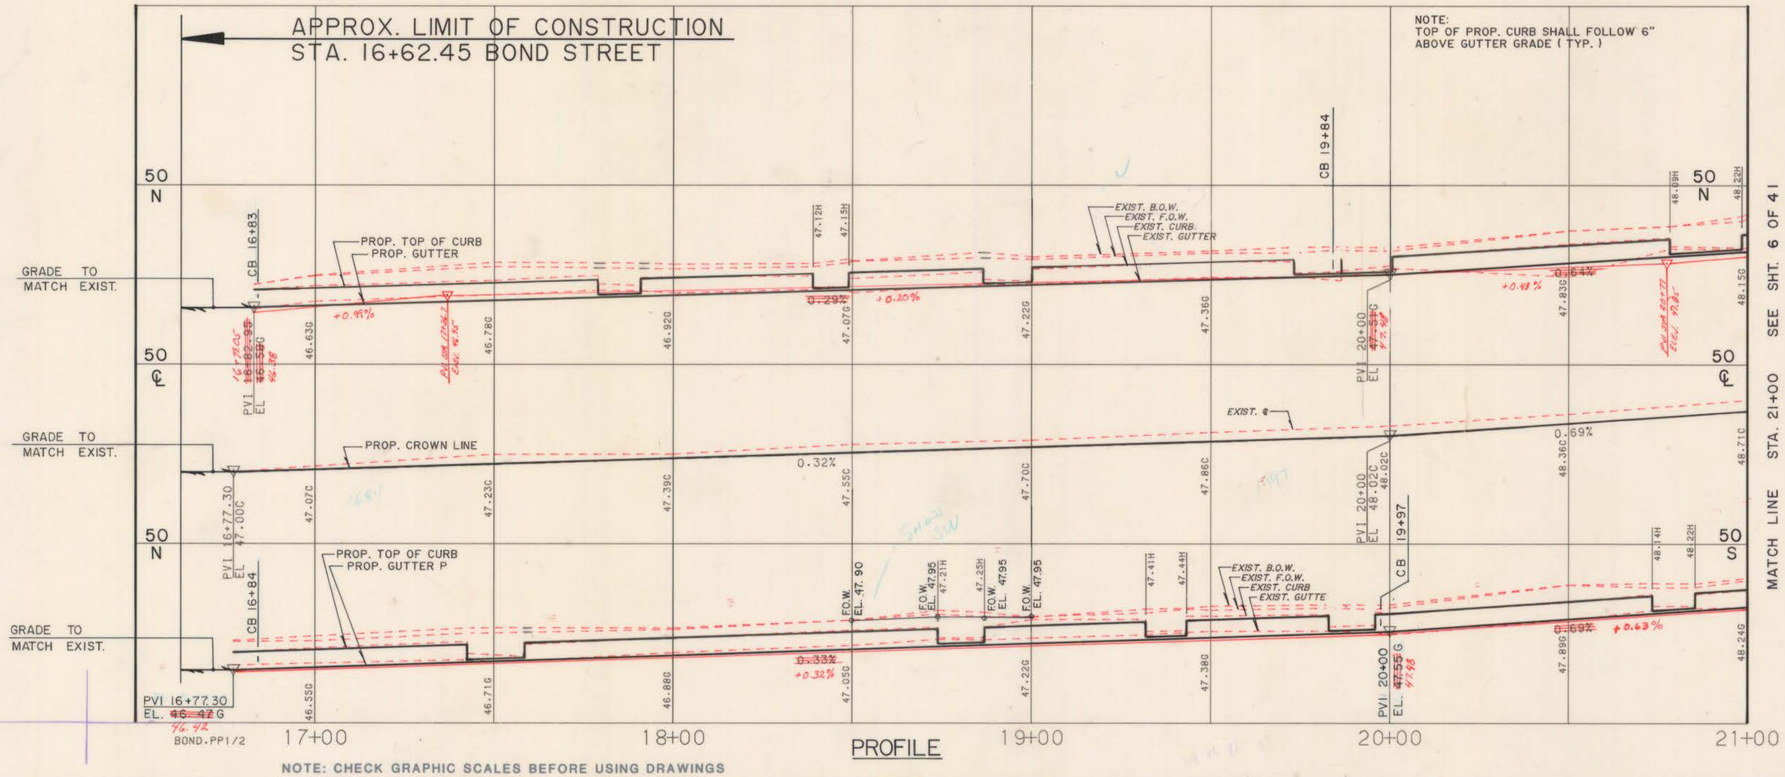

PROFILE

NOTE: CHECK GRAPHIC SCALES BEFORE USING DRAWINGS

NO.	DATE	DESCRIPTION
4	1-20-87	CHECKED BY MDH
3	1/19/87	ADD GRD-TEX & AS BUILT - DRAWN BY MDH
2		AS BUILTS BY RJH
1		CHECKED BY MLC
	JAN 87	

REVISIONS

SUPV. JAC
DESIGN MDH/AEC
DRAWN N.D.FORSTIN
CHECKED AEC
DATE 02 · 14 · 86

GRAPHIC SCALES
HORIZ. 1" = 20'
VERT. 1" = 2'

ROADWAY RECONSTRUCTION
HARTFORD, CONNECTICUT

STATE OF CONNECTICUT ALAN R. WEAKLEY 10606 REGISTERED PROFESSIONAL ENGINEER

Hayden | Wegman
Consulting Engineers
WEST HARTFORD
NEW YORK • BOSTON • BUFFALO
ATLANTA • MEMPHIS

CITY OF HARTFORD, CONNECTICUT
DEPARTMENT OF PUBLIC WORKS
BUREAU OF ENGINEERING SERVICES

DAYBOOK NO. 011005
DATE

BOND STREET
STA. 16+62.45 TO STA. 21+00

PLAN AND PROFILE
Contract No E 86 2 Job No.- 852534

SHEET 5 OF 41

BOND.PP1/2