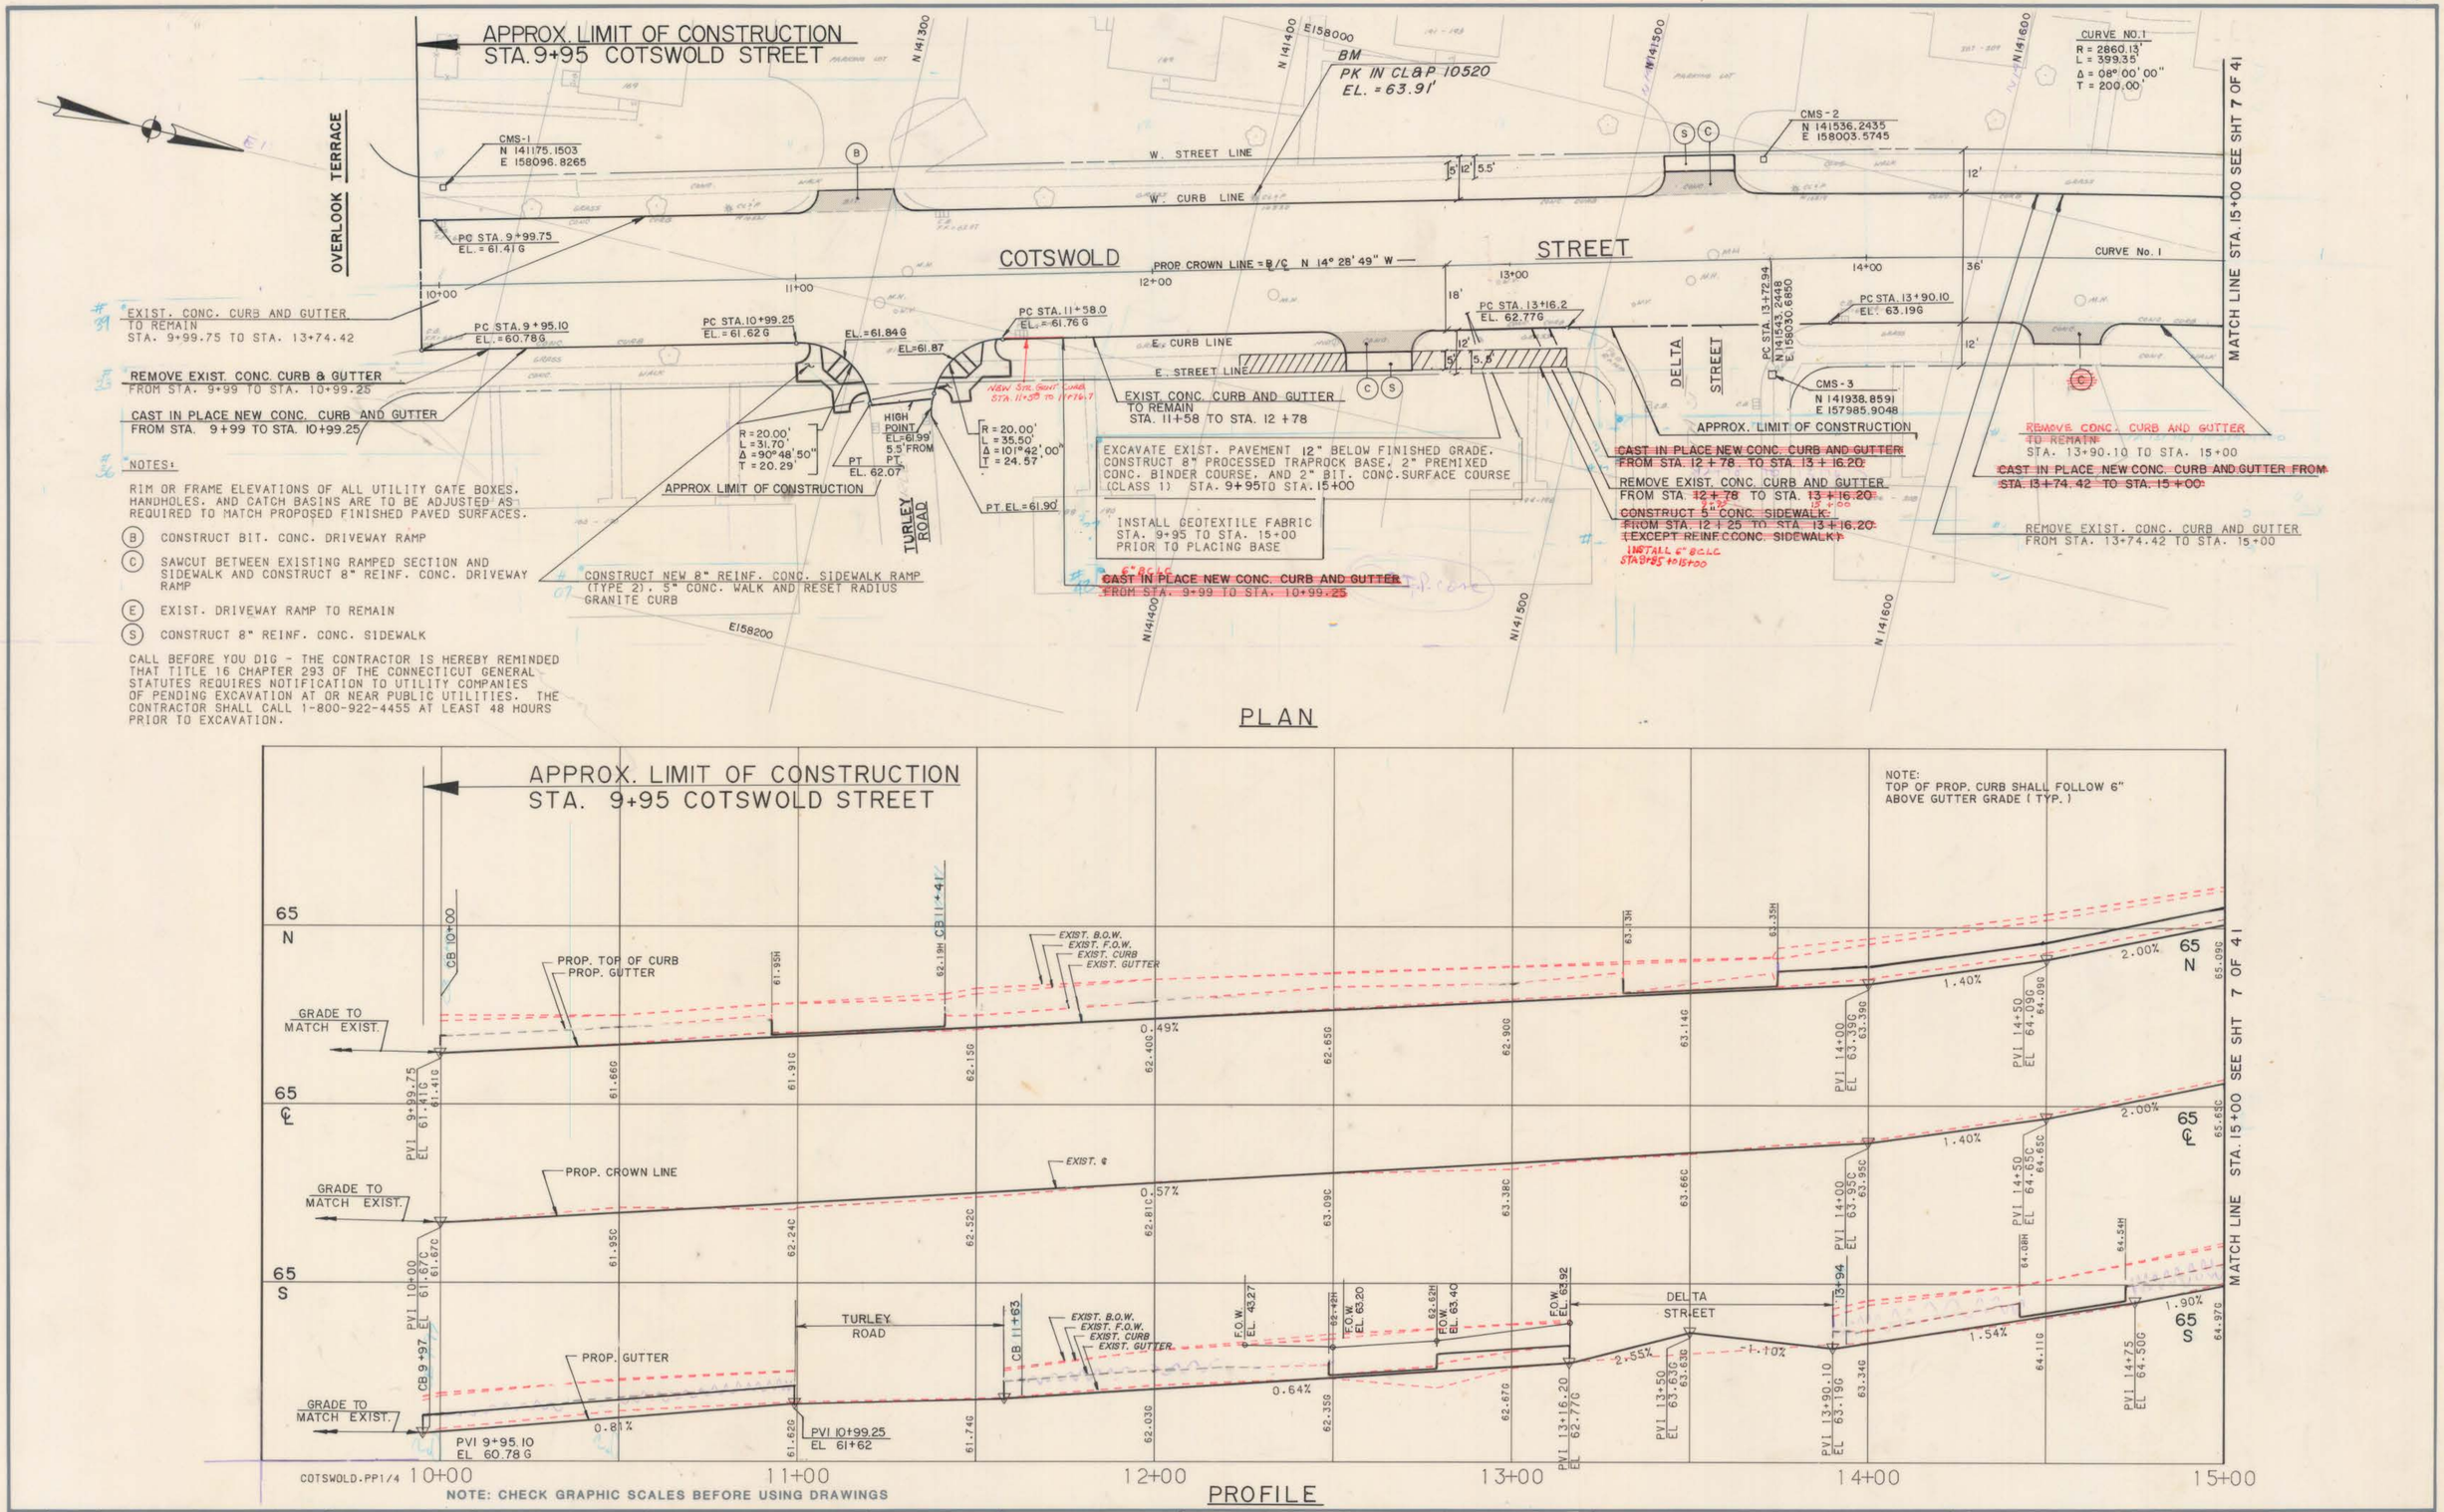

COTSWOLD-PP1/4

NOTE: CHECK GRAPHIC SCALES BEFORE USING DRAWINGS

NO.	DATE	DESCRIPTION
		REVISIONS

SUPV.	JAC
DESIGN	MDH/AEC
DRAWN	MJN
CHECKED	AEC
DATE	02·12·86

GRAPHIC SCALES
HORIZ. 1" = 20'
VERT. 1" = 2'

ROADWAY RECONSTRUCTION
HARTFORD, CONNECTICUT

STATE OF CONNECTICUT ALAN R. WENDT REGISTERED PROFESSIONAL ENGINEER NO. 10606

Hayden | Wegman
Consulting Engineers
WEST HARTFORD
NEW YORK • BOSTON • BUFFALO
ATLANTA • MEMPHIS

CITY OF HARTFORD, CONNECTICUT
DEPARTMENT OF PUBLIC WORKS
BUREAU OF ENGINEERING SERVICES

DAYBOOK NO. 011005
DATE

COTSWOLD STREET
STA. 9+95 TO STA. 15+00

PLAN AND PROFILE
Contract No. E86-2 Job No.- 852534

SHEET 7 OF 41