



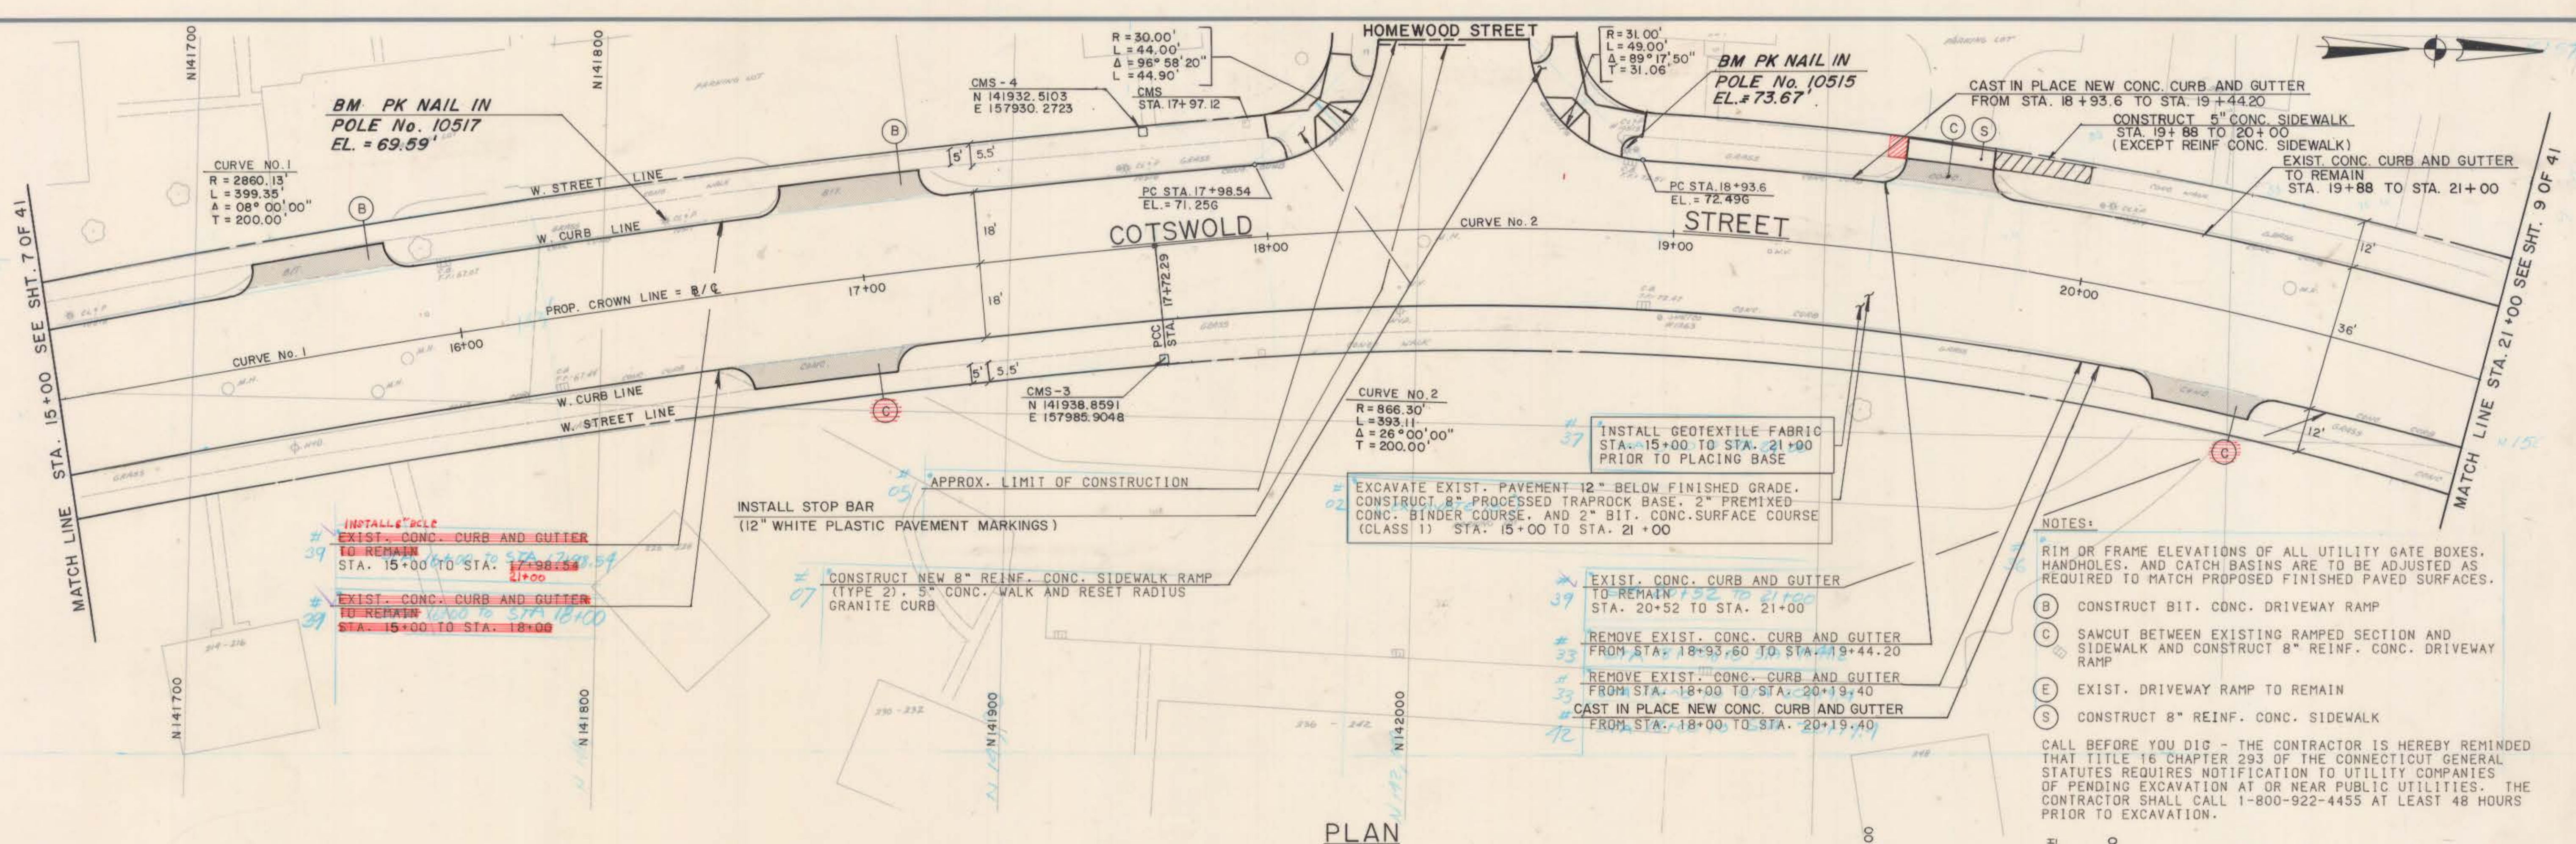

PLAN

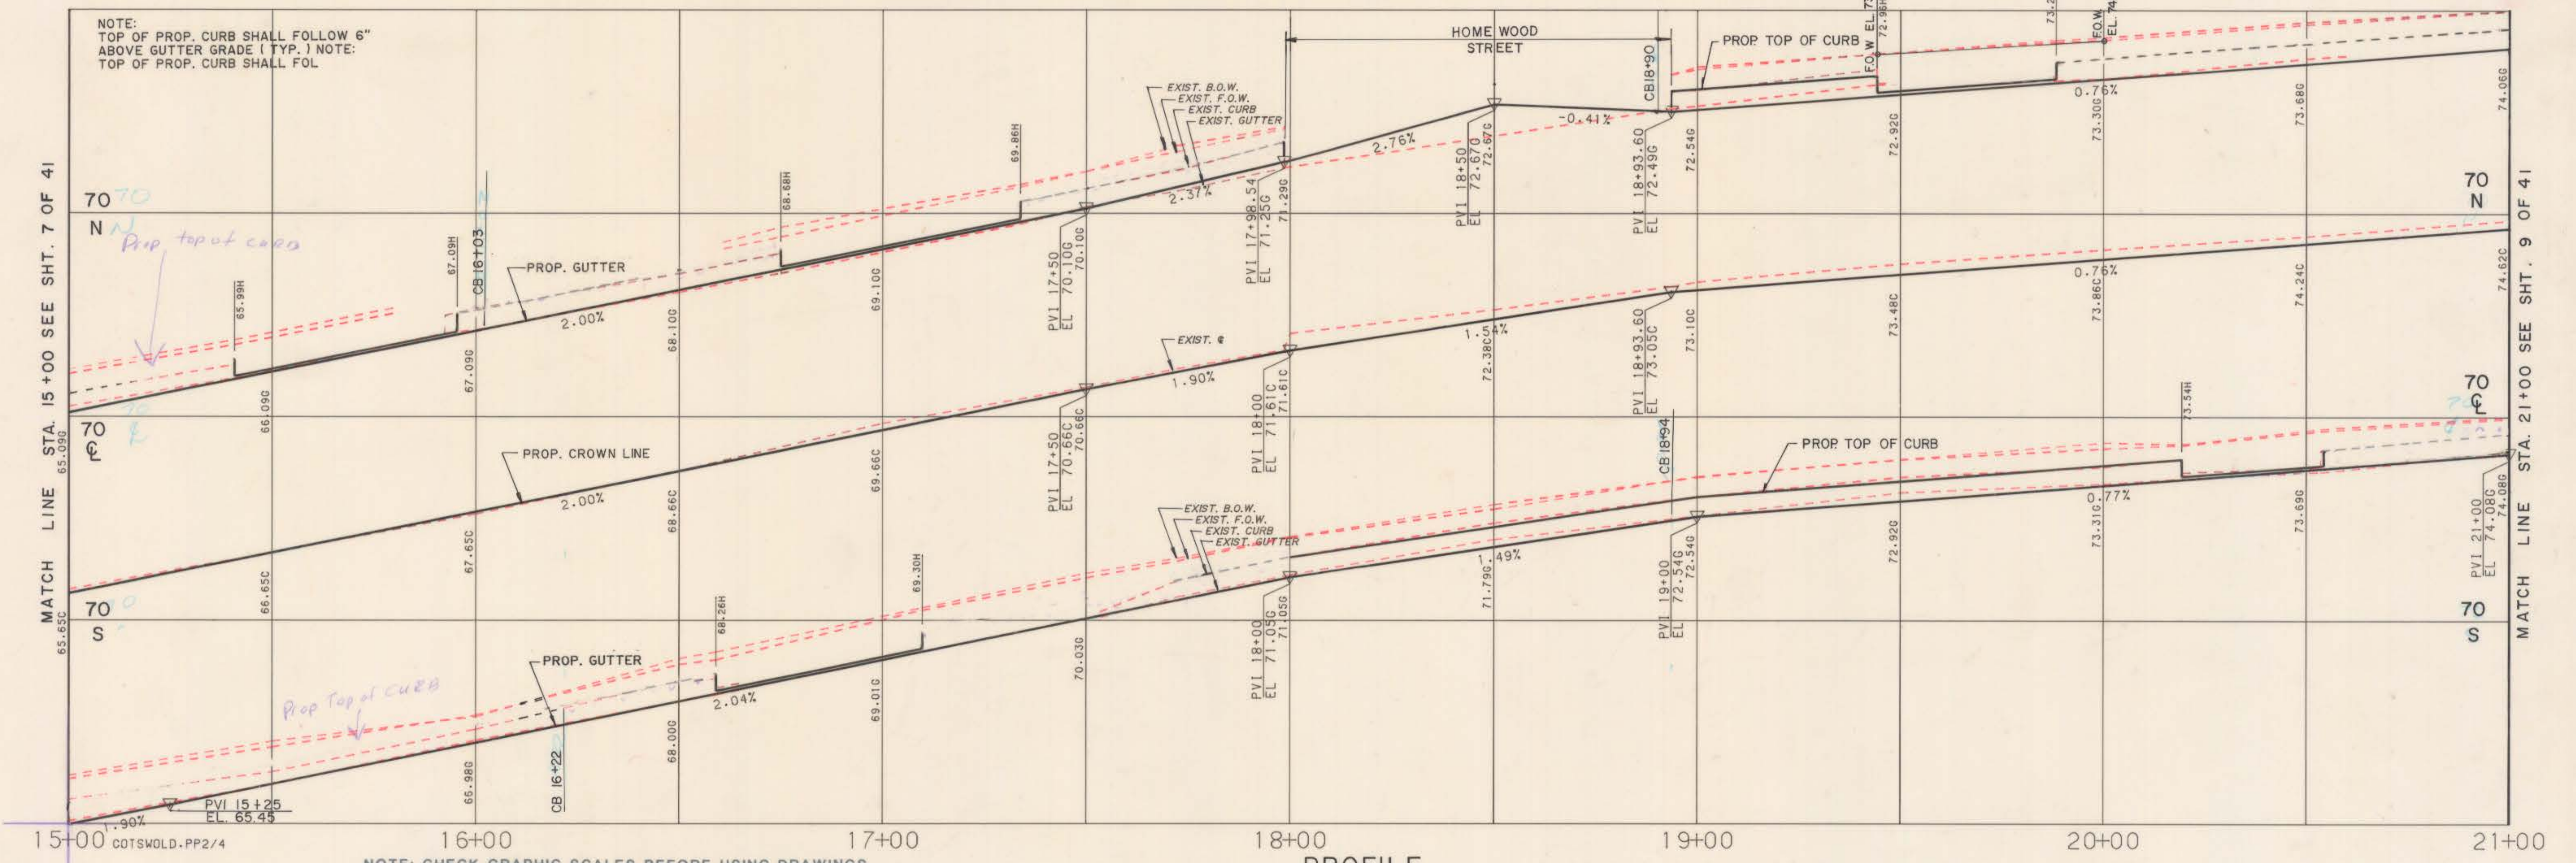

PROFILE

SUPV. JAC DESIGN MDH/AEC DRAWN M J N CHECKED AEC DATE 02.12.86		GRAPHIC SCALES HORIZ. 1"=20' VERT. 1"=2'	ROADWAY RECONSTRUCTION HARTFORD, CONNECTICUT		Hayden Wegman Consulting Engineers WEST HARTFORD NEW YORK • BOSTON • BUFFALO ATLANTA • MEMPHIS	CITY OF HARTFORD, CONNECTICUT DEPARTMENT OF PUBLIC WORKS BUREAU OF ENGINEERING SERVICES DAYBOOK NO. 011005 DATE	COTSWOLD STREET STA. 15+00 TO STA. 21+00 PLAN AND PROFILE Contract No. E86-2 Job No. 852534	SHEET 8 OF 41
--	--	--	---	--	---	---	--	------------------

513/R

513/R