


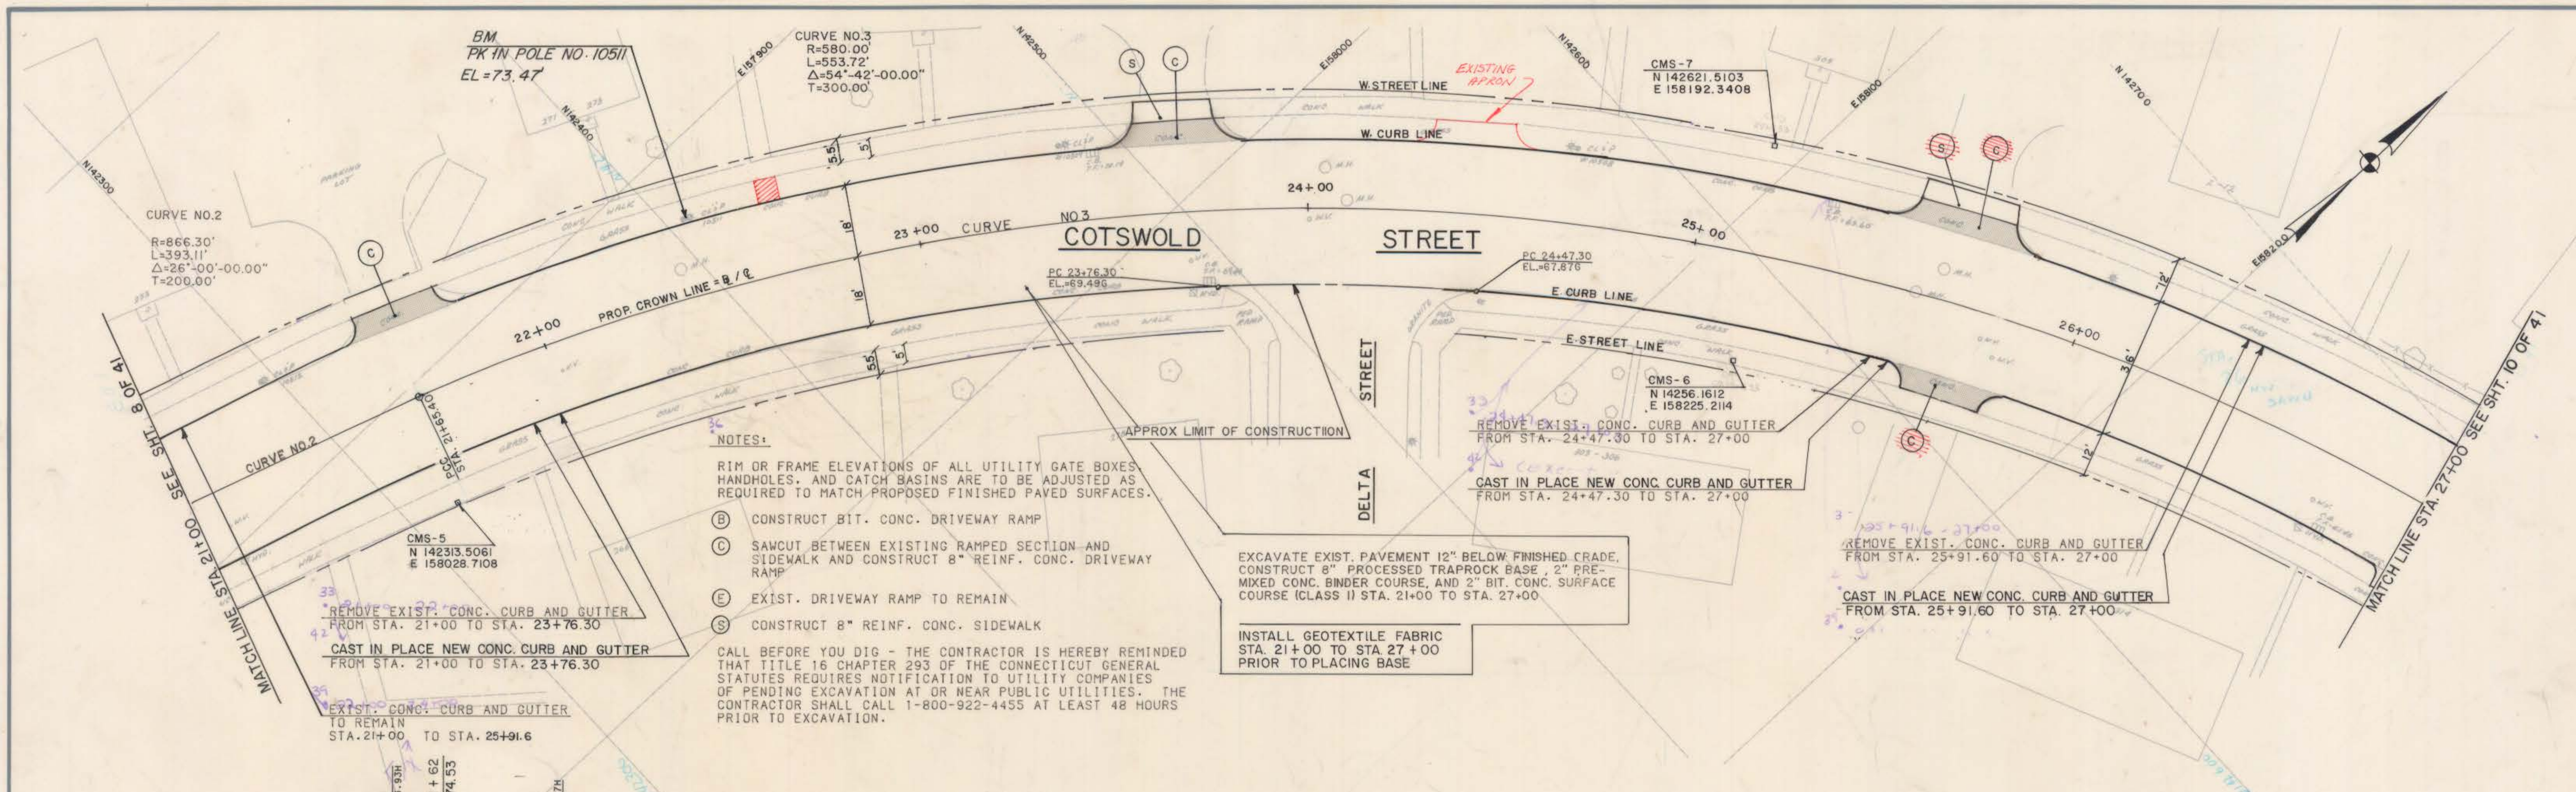

NOTES:

(B) CONSTRUCT BIT. CONC. DRIVEWAY RAMP

(C) SAWCUT BETWEEN EXISTING RAMPED SECTION AND SIDEWALK AND CONSTRUCT 8\" REINF. CONC. DRIVEWAY RAMP


(E) EXIST. DRIVEWAY RAMP TO REMAIN

(S) CONSTRUCT 8\" REINF. CONC. SIDEWALK

CALL BEFORE YOU DIG - THE CONTRACTOR IS HEREBY REMINDED THAT TITLE 16 CHAPTER 293 OF THE CONNECTICUT GENERAL STATUTES REQUIRES NOTIFICATION TO UTILITY COMPANIES OF PENDING EXCAVATION AT OR NEAR PUBLIC UTILITIES. THE CONTRACTOR SHALL CALL 1-800-922-4455 AT LEAST 48 HOURS PRIOR TO EXCAVATION.

EXCAVATE EXIST. PAVEMENT 12\" BELOW FINISHED GRADE, CONSTRUCT 8\" PROCESSED TRAPROCK BASE, 2\" PRE-MIXED CONC. BINDER COURSE, AND 2\" BIT. CONC. SURFACE COURSE (CLASS II) STA. 21+00 TO STA. 27+00

INSTALL GEOTEXTILE FABRIC STA. 21+00 TO STA. 27+00 PRIOR TO PLACING BASE

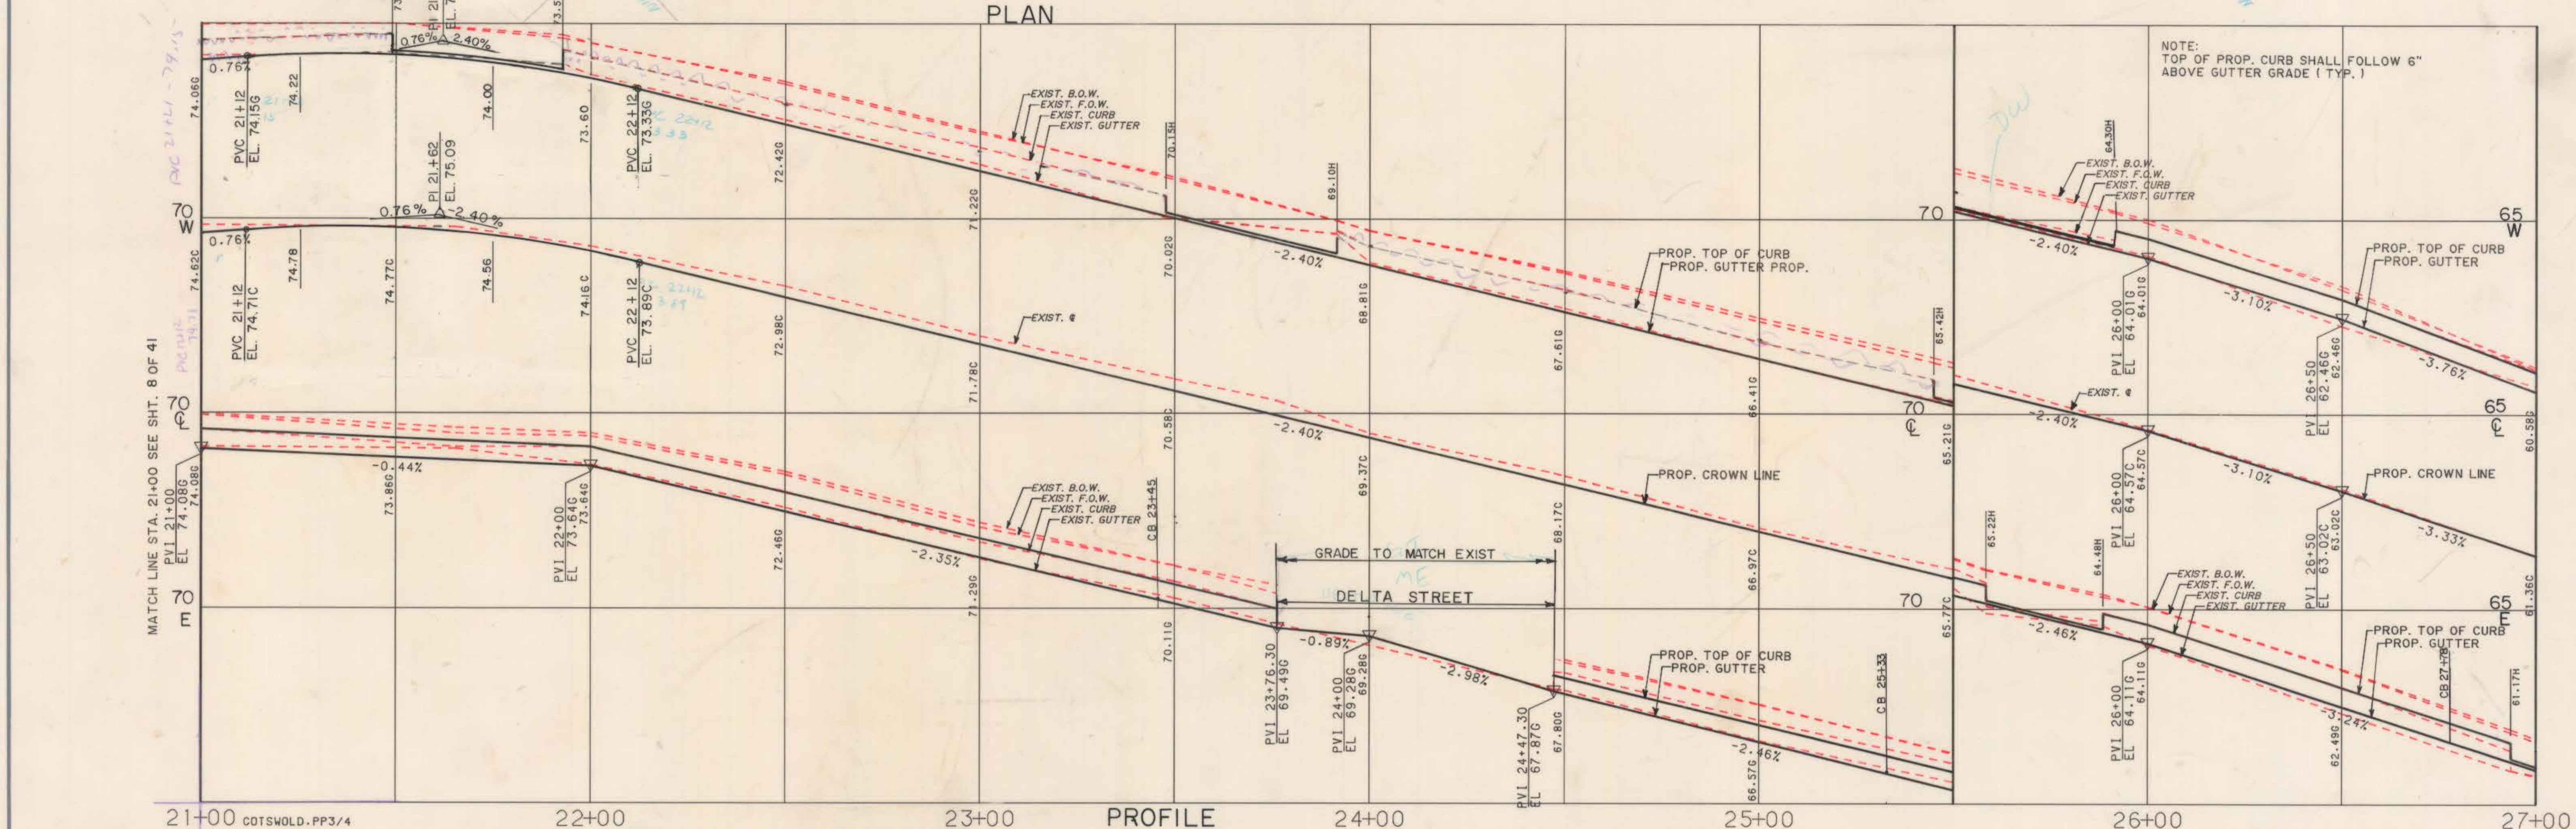

NO. DATE DESCRIPTION REVISIONS		SUPV. JAC DESIGN MDH/AEC DRAWN [Signature] CHECKED AEC DATE 02.12.86	GRAPHIC SCALES HORIZ. 1"=20' VERT. 1"=2'	ROADWAY RECONSTRUCTION HARTFORD, CONNECTICUT		Hayden Wegman Consulting Engineers WEST HARTFORD NEW YORK • BOSTON • BUFFALO ATLANTA • MEMPHIS	CITY OF HARTFORD, CONNECTICUT DEPARTMENT OF PUBLIC WORKS BUREAU OF ENGINEERING SERVICES DAYBOOK NO. 011005 DATE	COTSWOLD STREET STA 21+00 TO STA 27+00 PLAN AND PROFILE Job No. - 852534	SHEET 9 OF 41
--------------------------------	--	--	--	---	--	--	---	---	------------------