
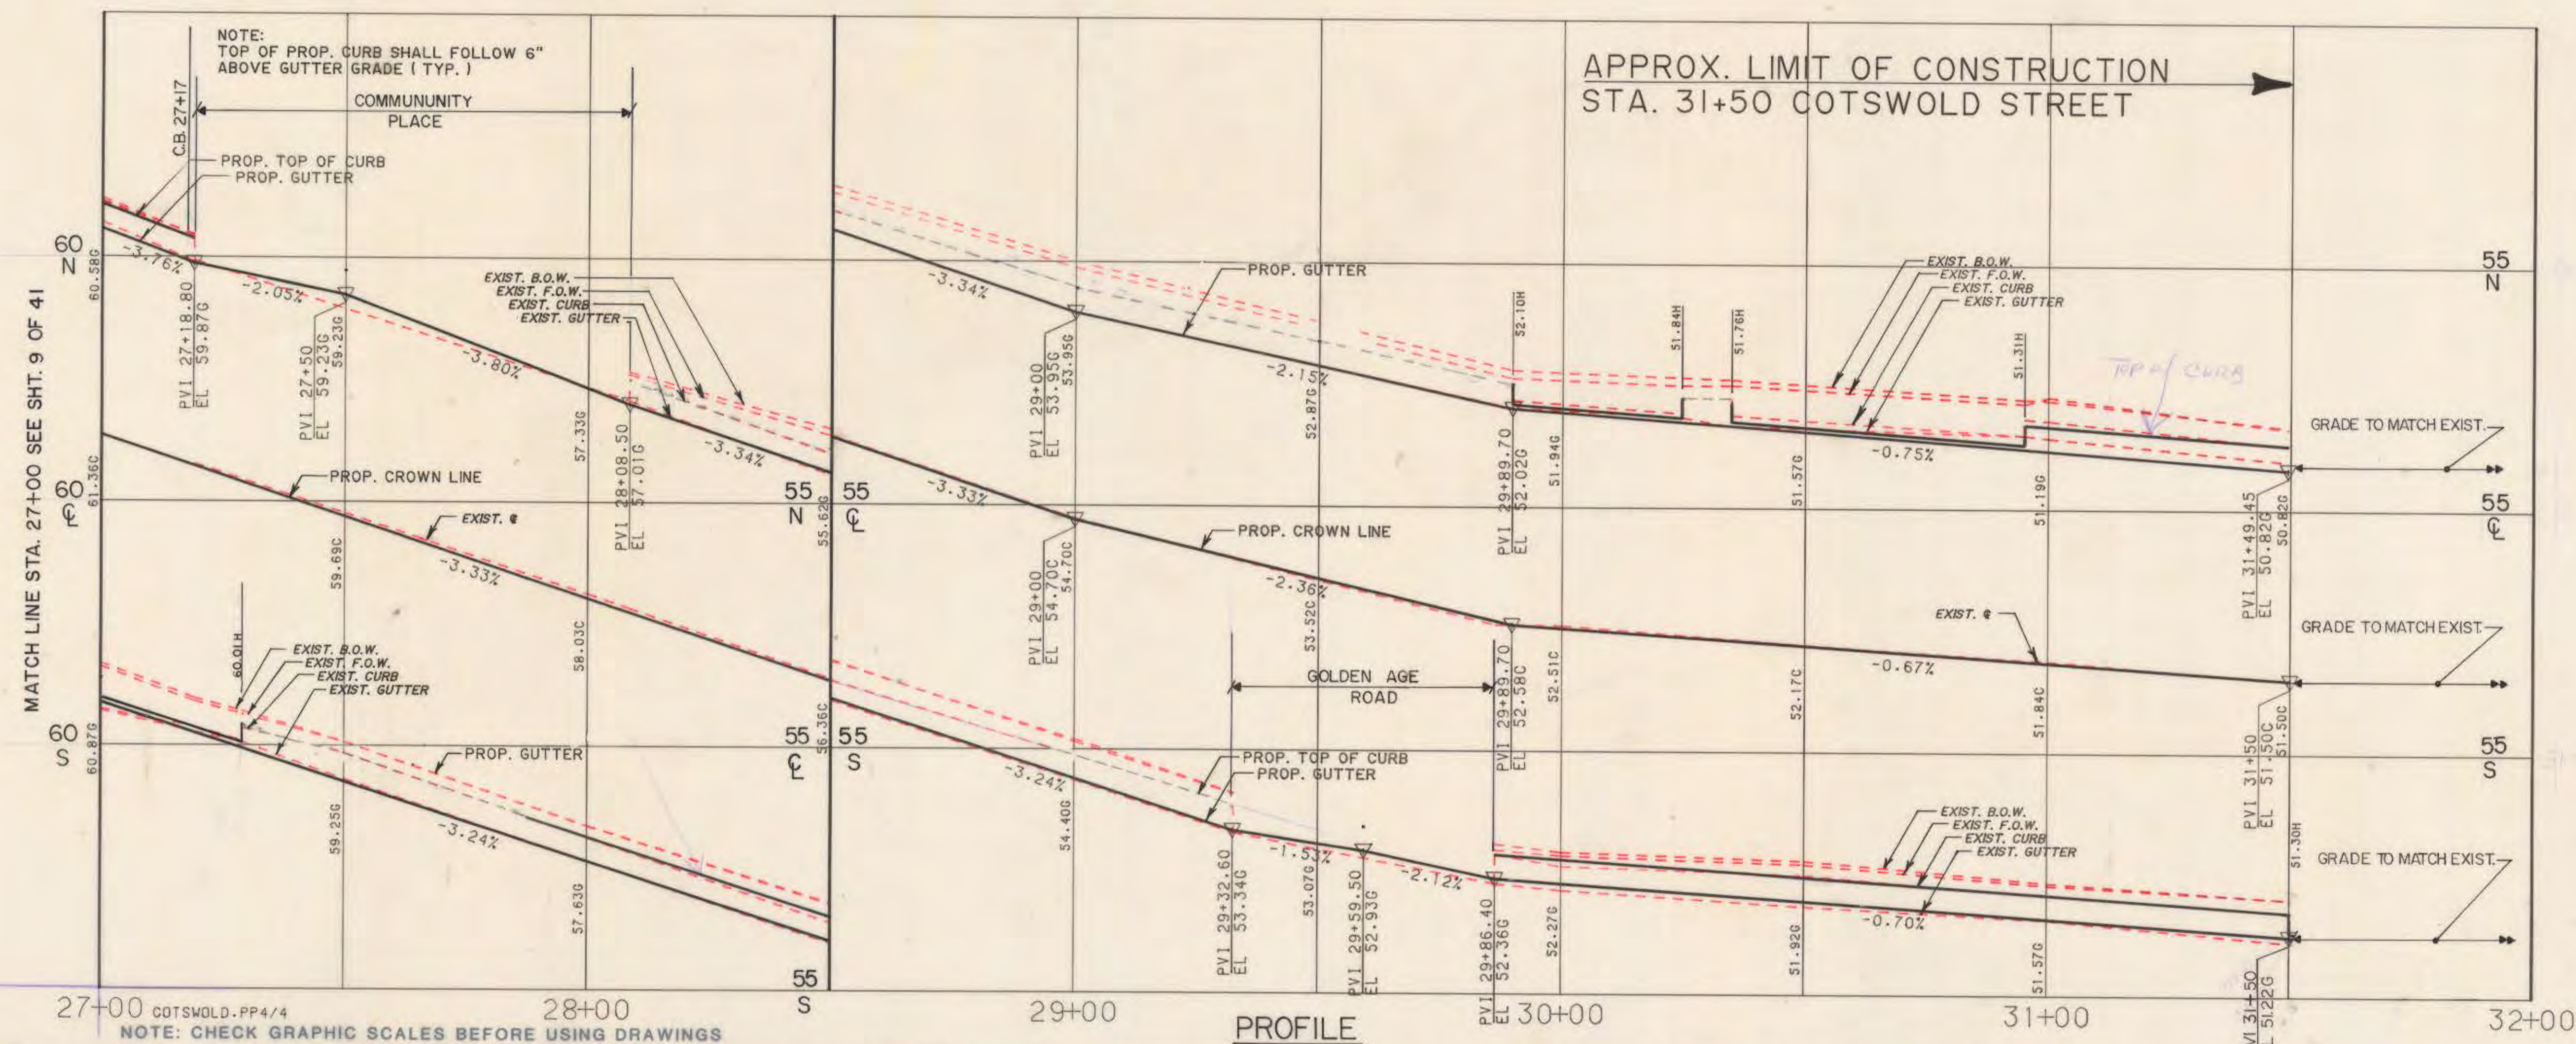


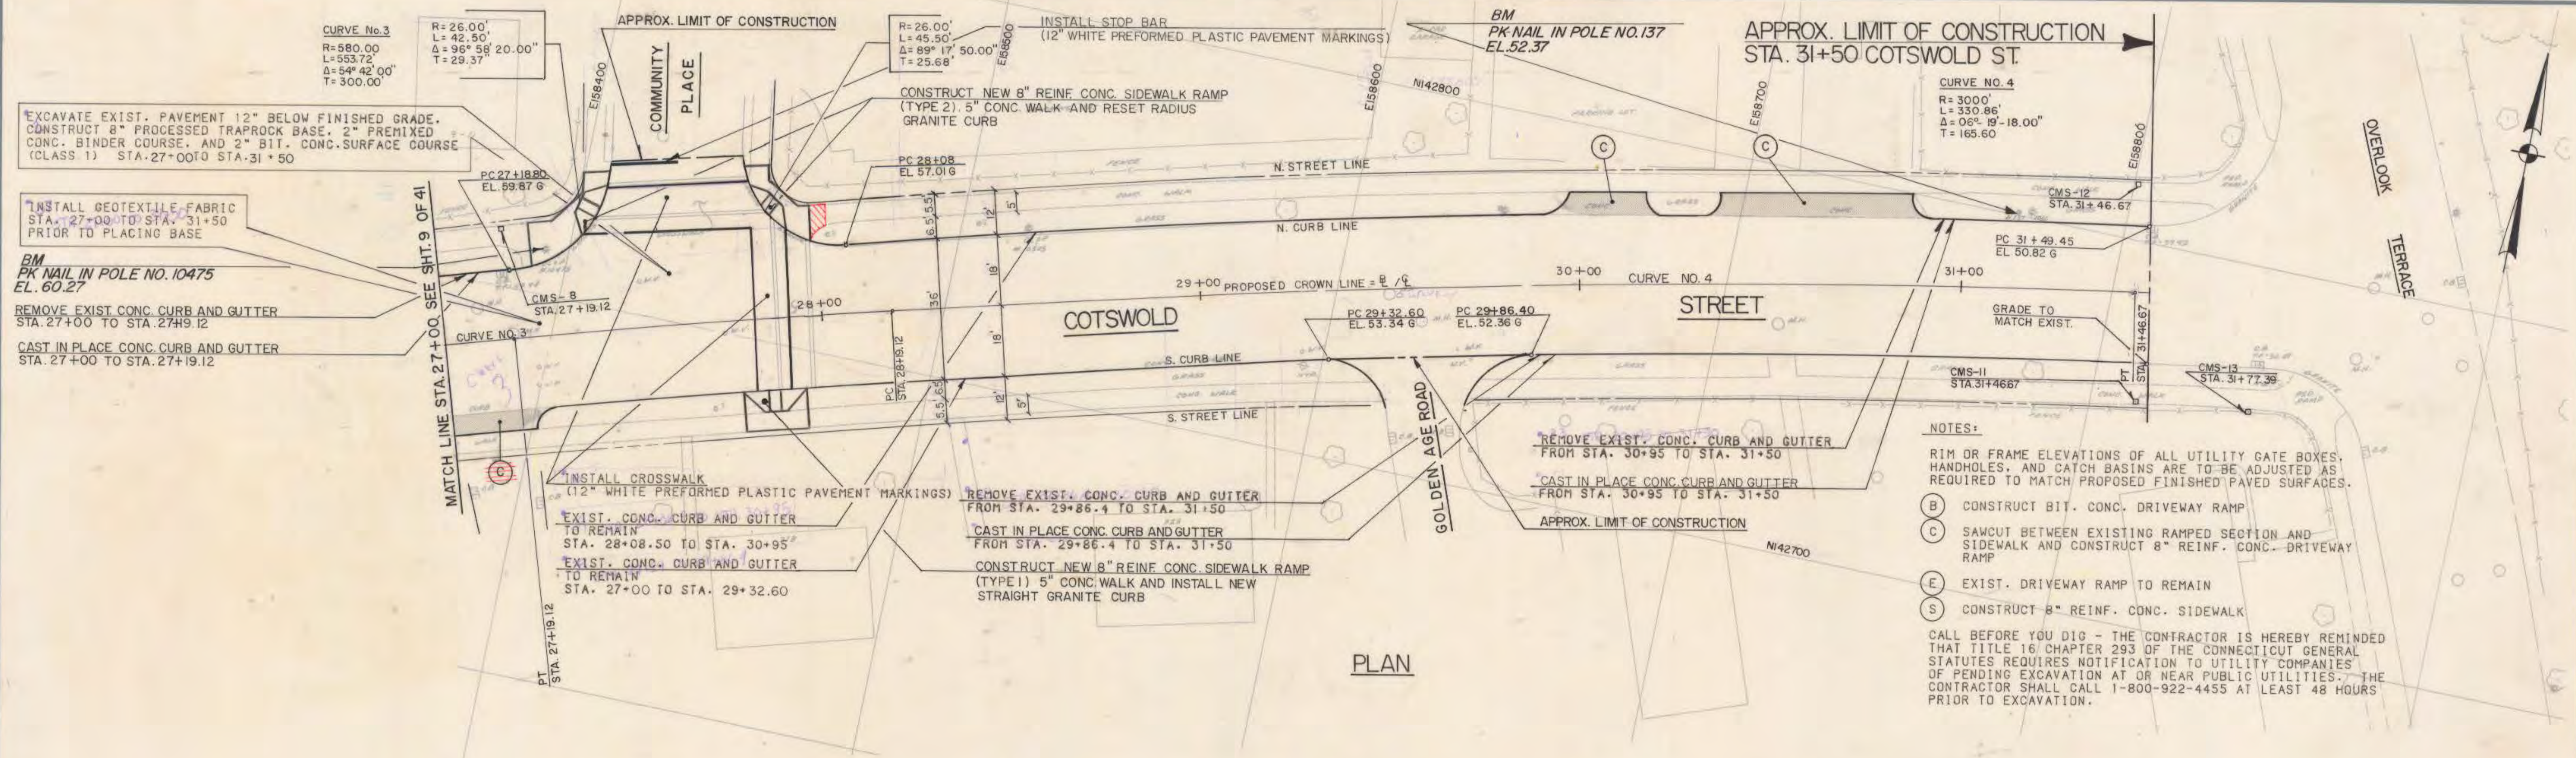

NO. DATE DESCRIPTION		REVISIONS		SHEET 10 OF 41	
SUPV. JAC		DESIGN MDH/AEC		DRAWN DAF	
CHECKED AEC		DATE 02-10-86		CONTRACT NO. E86-2	
GRAPHIC SCALES		HORIZ. 1"=20'		VERT. 1"=2'	
ROADWAY RECONSTRUCTION		HARTFORD, CONNECTICUT		CITY OF HARTFORD, CONNECTICUT	
DEPARTMENT OF PUBLIC WORKS		BUREAU OF ENGINEERING SERVICES		COTSWOLD STREET	
STA. 27+00 TO STA. 31+50		PLAN AND PROFILE		JOB NO. 852534	
DAYBOOK NO. 011005		DATE		CONTRACT NO. E86-2	
WEST HARTFORD		NEW YORK • BOSTON • BUFFALO		ATLANTA • MEMPHIS	
Hayden Wegman		Consulting Engineers		CITY OF HARTFORD, CONNECTICUT	
