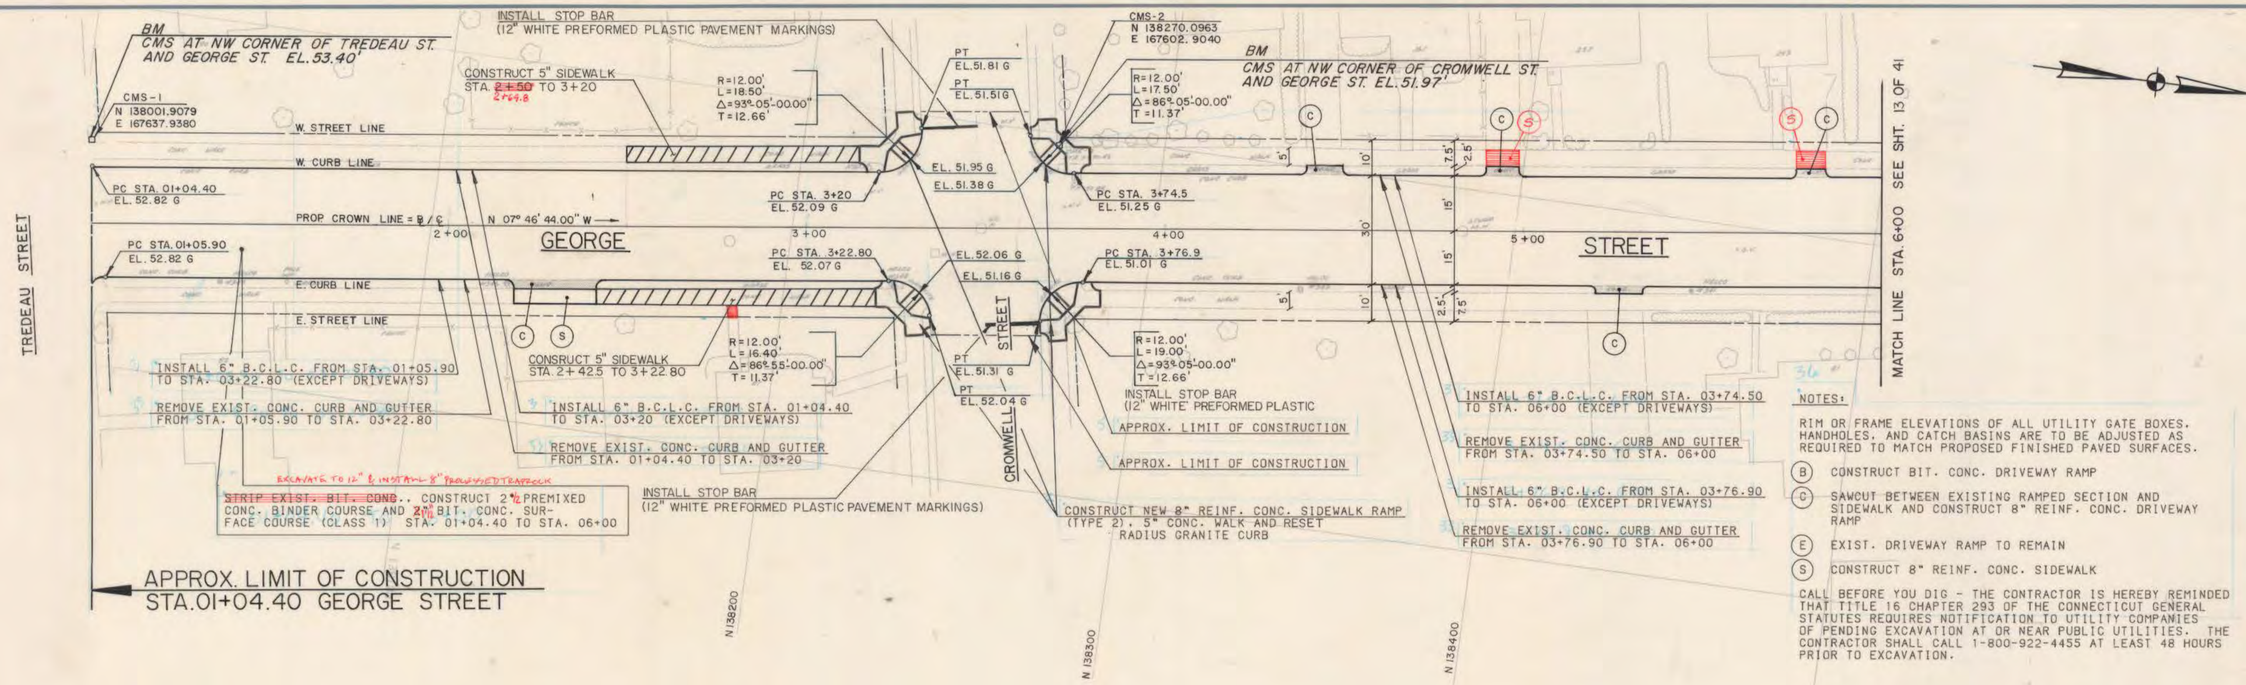

PLAN

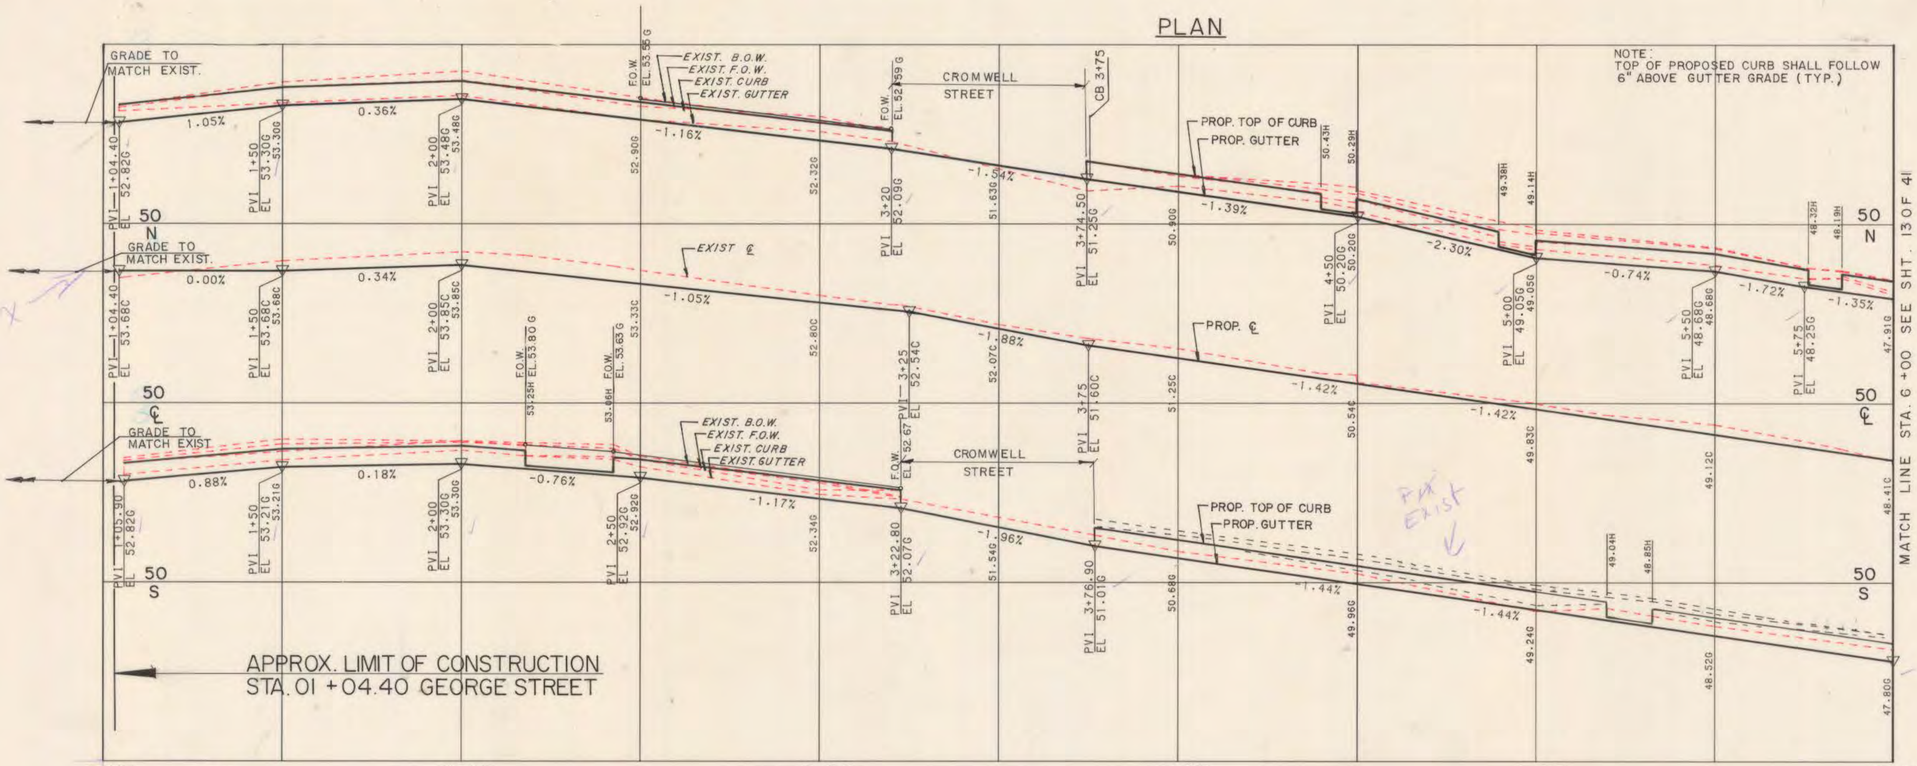

GEORGE.PP1/4

NOTE: CHECK GRAPHIC SCALES BEFORE USING DRAWINGS

PROFILE

NO.	DATE	DESCRIPTION
	NOV 86	AS BUILT BY RJE CHECKED BY MCC

REVISIONS

SUPV.	JAC
DESIGN	MDH/AEC
DRAWN	JRM
CHECKED	AEC
DATE	02·12·86

GRAPHIC SCALES
HORIZ. 1"=20'
VERT. 1"=2'

ROADWAY RECONSTRUCTION
HARTFORD, CONNECTICUT

STATE OF CONNECTICUT · JOHN R. RIZZO · NO. 10606 · REGISTERED PROFESSIONAL ENGINEER

Hayden | Wegman
Consulting Engineers
WEST HARTFORD
NEW YORK • BOSTON • BUFFALO
ATLANTA • MEMPHIS

CITY OF HARTFORD, CONNECTICUT
DEPARTMENT OF PUBLIC WORKS
BUREAU OF ENGINEERING SERVICES

DAYBOOK NO. 011005
DATE

GEORGE STREET
STA. 01+04.40 TO STA. 6+00

PLAN AND PROFILE
CONTRACT NO. E86-2 Job No.- 85253

SHEET 12 OF 41